


FINAL SURVEY	SURVEYED.	BY	DATE
	PLOTTED		
NOTE BOOK	TEMPLATE		
	AREAS		
NO.	AREAS CHECKED		

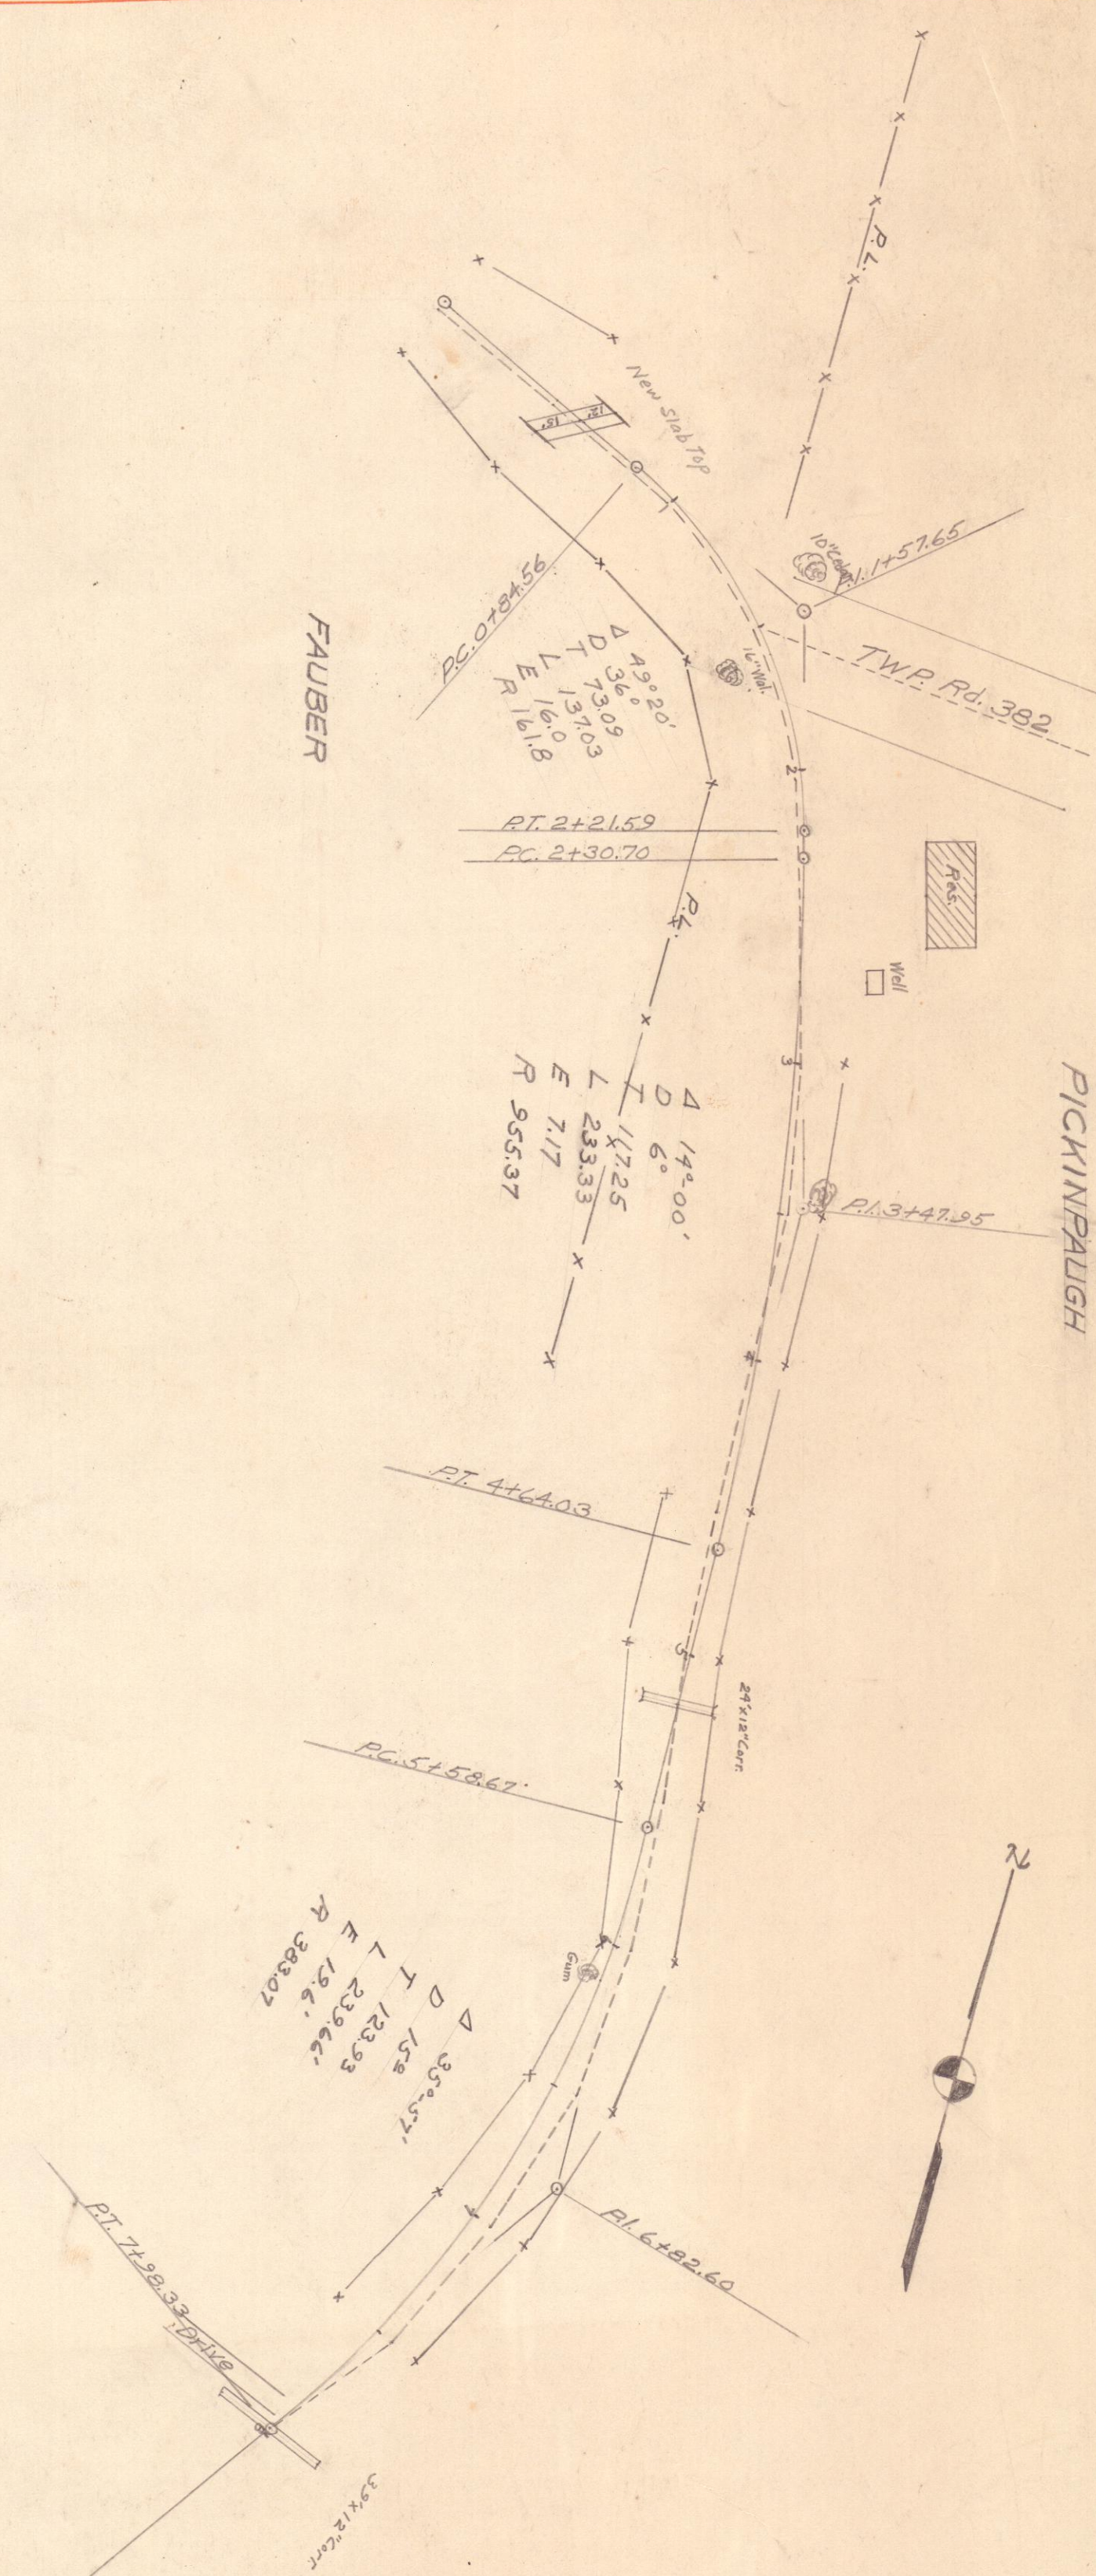

MUSKINGUM COUNTY-ENG. DEPT.
C-45 SALT CREEK TWP.

D-145

ON 100% RAG STOCK MADE IN U. S. A.