


Seeding
End Sq.
Width Yds

End Area Volume
Cut Fill Cut Fill

MUSKINGUM COUNTY
TOWNSHIP ROADS NO. 47 & 60

22
26

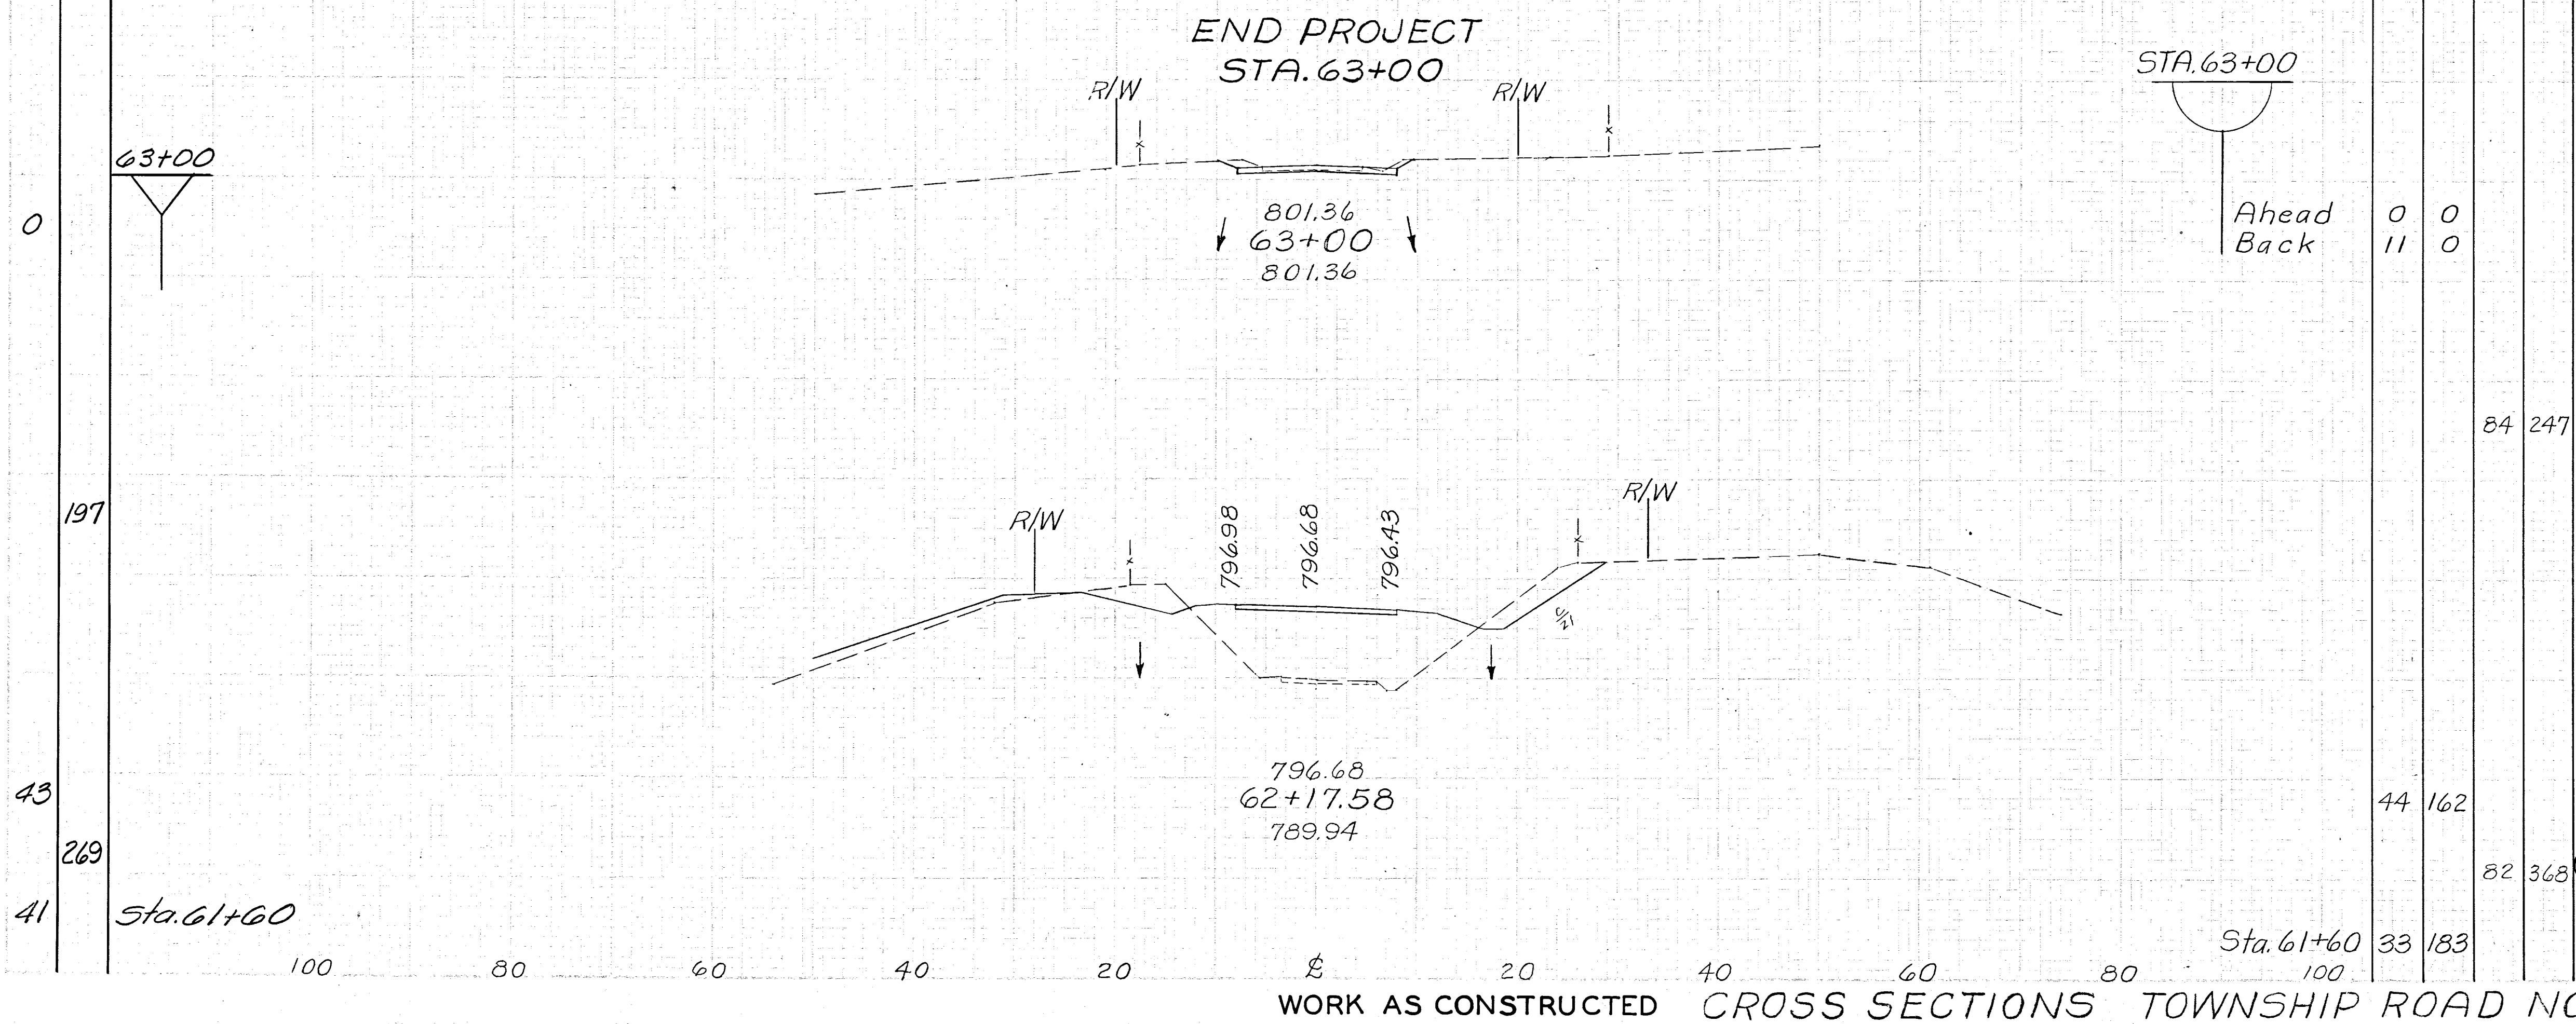

REVISION	DATE	DESCRIPTION	BY

U. S. ARMY ENGINEER DISTRICT, HUNTINGTON
CORPS OF ENGINEERS
HUNTINGTON, W. VA.

DRAWN BY:
TRACED BY:
CHECKED BY: *SEW*
SUBMITTED BY: *Elmer S. Barrett*
ELMER S. BARRETT ASSOCIATES
RECOMMENDED BY: *James G. Barrett*
CHIEF ENG. DIV.

APPROVED: *A. J. [Signature]*
COL. C. E. DISTRICT ENGINEER

DATE: AUGUST 1959

ELMER S. BARRETT ASSOCIATES
CONSULTING ENGINEERS
CHILLICOTHE, OHIO

SCALE: 1" = 10'
SPEC. NO.
DRAWING NUMBER
0271-UD10-68/22
SHEET 22 OF 26