


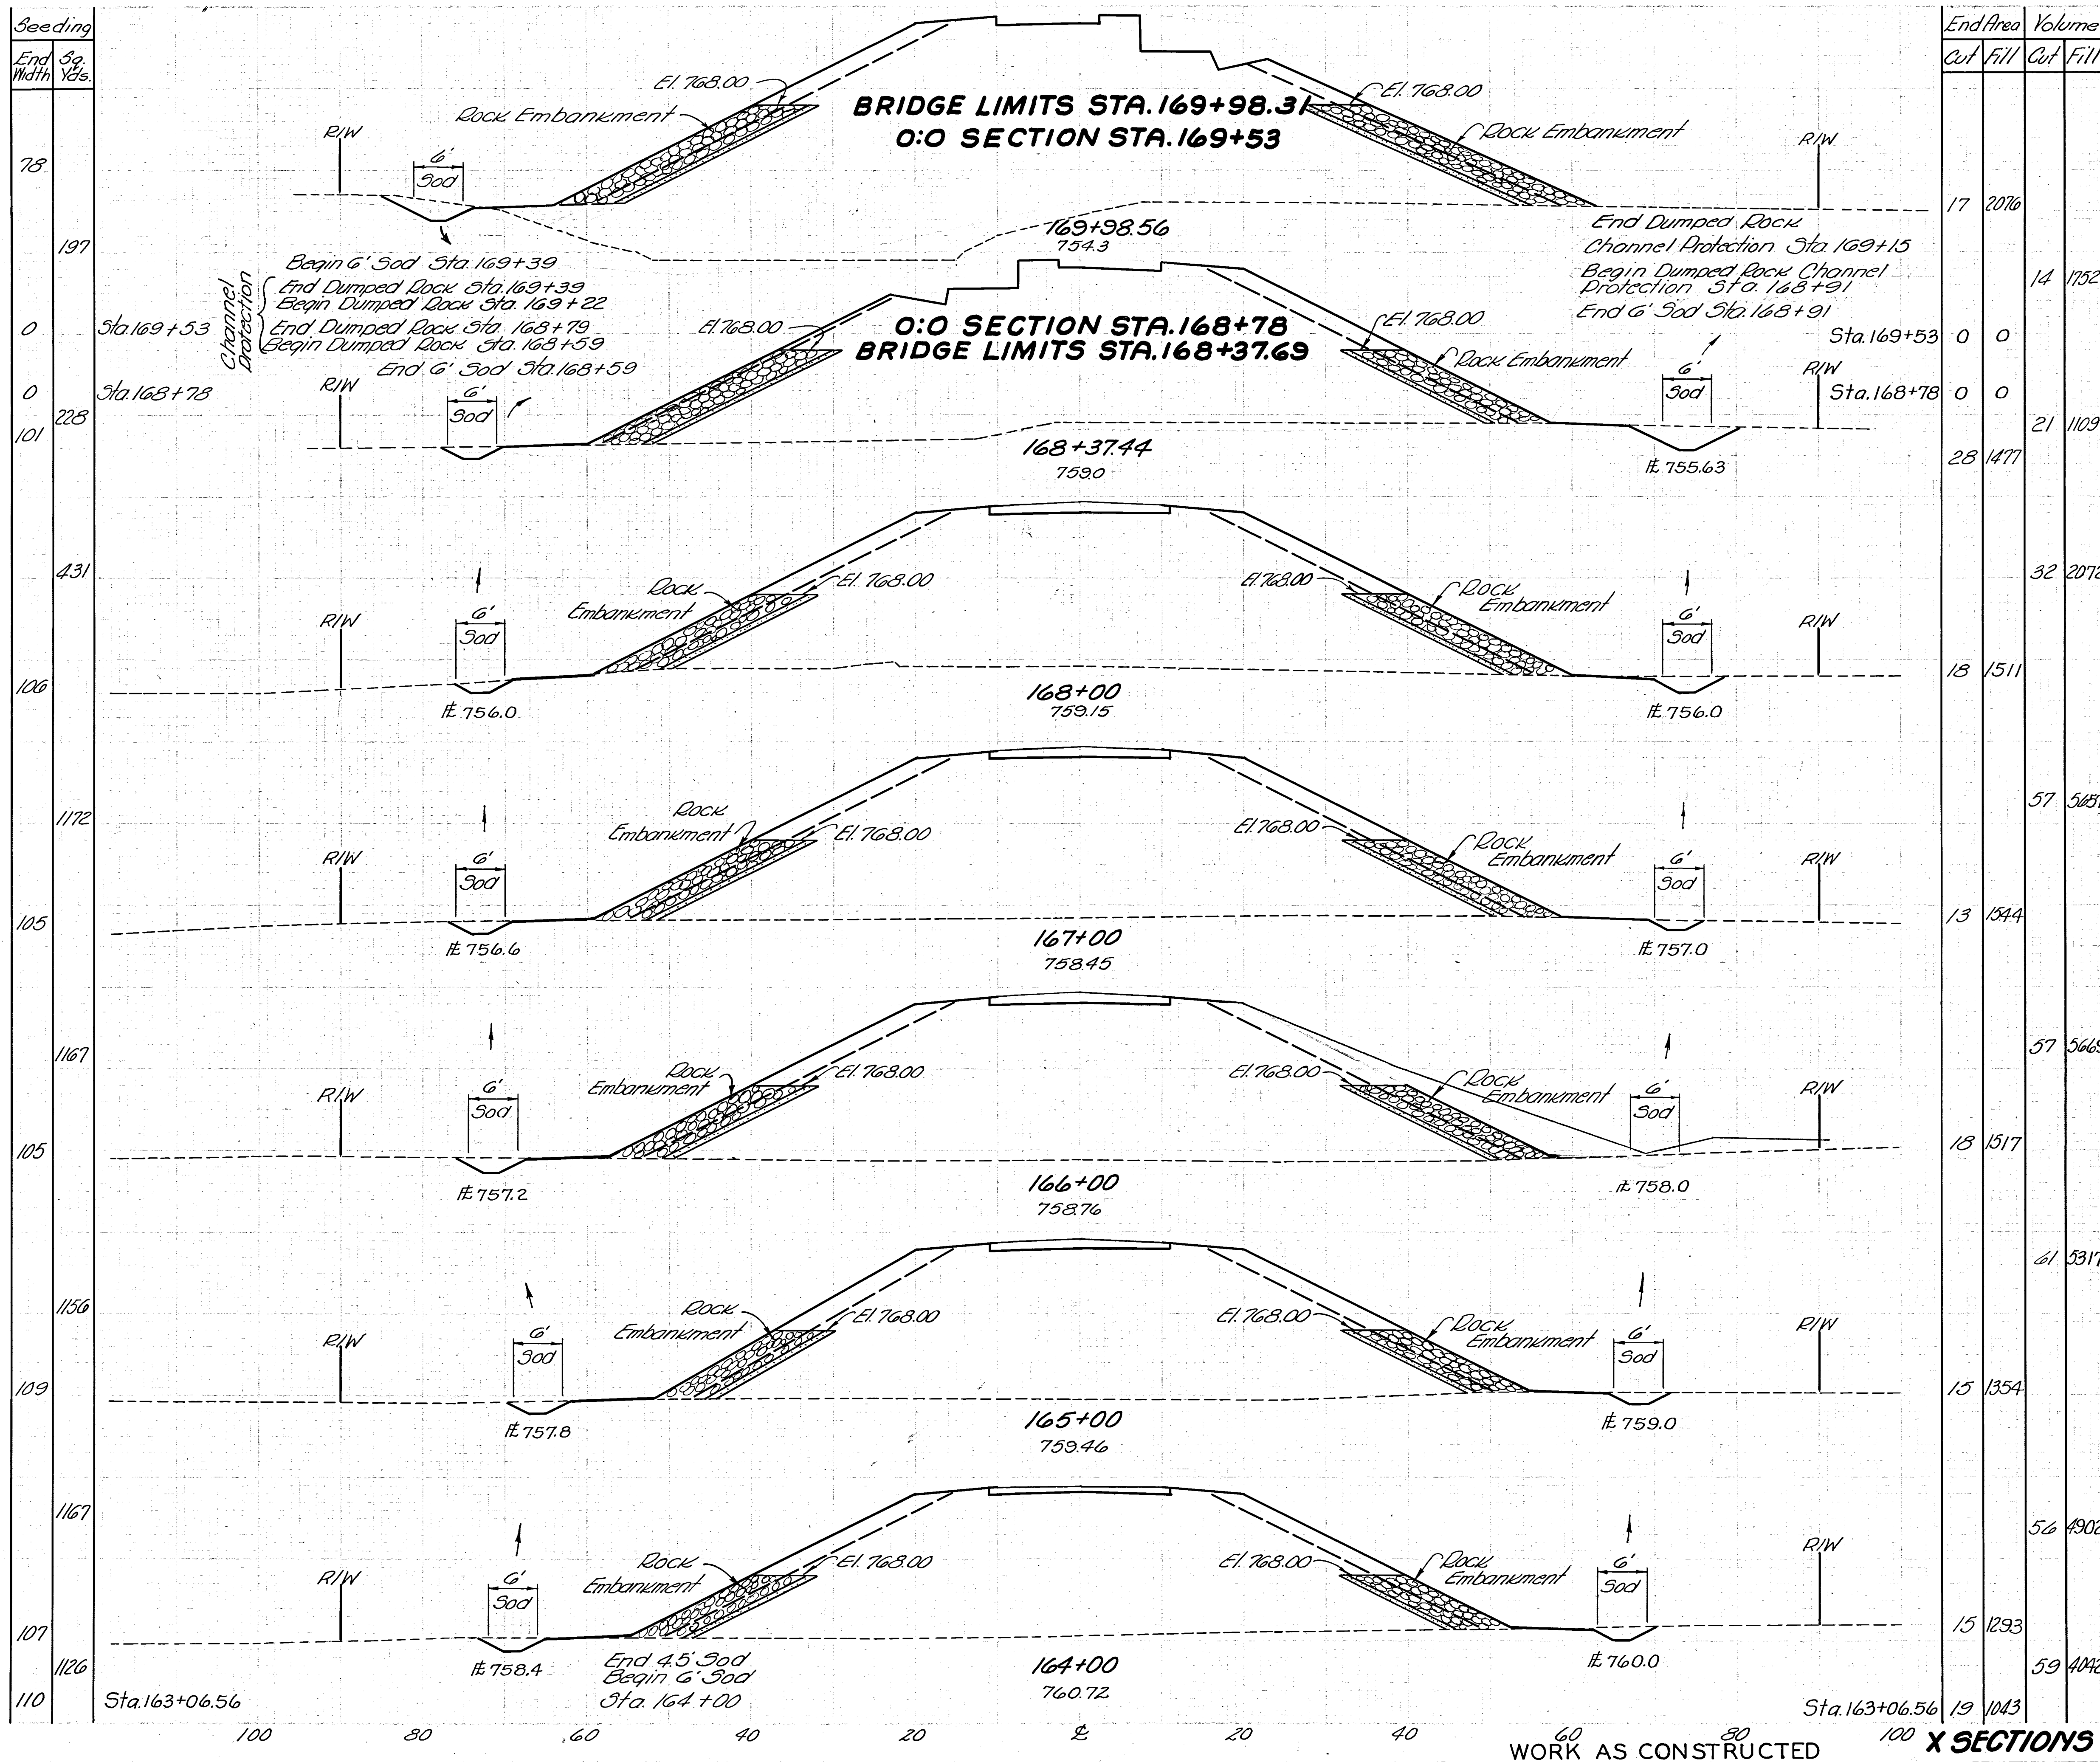

End Area		Volume	
Cut	Fill	Cut	Fill
17	2076		
	14	1752	
0	0		
0	0		
21	1109		
28	1477		
	32	2072	
18	1511		
	57	5257	
13	1544		
	57	5669	
18	1517		
	61	5317	
15	1354		
	56	4902	
15	1293		
	59	4042	
19	1043		

MUSKINGUM COUNTY MUS-156-2.85

PARTICIPATION BY THE UNITED STATES OF AMERICA

Stations	Earthwork		Sand	
	End Area		End Area	
	Cut	Fill	Cut	Fill
Sta. 169+98.56	17	1894	29	24
Sta. 169+53	0	0	0	0
Sta. 168+78	0	0	0	17
Sta. 168+37.44	28	1402	23	
		32	1922	31
Sta. 168+00	18	1370	21	
		57	5133	78
Sta. 167+00	13	1402	21	
		57	5139	70
Sta. 166+00	18	1373	20	
		61	4787	69
Sta. 165+00	15	1212	17	
		56	4396	61
Sta. 164+00	15	1162	16	
		59	3637	66
Sta. 163+06.56	19	940	22	

REVISION	DATE	DESCRIPTION	BY
U. S. ARMY ENGINEER DISTRICT, HUNTINGTON CORPS OF ENGINEERS HUNTINGTON, W. VA.			
DRAWN BY: <i>EEB</i>	LICKING RIVER DILLON RESERVOIR PROJECT RELOCATION OF OHIO STATE ROUTE NO. 156 (Section 3 & 4)		
TRACED BY:	APPROVED: <i>[Signature]</i> DATE: JULY 1959		
CHECKED BY: <i>[Signature]</i>	ELMER S. BARRETT ASSOCIATES CONSULTING ENGINEERS CHILLICOTHE, OHIO		
SUBMITTED BY: <i>[Signature]</i>	SCALE: 1" = 10' - 0"		
RECOMMENDED BY: <i>[Signature]</i>	DRAWING NUMBER 027f-UD6-68/29		
CHIEF ENG. DIV.	SHEET 29 OF 62		

X SECTIONS - STA. 164+00 TO STA. 169+98.51