


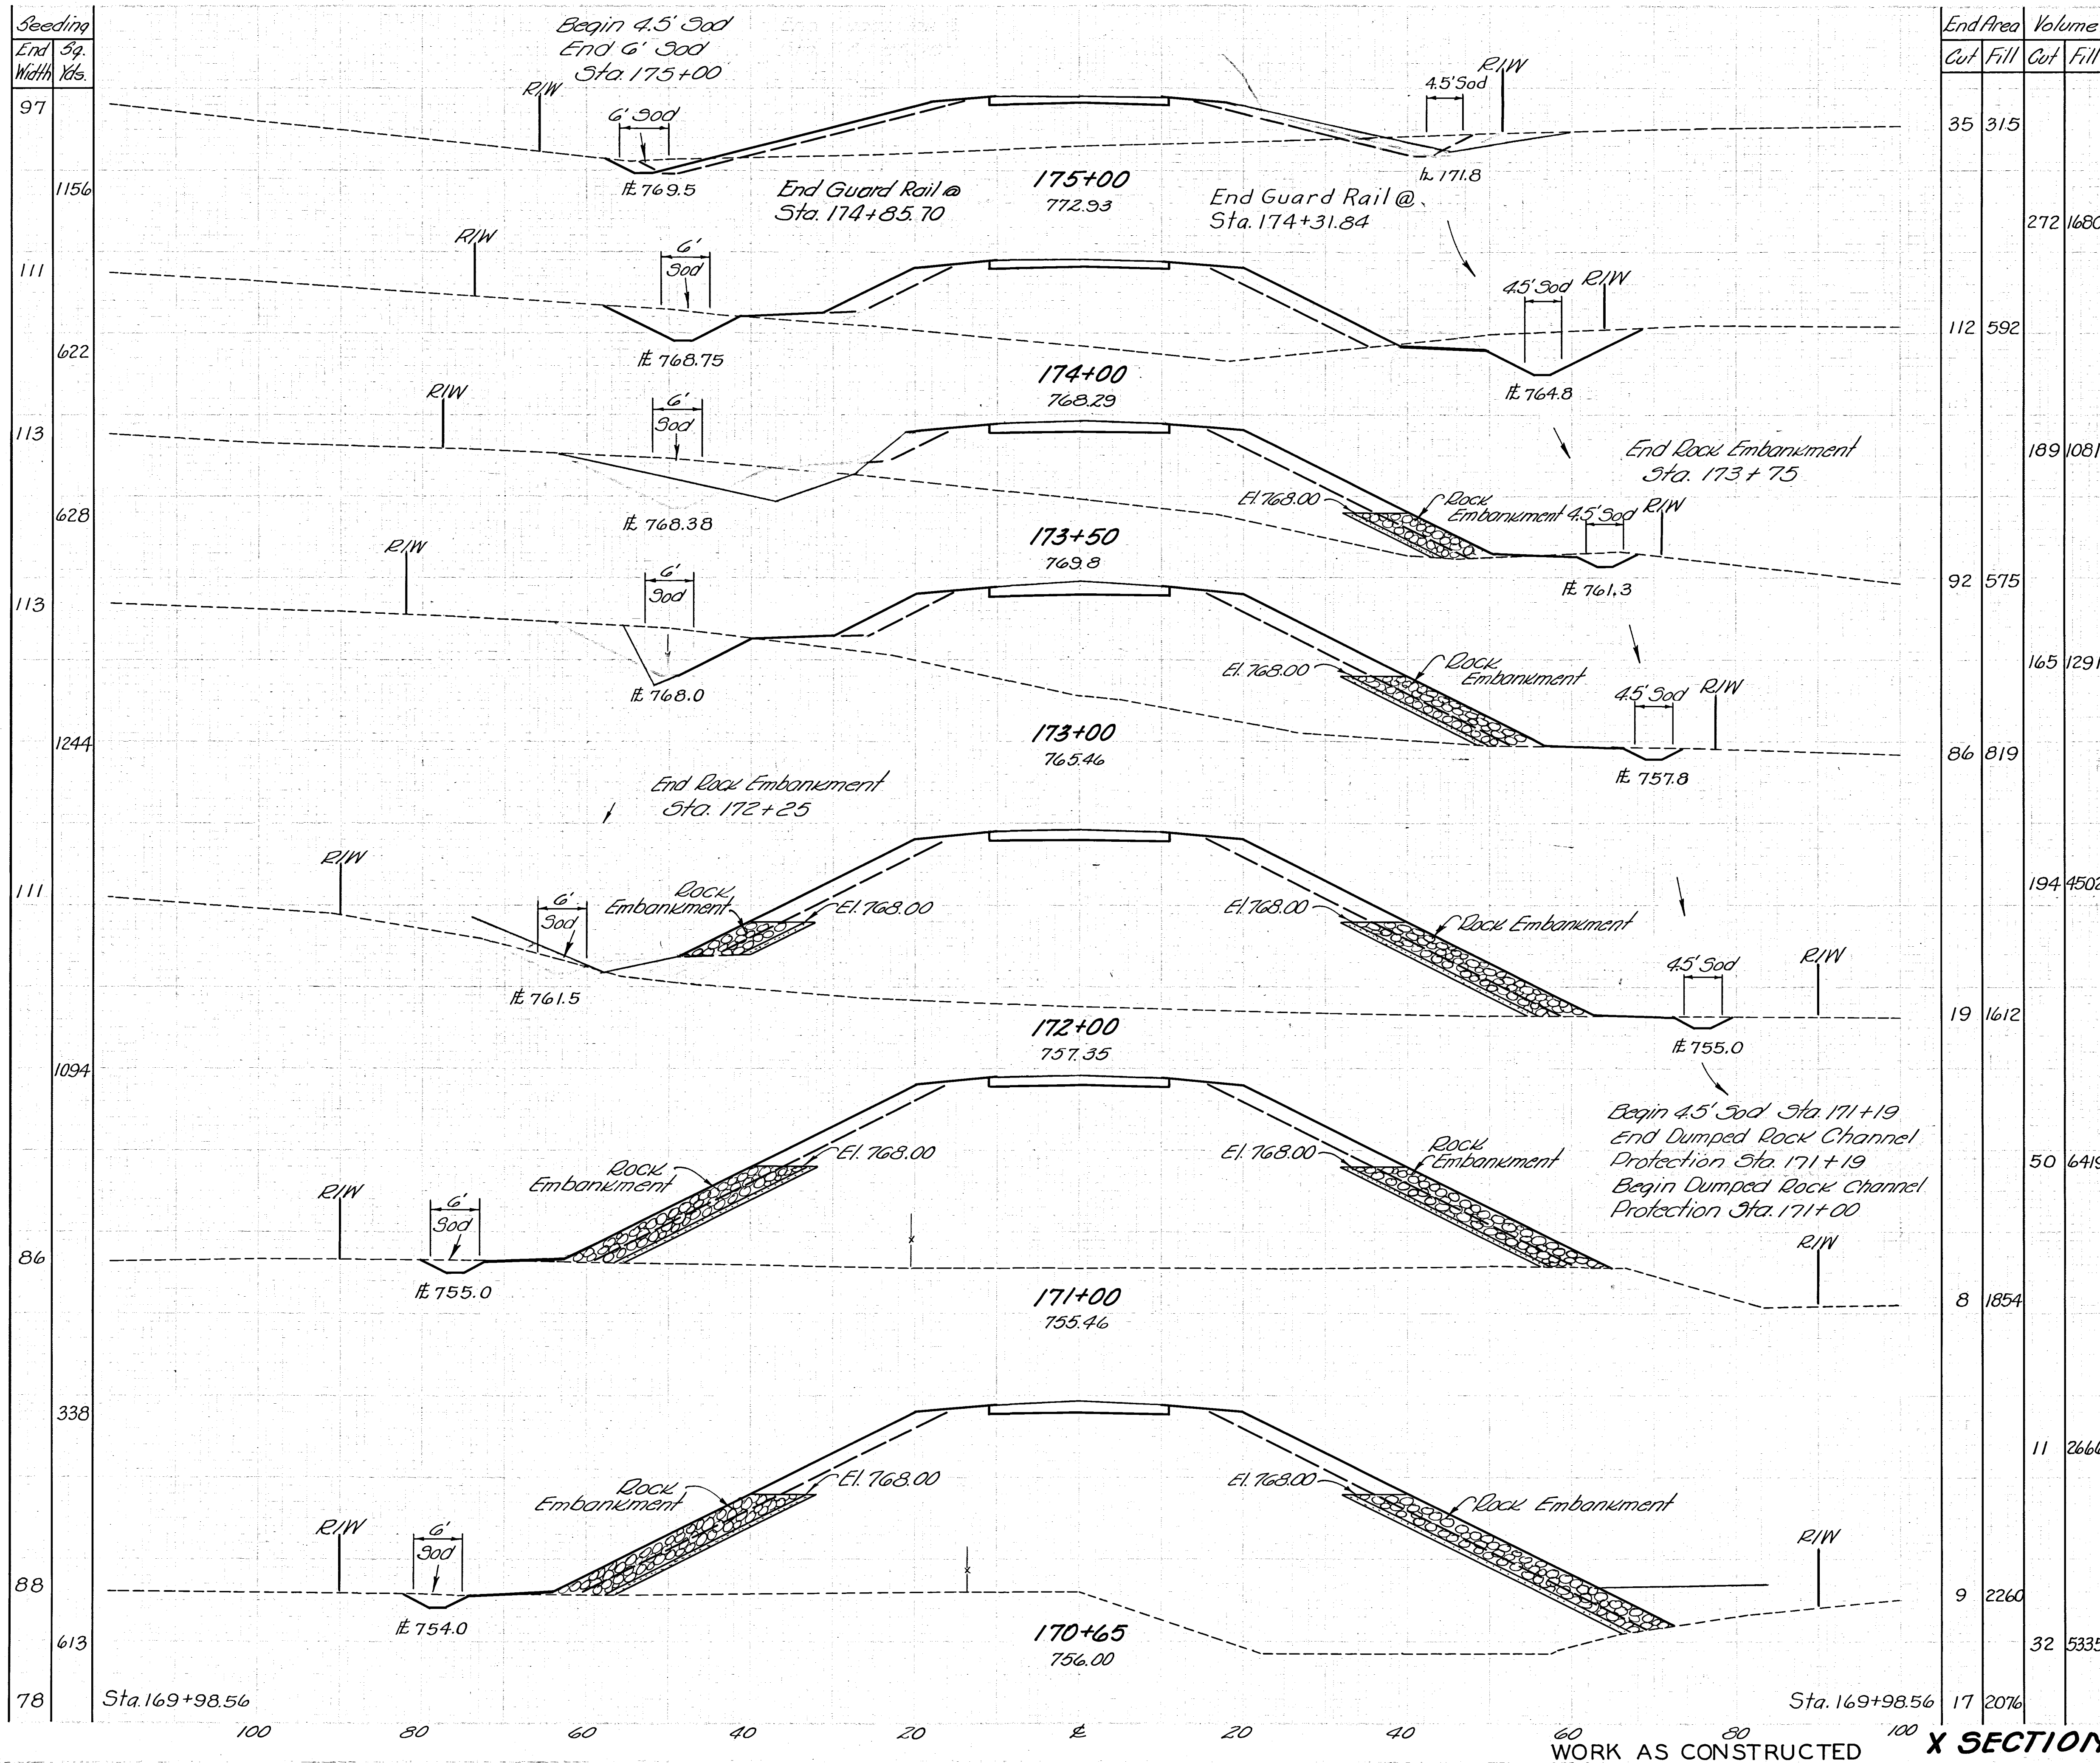

End Area		Volume	
Cut	Fill	Cut	Fill
35	315		
		272	1680
112	592		
		189	1081
92	575		
		165	1291
86	819		
		194	4502
19	1612		
		50	6419
8	1854		
		11	2666
9	2260		
32	5335		
17	2076		

MUSKINGUM COUNTY MUS-156-2.85

PARTICIPATION BY THE UNITED STATES OF AMERICA

Stations	Earthwork		Sand	
	End Area		End Area	
	Cut	Fill	Cut	Fill
Sta. 175+00	33	277		
Sta. 174+00	112	525		
Sta. 173+75			0	
Sta. 173+50	92	494	6	
Sta. 173+00	86	732	10	
Sta. 172+00	19	1489	15	
Sta. 171+00	8	1785	27	
Sta. 170+65	9	2080	33	
Sta. 169+98.56	17	1894	29	

REVISION	DATE	DESCRIPTION	BY:
U. S. ARMY ENGINEER DISTRICT, HUNTINGTON CORPS OF ENGINEERS HUNTINGTON, W. VA.			
DRAWN BY: EER		LICKING RIVER DILLON RESERVOIR PROJECT	
TRACED BY: JEW		RELOCATION OF OHIO STATE ROUTE NO. 156 (Section 3 & 4)	
CHECKED BY: JEW		DATE: JULY 1959	
SUBMITTED BY: Elmer S. Barrett		APPROVED: J. S. Barrett	
ELMER S. BARRETT ASSOCIATES		CHIEF ENGINEER	
RECOMMENDED: J. S. Barrett		CHIEF ENGINEER	
ELMER S. BARRETT ASSOCIATES CONSULTING ENGINEERS CHILLICOTHE, OHIO		SCALE: 1" = 10'-0" DRAWING NUMBER 0271-UD6-68/30 SHEET 30 OF 62	