


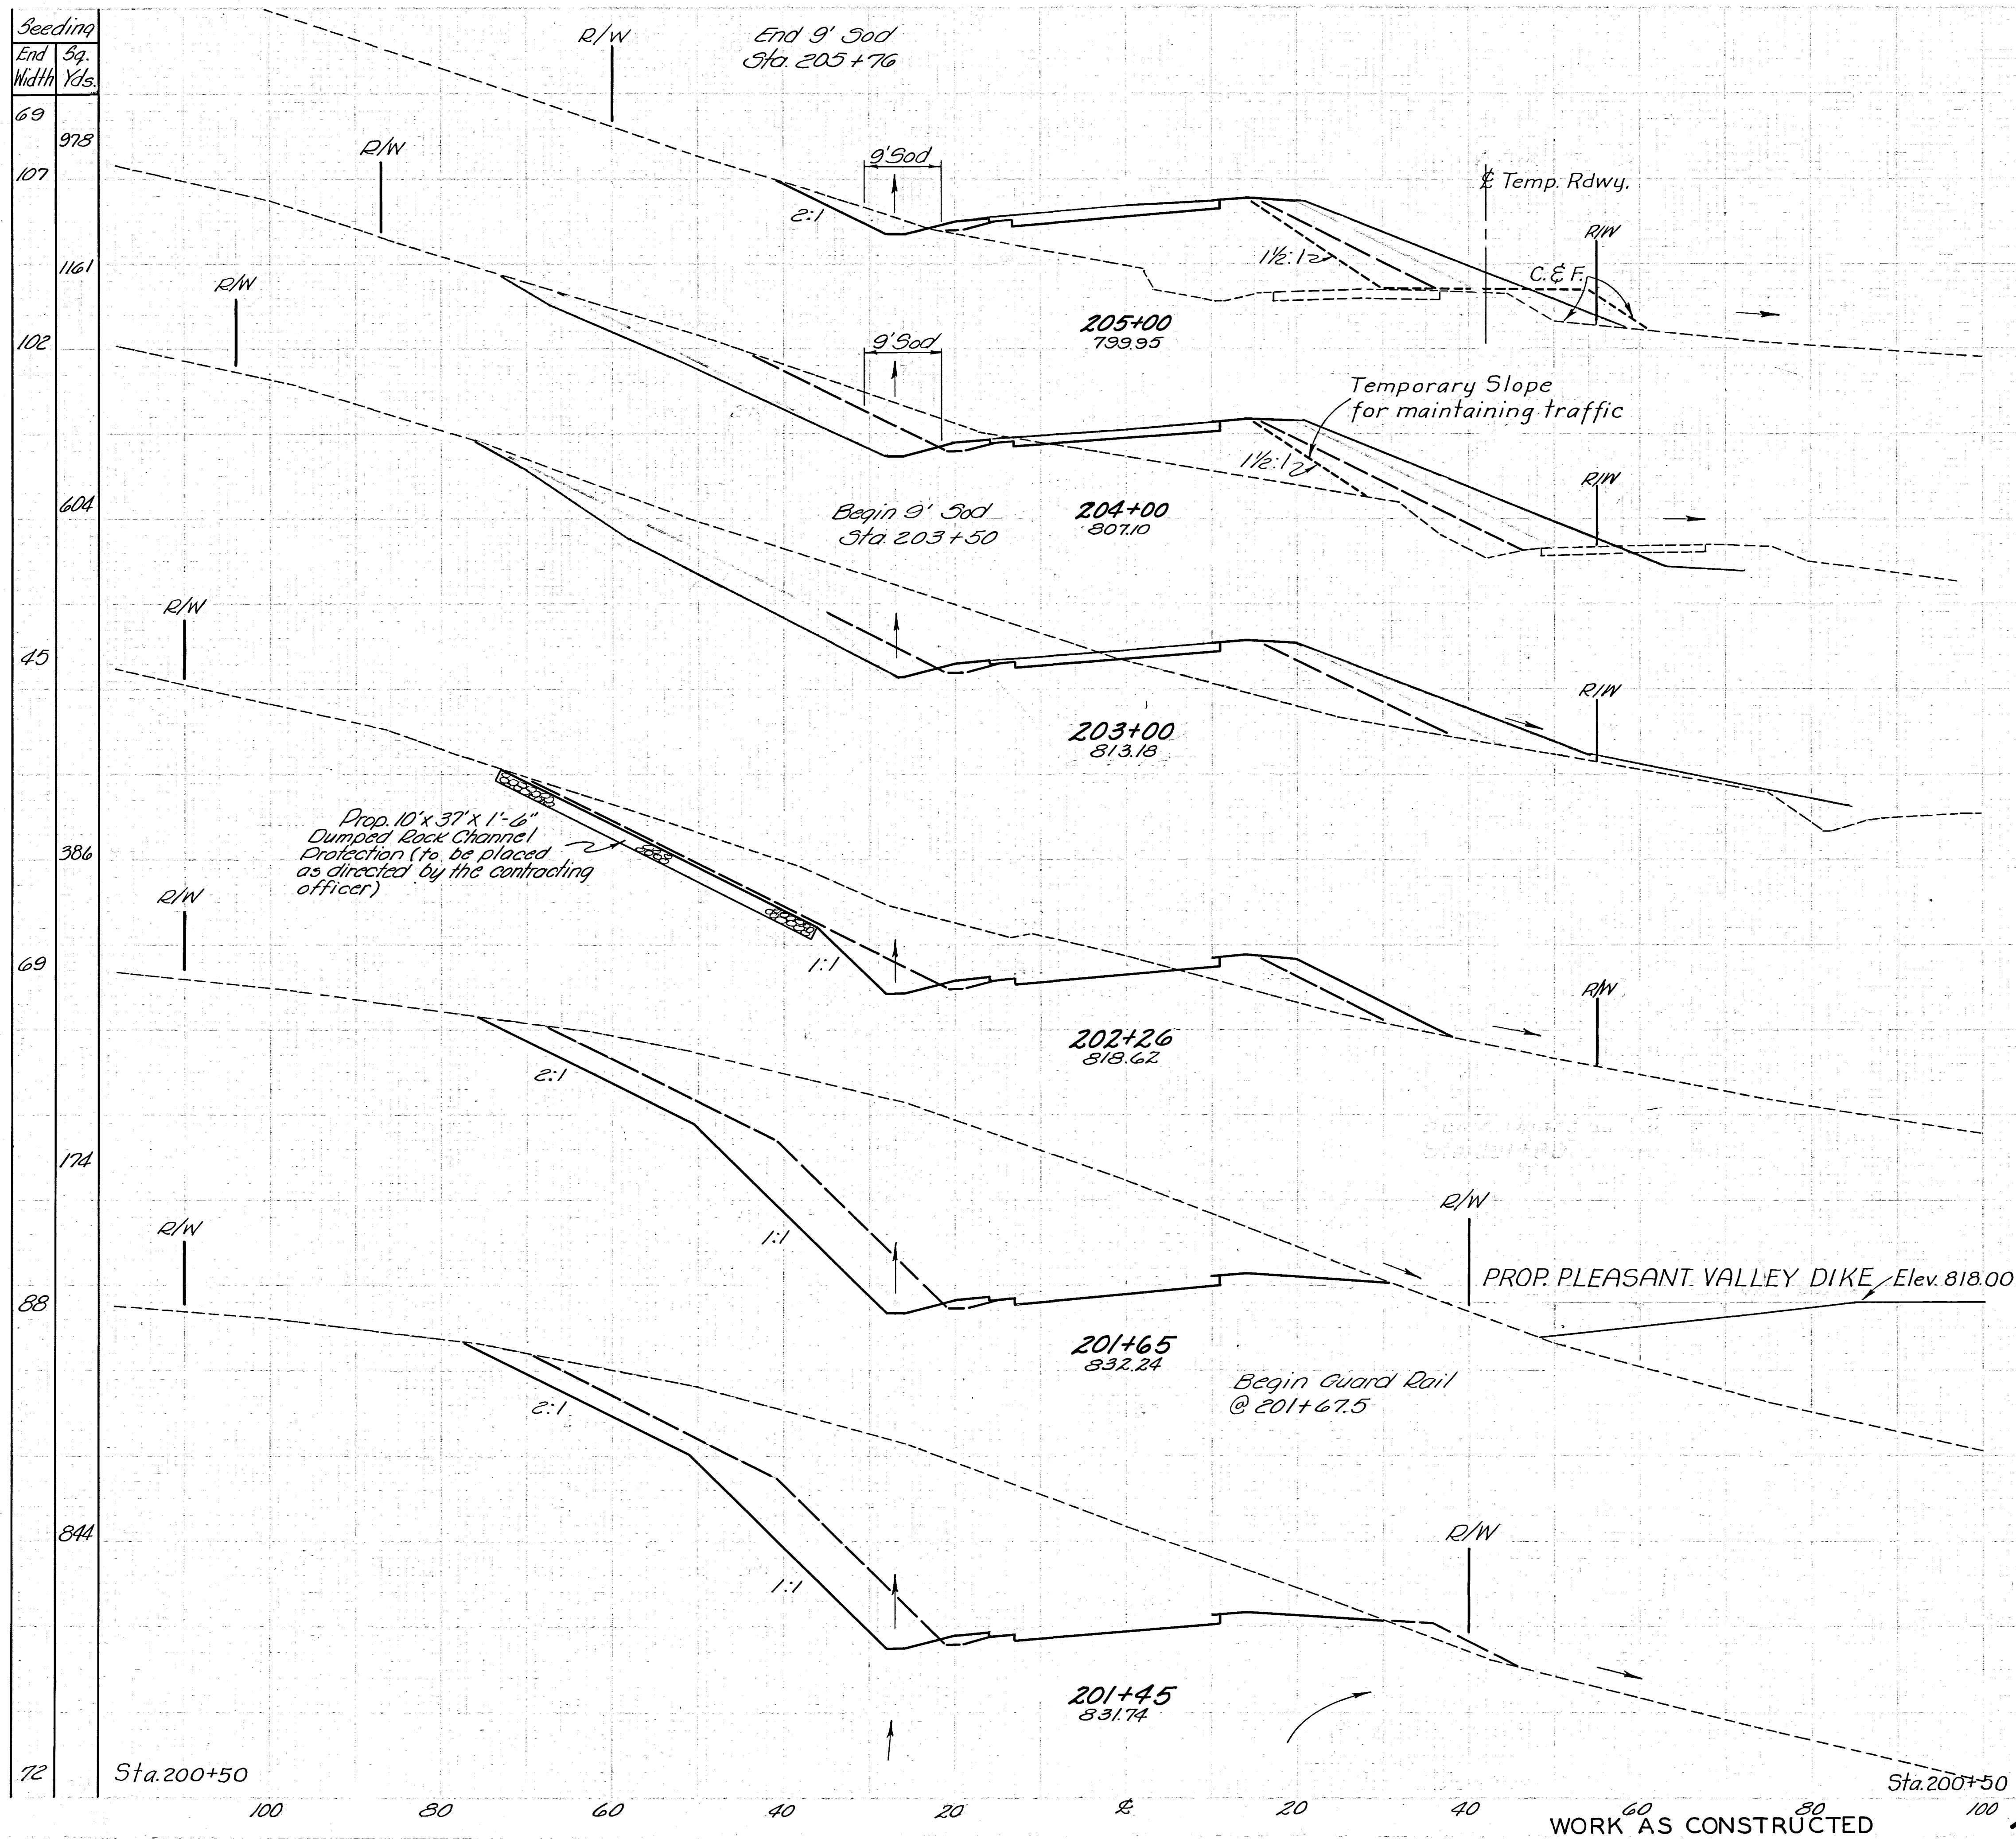

End Area		Volume	
Cut	Fill	Cut	Fill
24	380		
	381	1159	
182	246		
	930	774	
320	172		
	951	356	
374	88		
	1789	99	
1210	0		
	834	0	
1176	0		
	5834	0	
2140	0		

MUSKINGUM COUNTY
MUS-156-2.85

PARTICIPATION BY THE UNITED STATES
OF AMERICA

Stations	Earthwork			
	End Area		Volume	
	Cut	Fill	Cut	Fill
Sta. 205+00	0	380		
			115	950
Sta. 204+00	62	183		
			680	583
Sta. 203+00	305	132		
			856	258
Sta. 202+26	320	56		
			1466	63
Sta. 201+65	978	0		
			711	0
Sta. 201+45	943	0		
			4819	0
Sta. 200+50	1796	0		

REVISION	DATE	DESCRIPTION	BY
U. S. ARMY ENGINEER DISTRICT, HUNTINGTON CORPS OF ENGINEERS HUNTINGTON, W. VA.			
DRAWN BY: ESR		LICKING RIVER DILLON RESERVOIR PROJECT	
TRACED BY:		RELOCATION OF OHIO STATE ROUTE NO. 156 (Section 3 & 4)	
CHECKED BY: SEW		DATE: JULY 1959	
SUBMITTED BY: Elmer S. Barrett		APPROVED: [Signature]	
ELMER S. BARRETT ASSOCIATES		COL. C. E. DISTRICT ENGINEER	
RECOMMENDED: [Signature]		SCALE: 1" = 10'-0"	
CHIEF ENG. DIV.		SPEC. NO.	
ELMER S. BARRETT ASSOCIATES CONSULTING ENGINEERS CHILLICOTHE, OHIO		DRAWING NUMBER 0271-UD6-68/35 SHEET 35 OF 62	