MUSKINGUM COUNTY
MUS-156-2.85

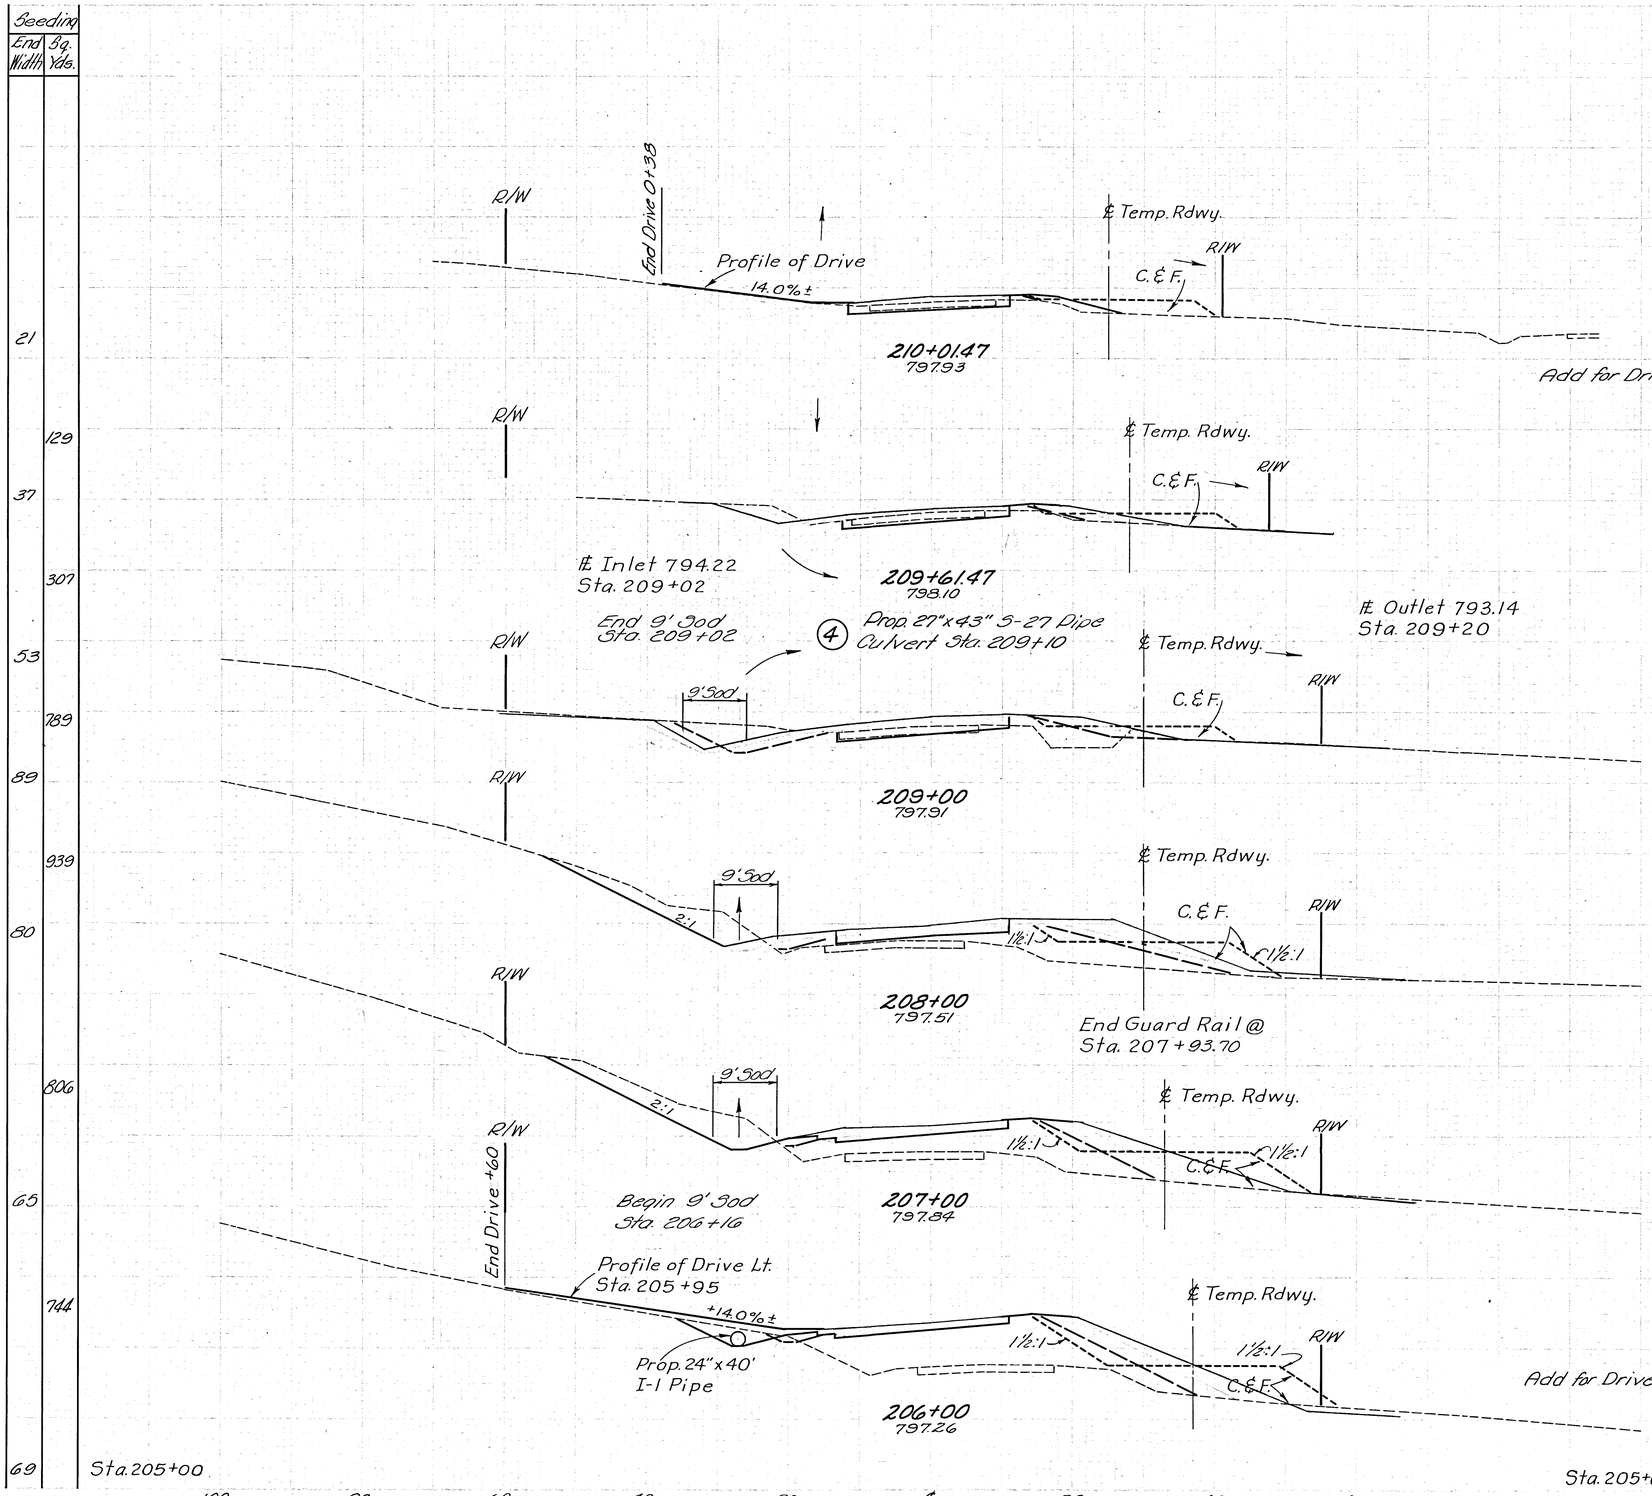

Stations	Earthwork End Area Cut	Fill	Volume Cut	Fill
Sta. 210+01.47	0	3		
	22	14		
Drive			15	
			0	7
Add for Drive			15	
Sta. 209+61.47	0	6		
			44	23
			60	47
	38	17		
Sta. 209+00	53	35		
			98	274
			147	73
Sta. 208+00	0	113		
			0	506
	91	47		
Sta. 207+00	0	160		
			7	759
			300	350
Sta. 206+00	4	250		
Drive			3	
			7	1074
	71	142		
Sta. 205+00	0	330		
			285	624
	83	195		
			191	902
			3	
	20	292		
			81	1244
Sta. 205+00	24	380		

PARTICIPATION BY THE UNITED STATES OF AMERICA

REVISION	DATE	DESCRIPTION	BY

U. S. ARMY ENGINEER DISTRICT, HUNTINGTON
CORPS OF ENGINEERS
HUNTINGTON, W. VA.

DRAWN BY: EER
TRACED BY:
CHECKED BY: EEW
SUBMITTED BY: Elmer S. Barrett
ELMER S. BARRETT ASSOCIATES
RECOMMENDED: James N. Barron
CHIEF ENG. DIV.

LICKING RIVER
DILLON RESERVOIR PROJECT
RELOCATION OF
OHIO STATE ROUTE NO. 156
(Section 3 & 4)

APPROVED: R. J. Sidlowski
COL. C.E., DISTRICT ENGINEER
DATE: JULY 1959

ELMER S. BARRETT ASSOCIATES
CONSULTING ENGINEERS
CHILLICOTHE, OHIO

SCALE: 1" = 10'-0"
SPEC. NO.
DRAWING NUMBER
027f-UD6-68/36
SHEET 36 OF 62

WORK AS CONSTRUCTED

X SECTIONS - STA. 206+00 TO STA. 210+01.47