


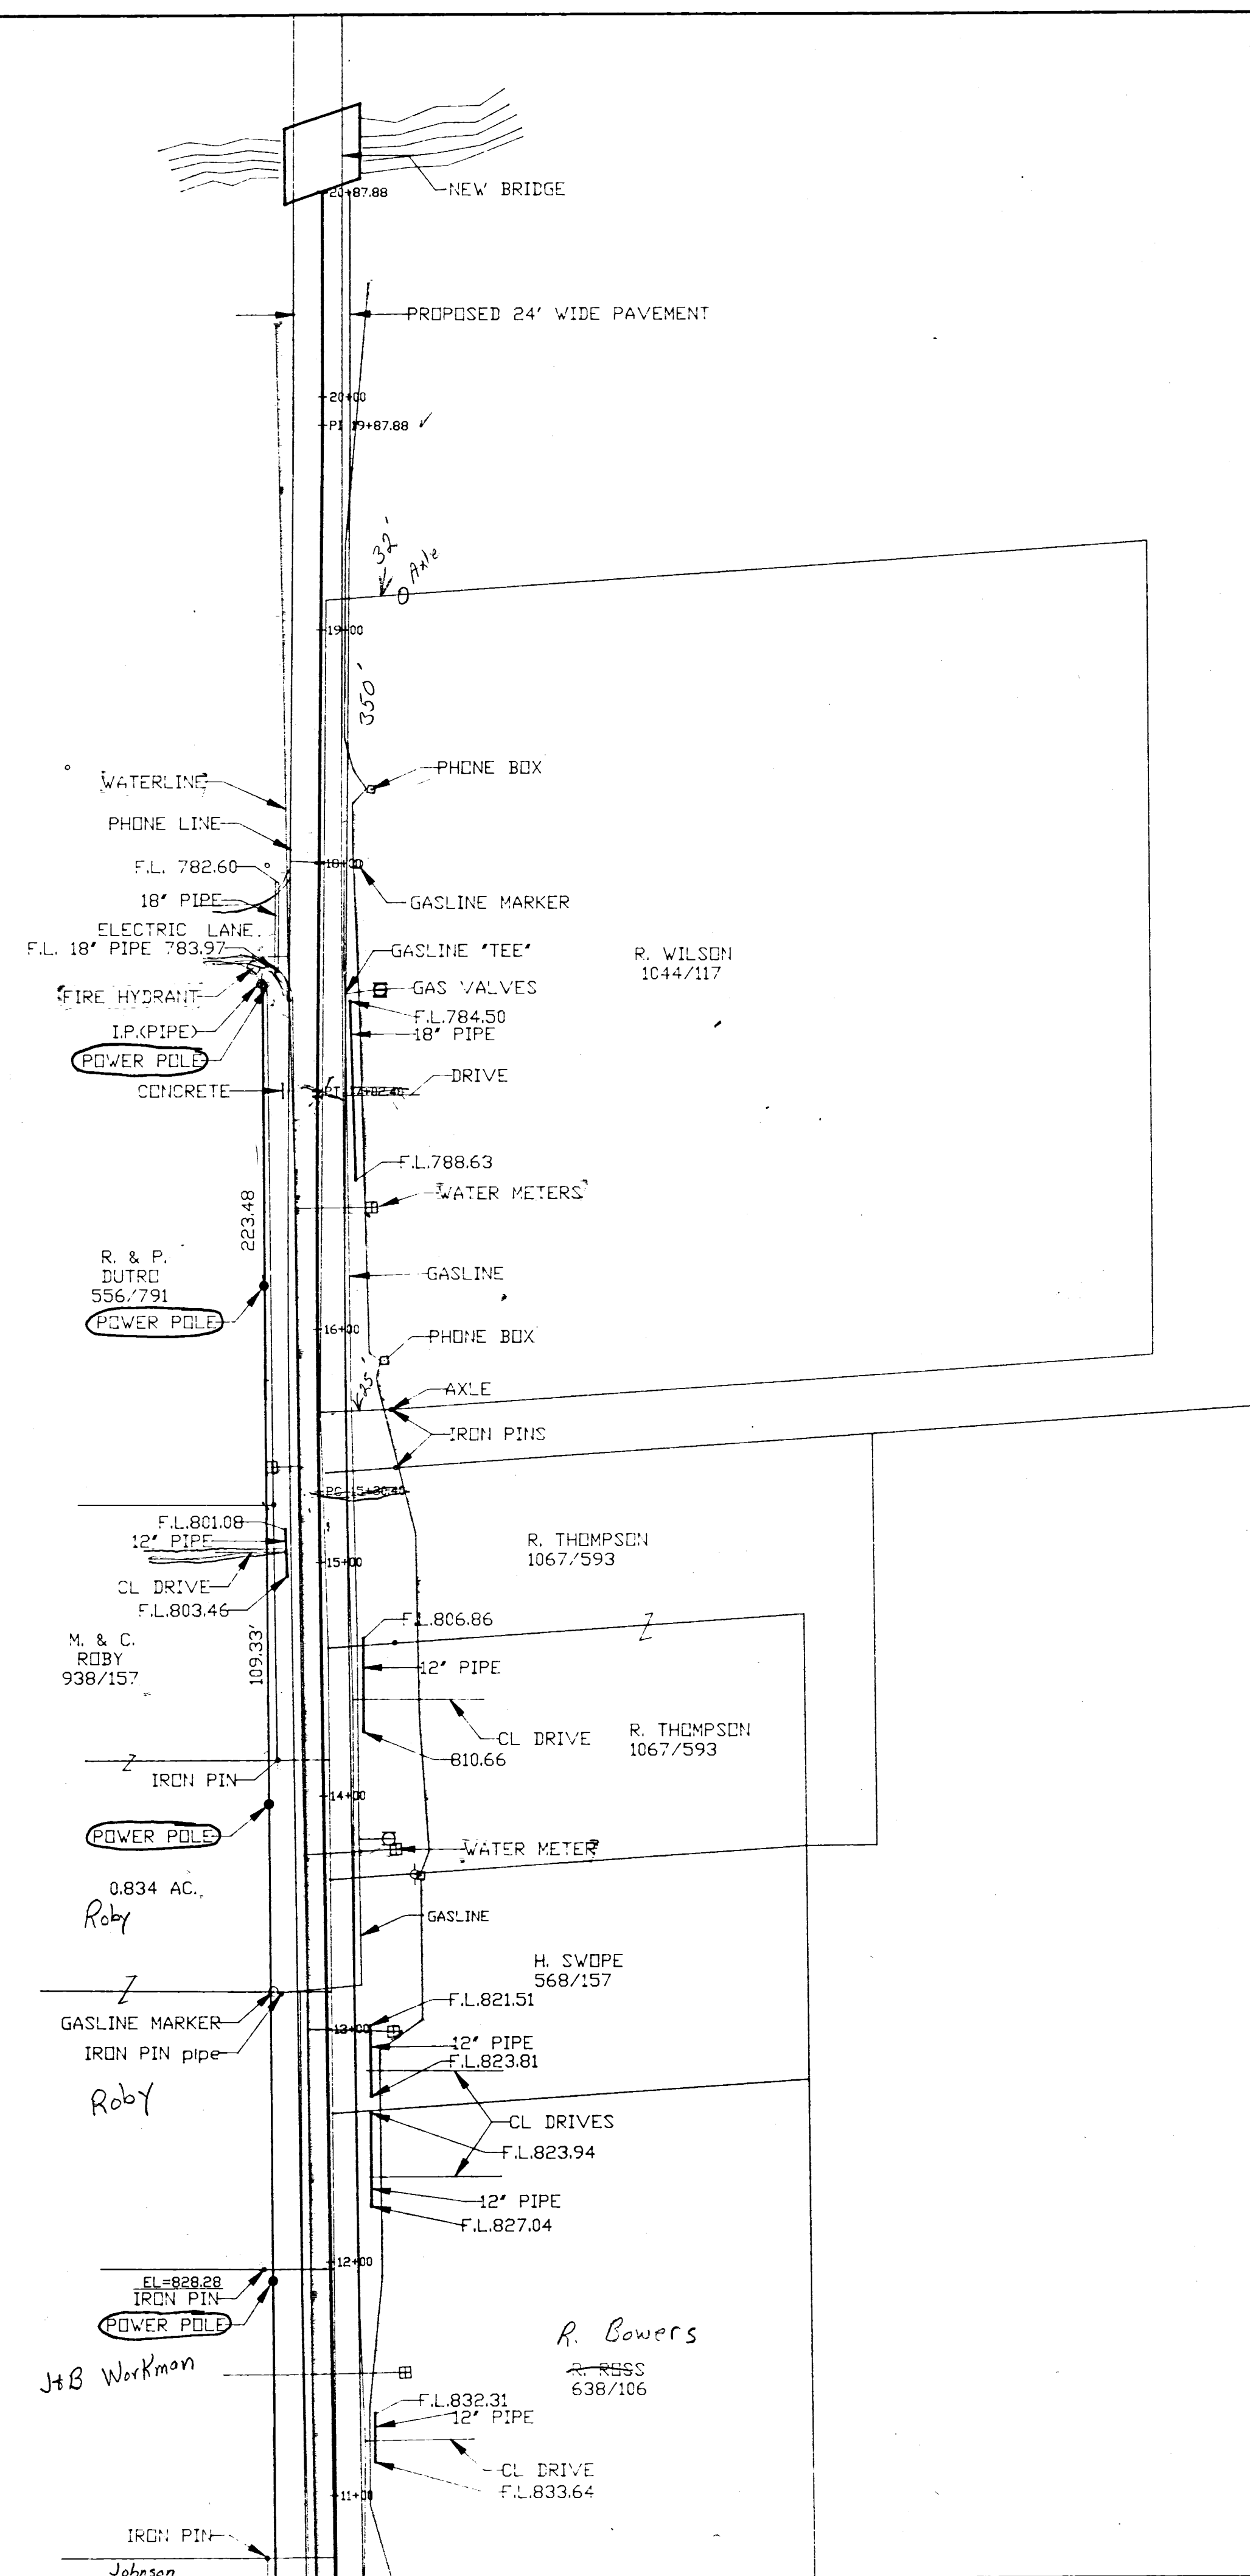

RELOCATION OF SONORA ROAD

PERRY TOWNSHIP

LOREN C. CAMP
MUSKINGUM CO. ENGINEER



SCALE 1"=50'

0 25 50 100

LEGEND

- IRON PIN FOUND
- GAS VALVE
- TELEPHONE RISER
- φ UTILITY POLE
- WATER METER

NOTE: 6" WATERMAIN ALONG
WEST EDGE OF PAVEMENT

W.J. BIEDENBACH & ASSOC. SURVEYING & MAPPING ZANESVILLE, OHIO (614) 453-4850	
DRAWN BY: WJB	MUSKINGUM CO.
SCALE: 1"=50'	CHECKED BY: WJB
Plot date: 04/24/95 at 09:29 File name: G:\SONORA\SONORA	