


County Road No 75
Brush Creek Twp.
Muskingum County

A-11

873

Now SH
1/5/40

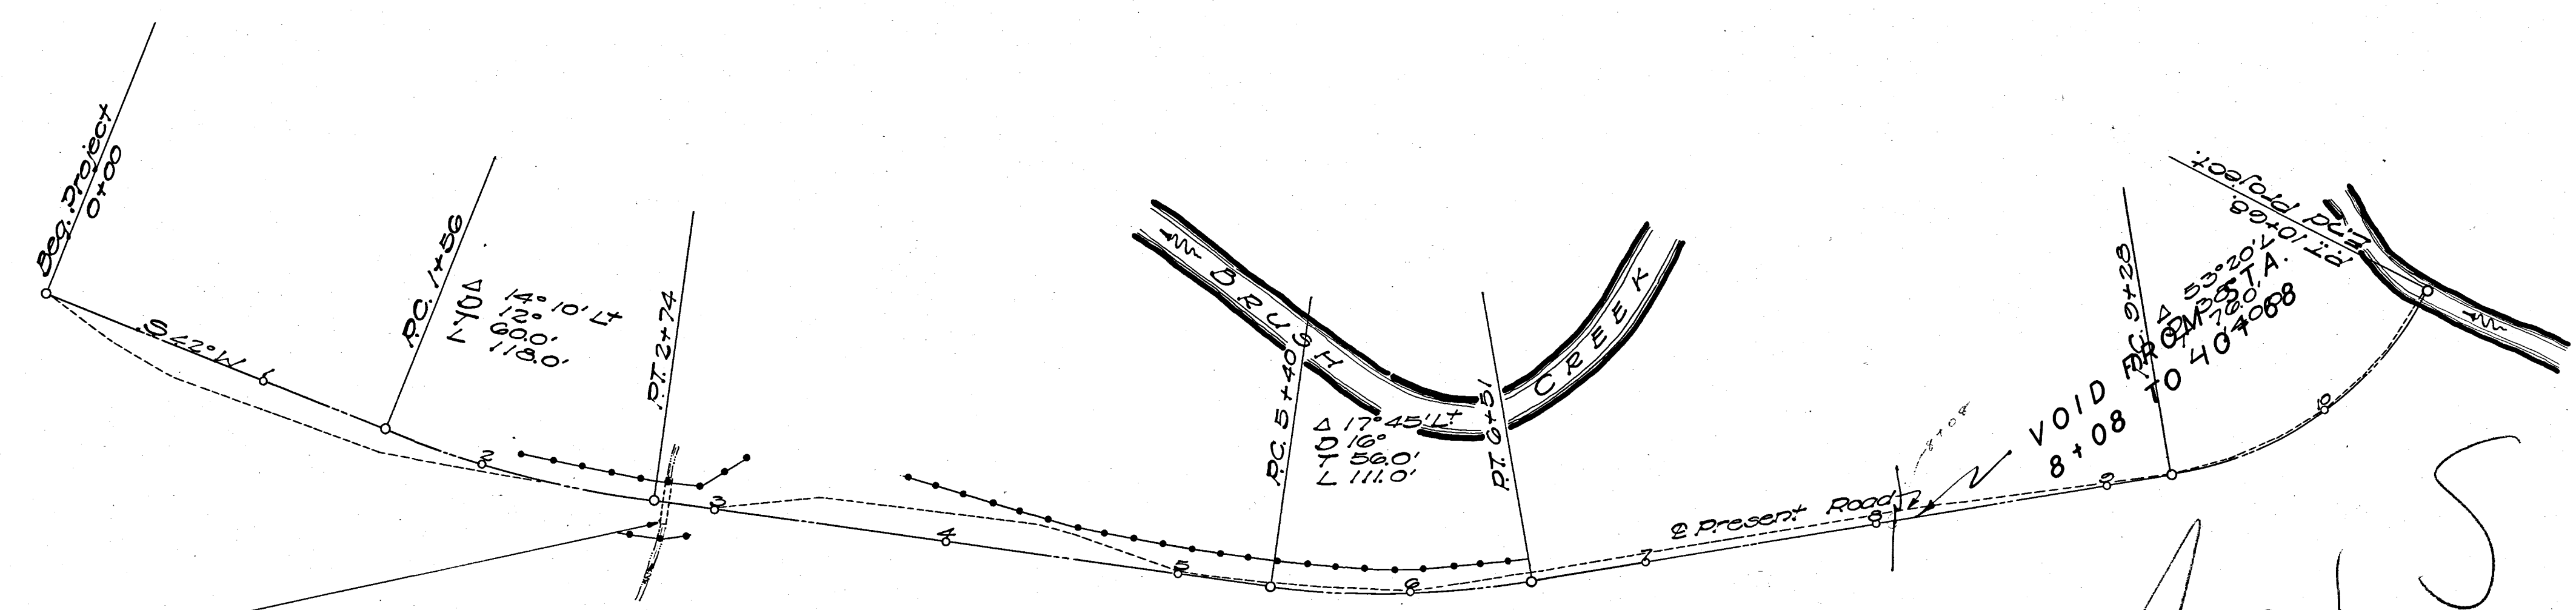

Sta. 2+75. Remove present 24"x20' V.B.R.
4C.I.P. Replace and extend at Sta.
2+65. See structure plan.

S.M. No. 1. Vertical spike 25' Lt. Sta. 0-70
Root 72" Oak. Elevation 1000 (as'm'd.).

