


REV	DATE	DESCRIPTION	FUND
1	1-10-74	Added Par 14G EL	

COMPLETION DATE - 1-22-74

JOB NO.	REV. NO.	DIVISION	STATE	PROJECT
05044(1)	2	OHIO	U 400 (13)	

MUSKINGUM COUNTY
MUS-60-16.88
RIW PLANS 1"=20'

20
26

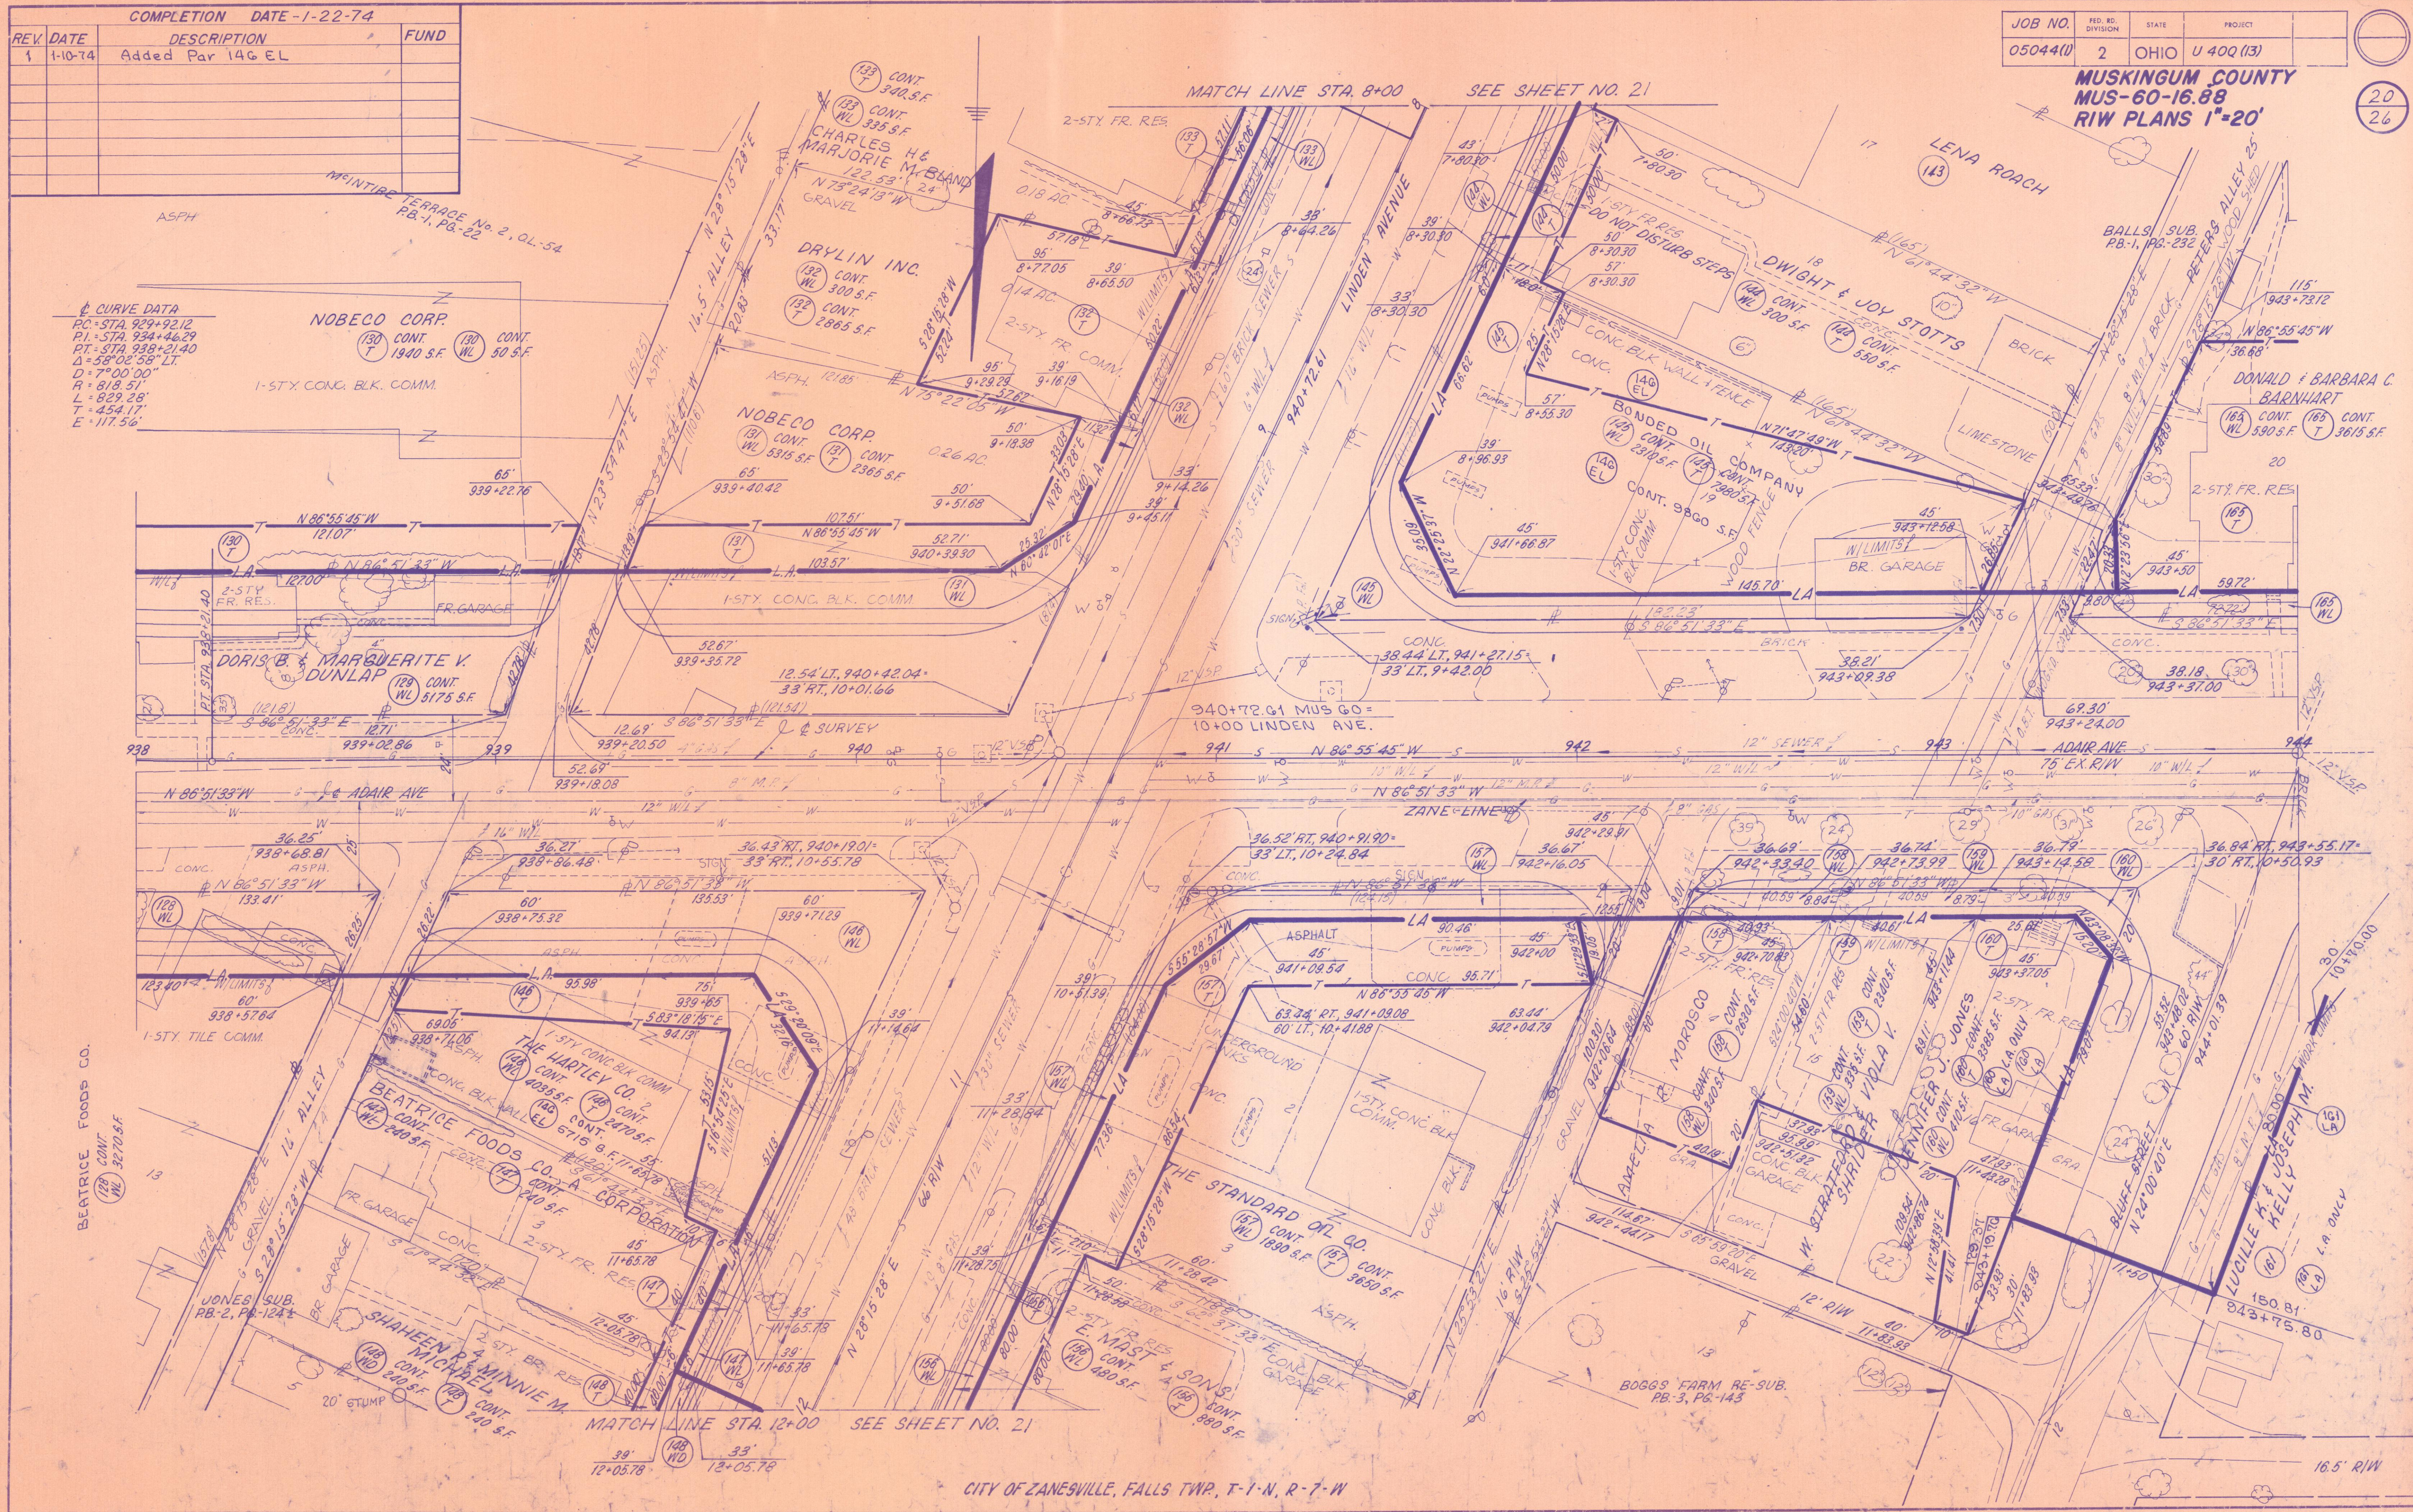

CITY OF ZANESVILLE, FALLS TWP, T-1-N, R-7-W

S.R.-60 STA. 938+00 TO STA. 944+00 RIW