


JOB NO.	REV. DIVISION	STATE	PROJECT
05044(1)	2	OHIO	U 400(13)

MUSKINGUM COUNTY
MUS-60-16.88
R/W PLANS 1"=20'

25
26

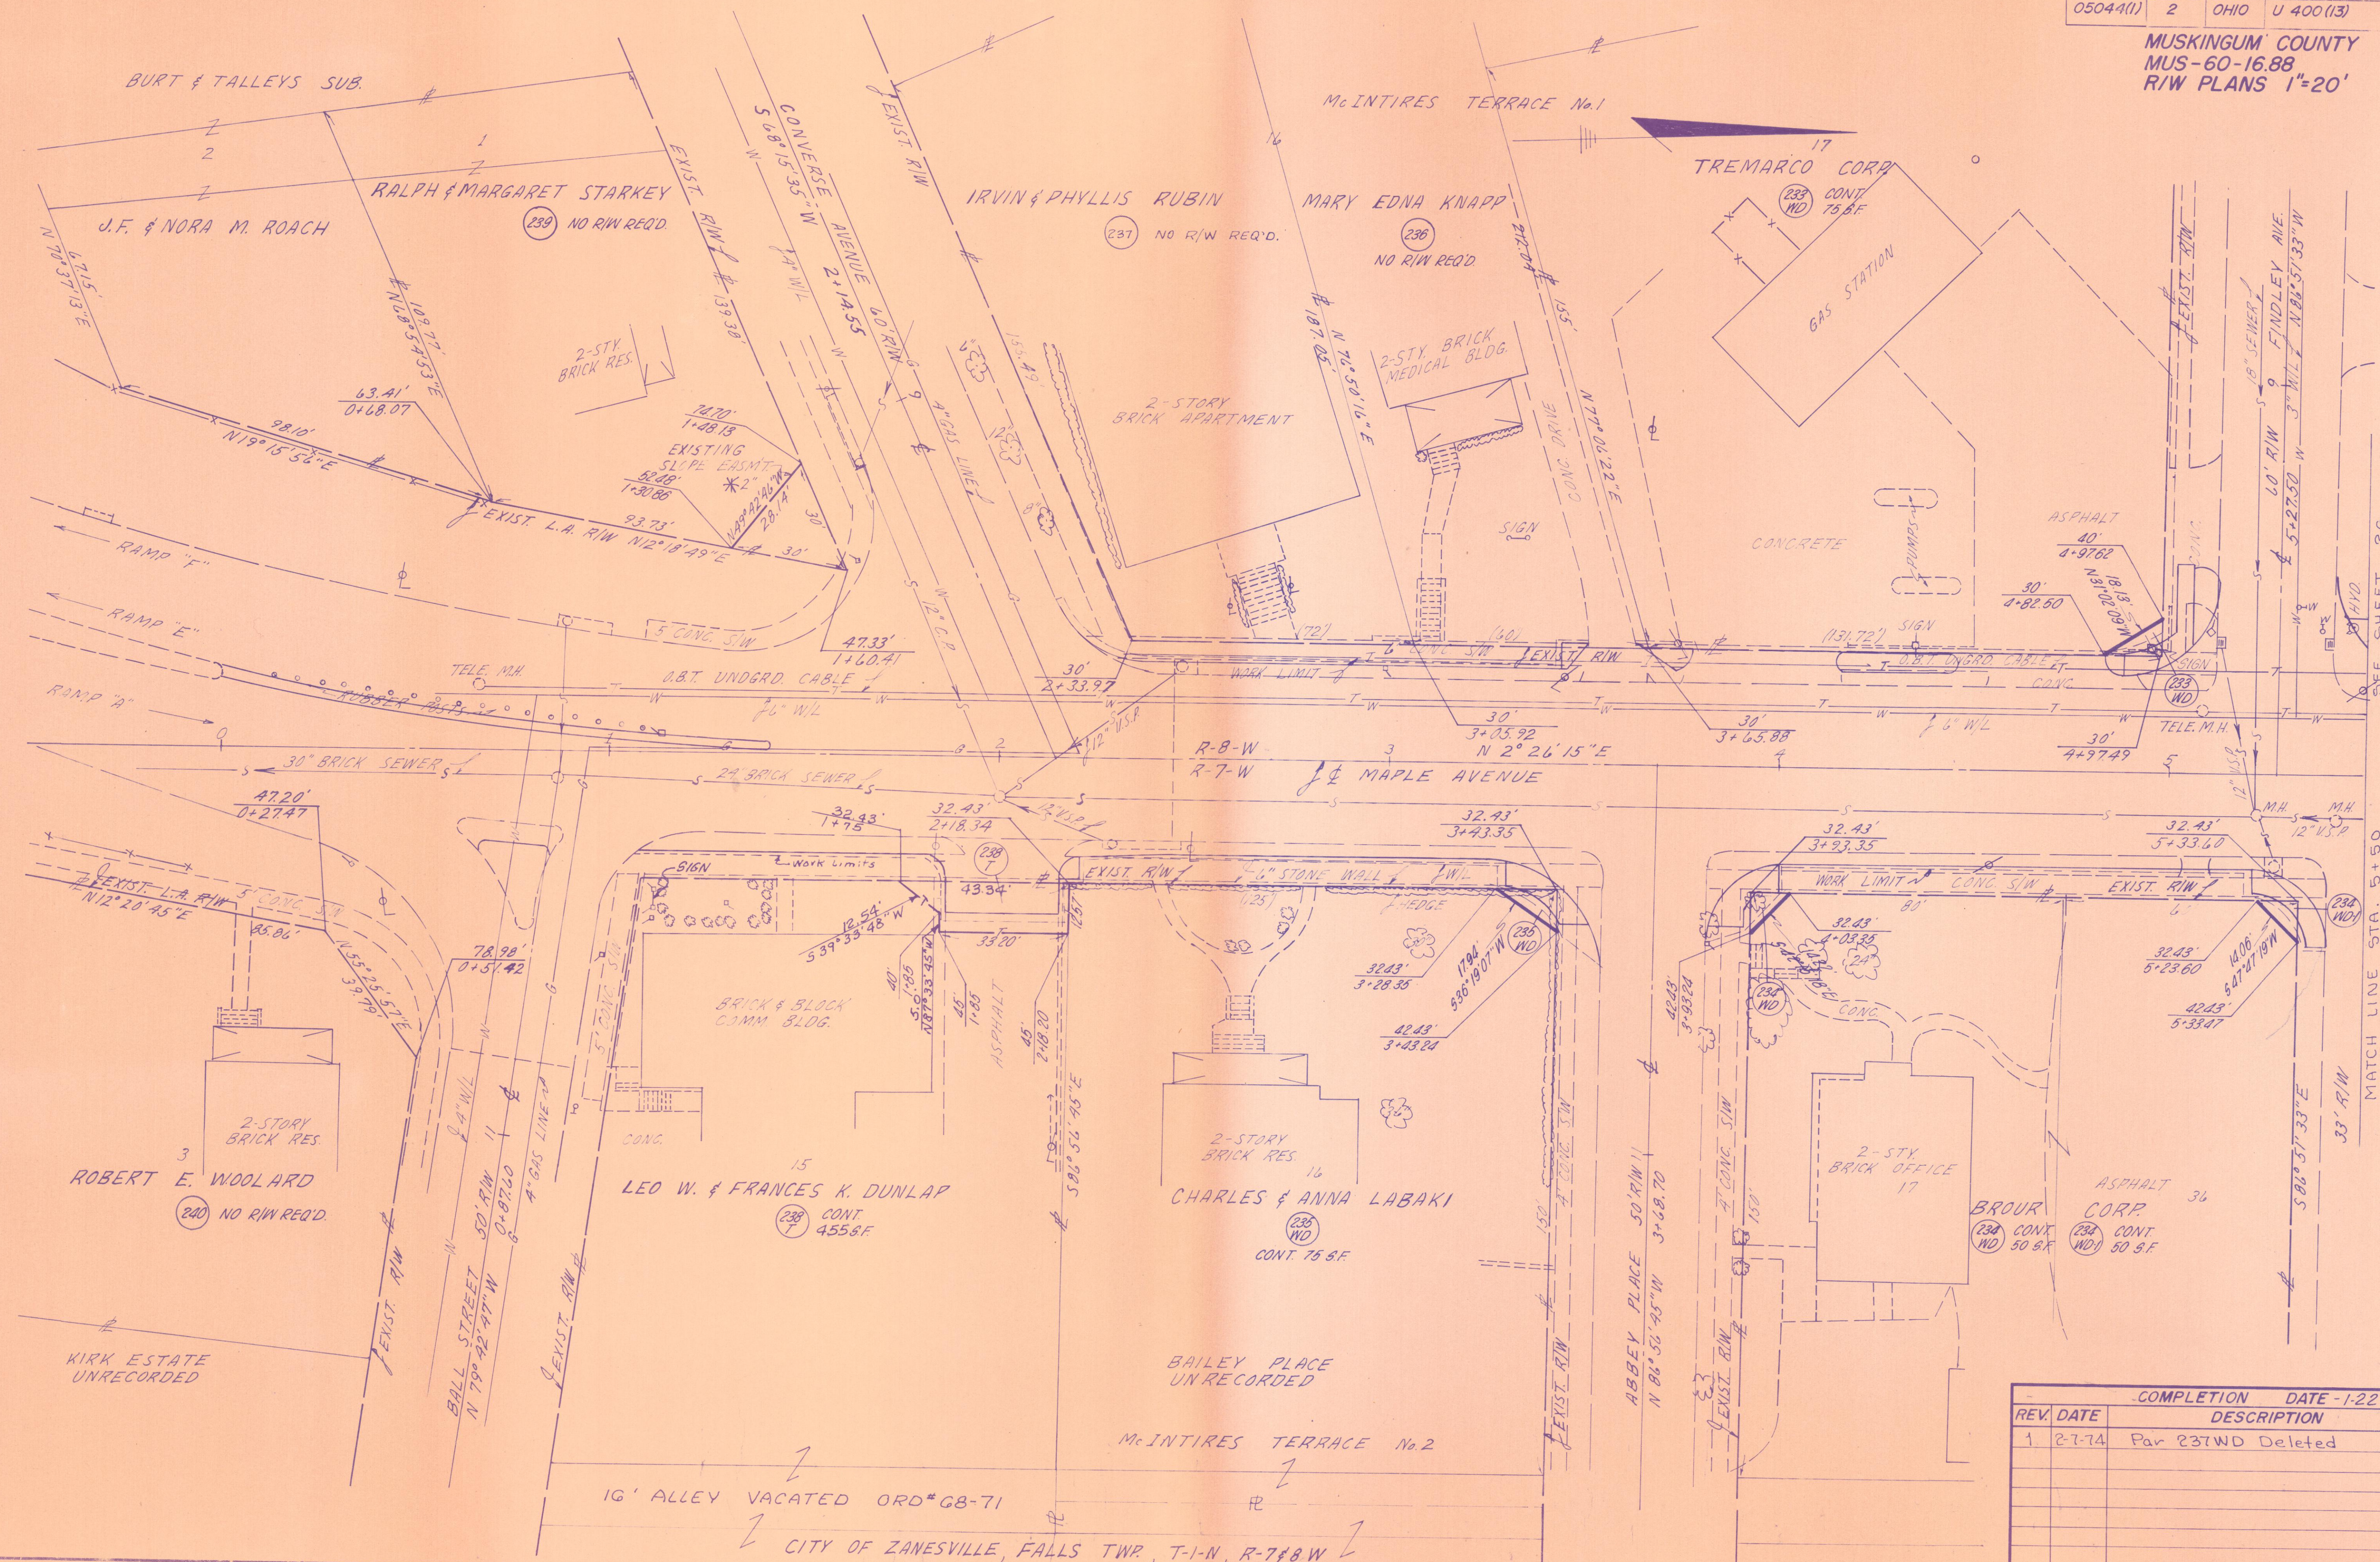

COMPLETION DATE - 1-22-74		
REV.	DATE	DESCRIPTION
1	2-7-74	Par 237WD Deleted

MAPLE AVE. STA. 0+00 TO STA. 5+50 R/W