STATE JOB NO.	FED. RD. DIVISION	STATE	PROJECT	
05044(2)	2	OHIO	U-400(14)	

83/86

10/13

MUSKINGUM COUNTY
MUS-60-17.41
R/W PLANS 1" = 20'

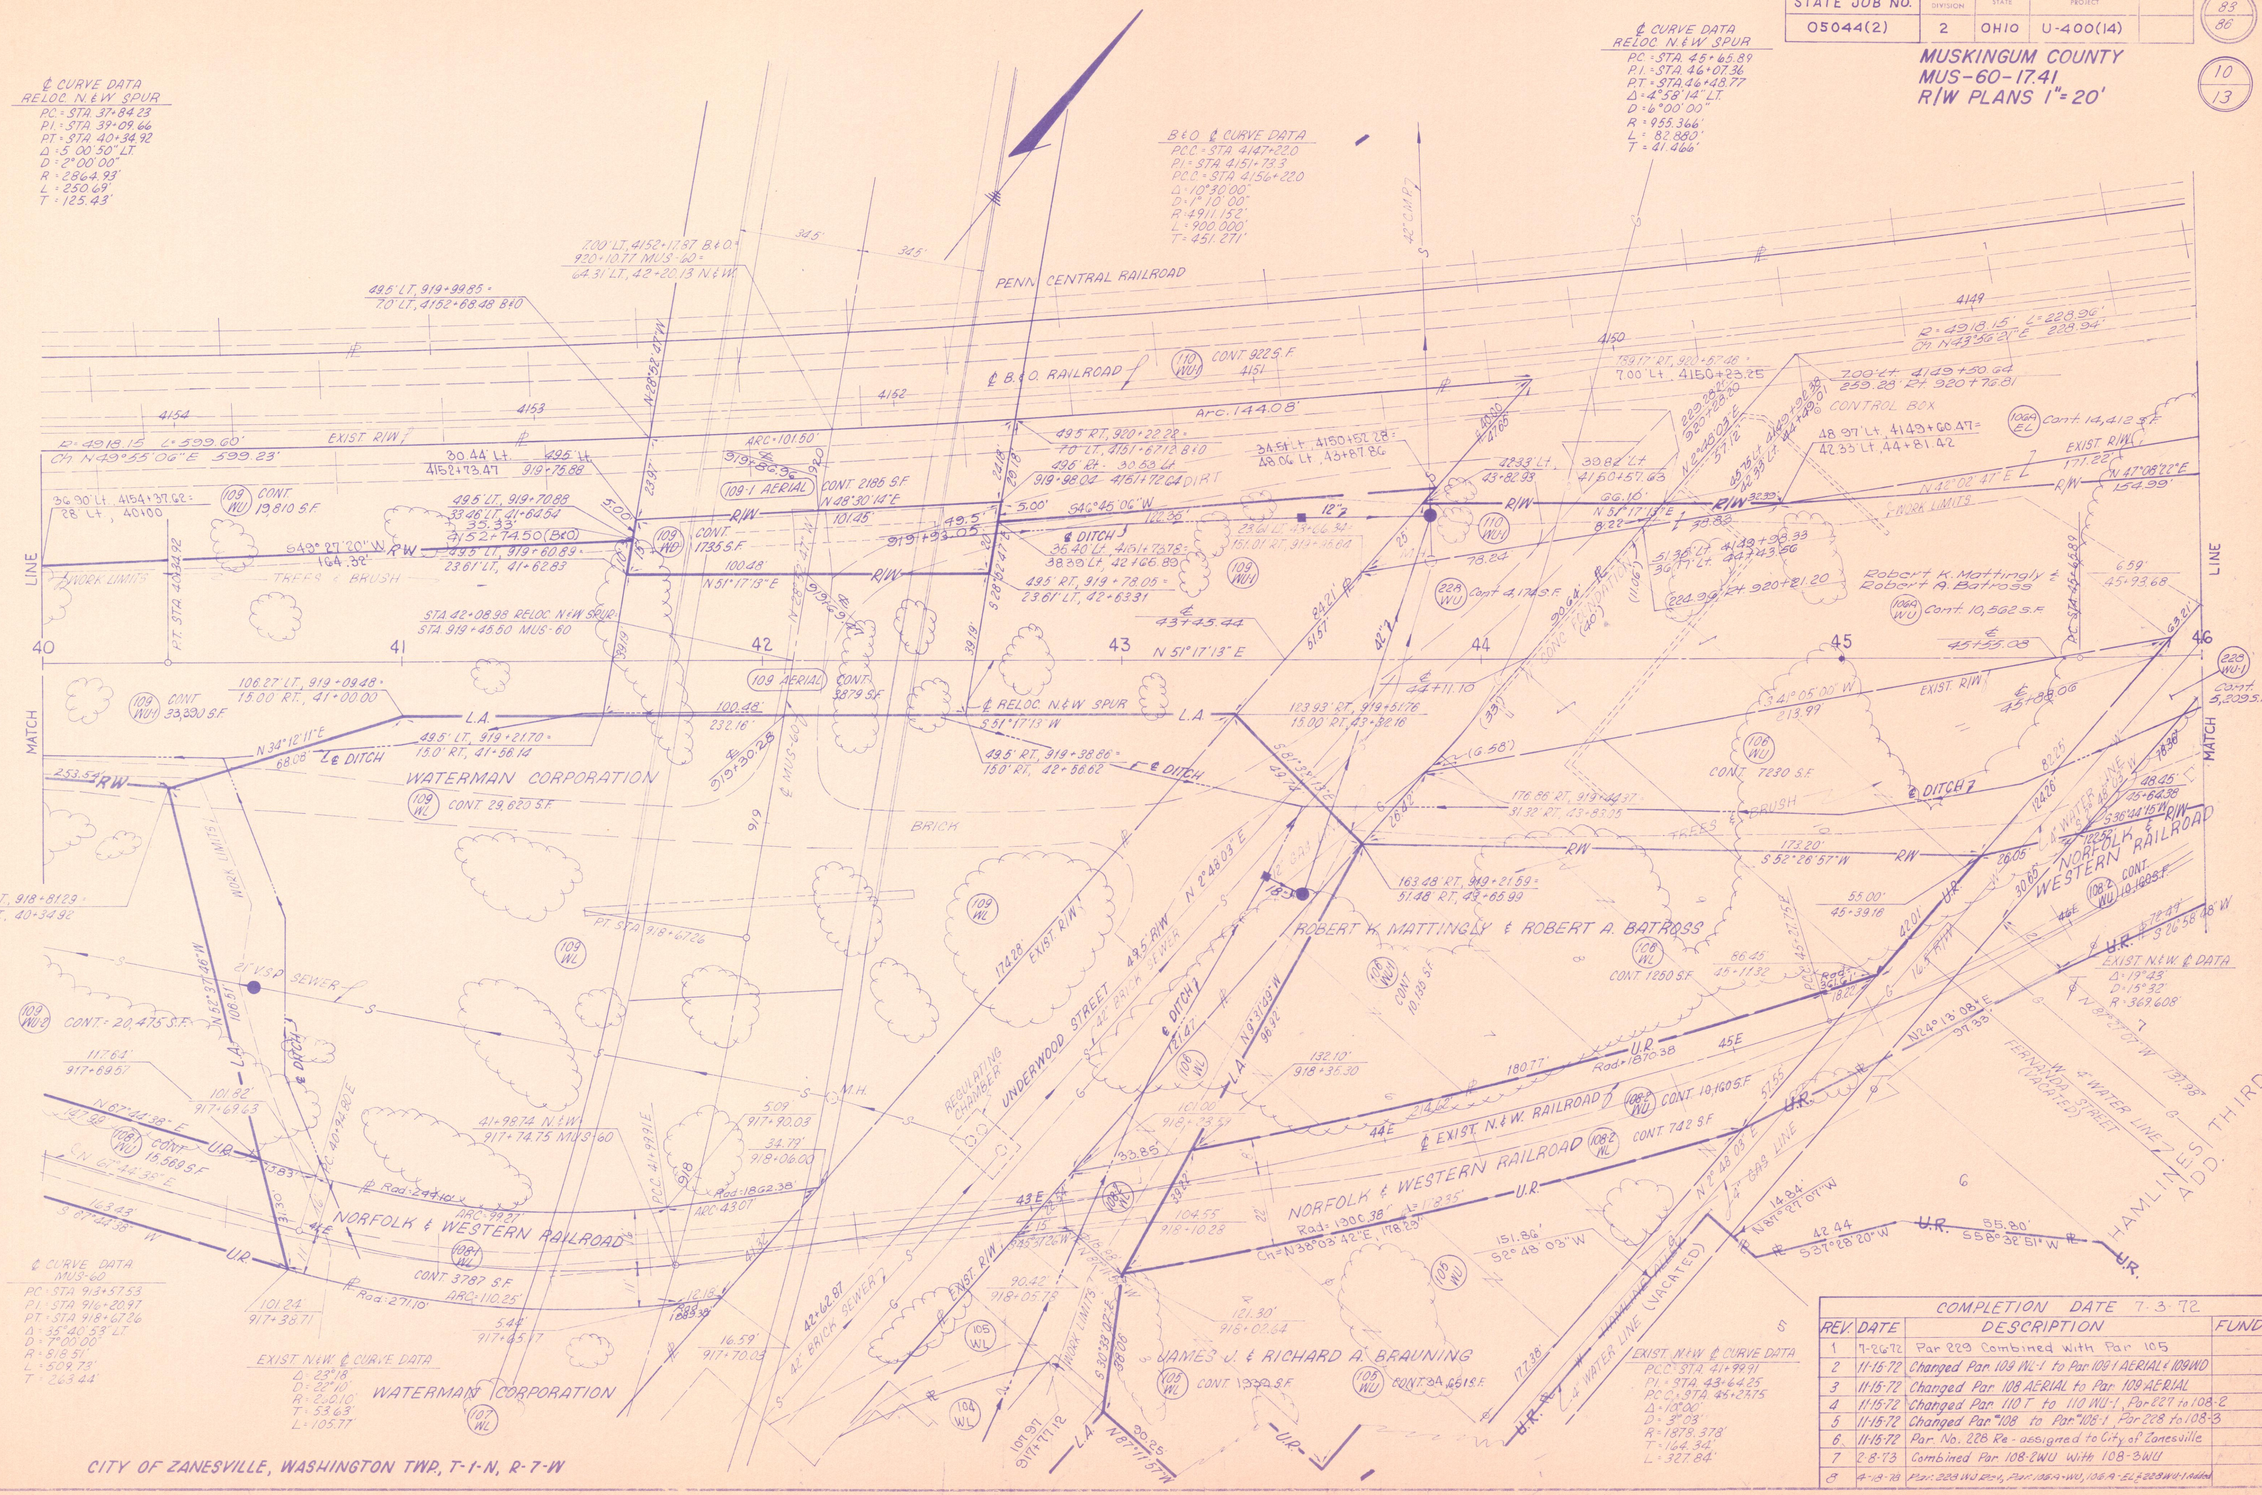

REV.	DATE	DESCRIPTION	FUND
		COMPLETION DATE 7-3-72	
1	7-26-72	Par 229 Combined with Par 105	
2	11-15-72	Changed Par 109 WU-1 to Par 109-1 AERIAL & 109 WD	
3	11-15-72	Changed Par 108 AERIAL to Par 109 AERIAL	
4	11-15-72	Changed Par 110 T to 110 WU-1, Par 227 to 108-2	
5	11-15-72	Changed Par "108 to Par "108-1, Par 228 to 108-3	
6	11-15-72	Par. No. 228 Re-assigned to City of Zanesville	
7	2-8-73	Combined Par. 108-2WU with 108-3WU	
8	4-18-78	Par: 229 WU 105-1, Par: 108-A-WU, 108-A-EL & 229 WU-1 added	