


FED. RD. DIST. NO.	STATE	FED. AID PROJECT	FISCAL YEAR
10	OHIO	570A	1929


9
35

S.H. I.C.H. N° 344 Sec. K-L-M
MUSKINGUM COUNTY

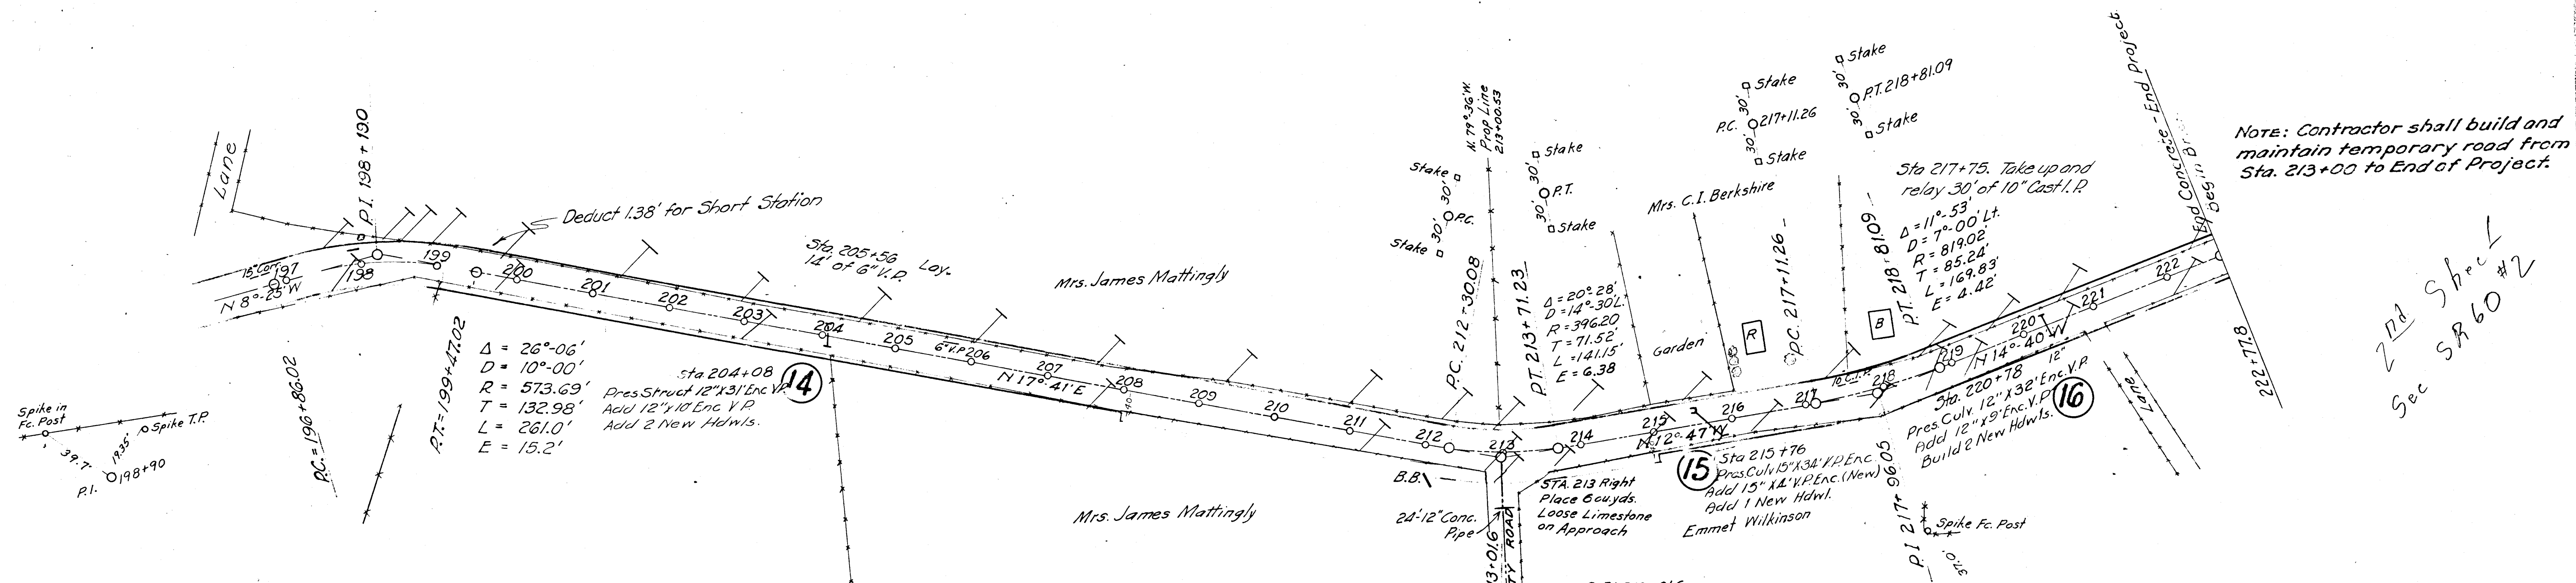

B.M. Sta. 212+50
Nail in 36" Sycamore
150 Right of E
Elev. 895.87

B.M. Sta. 219+85
Nail in Cherry Stump
Right of E
Elev. 852.75

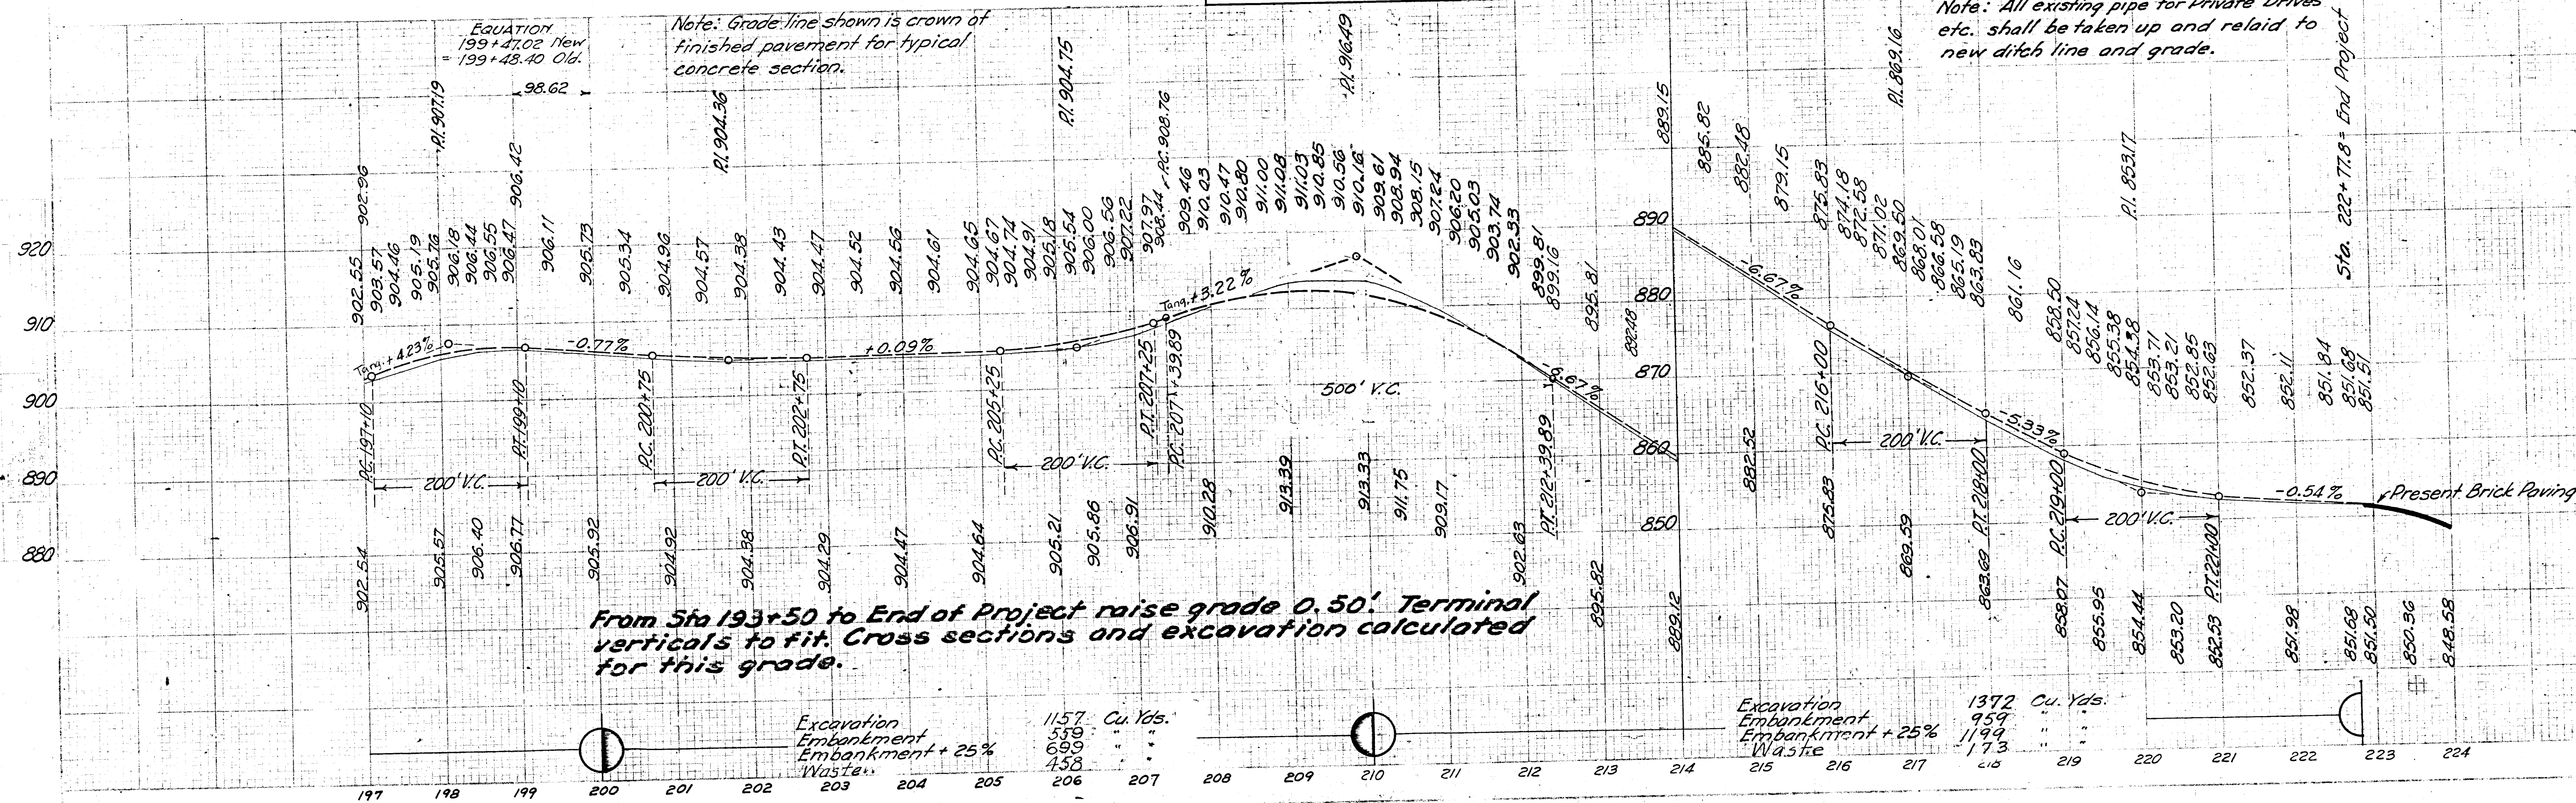

From Sta 193+50 to End of Project raise grade 0.50'. Terminal verticals to fit. Cross sections and excavation calculated for this grade.

Excavation
Embankment + 25%
Waste

Excavation
Embankment + 25%
Waste

1372 Cu. Yds.
959
1194
173