MUSKINGUM COUNTY
TOWNSHIP ROAD NO.607

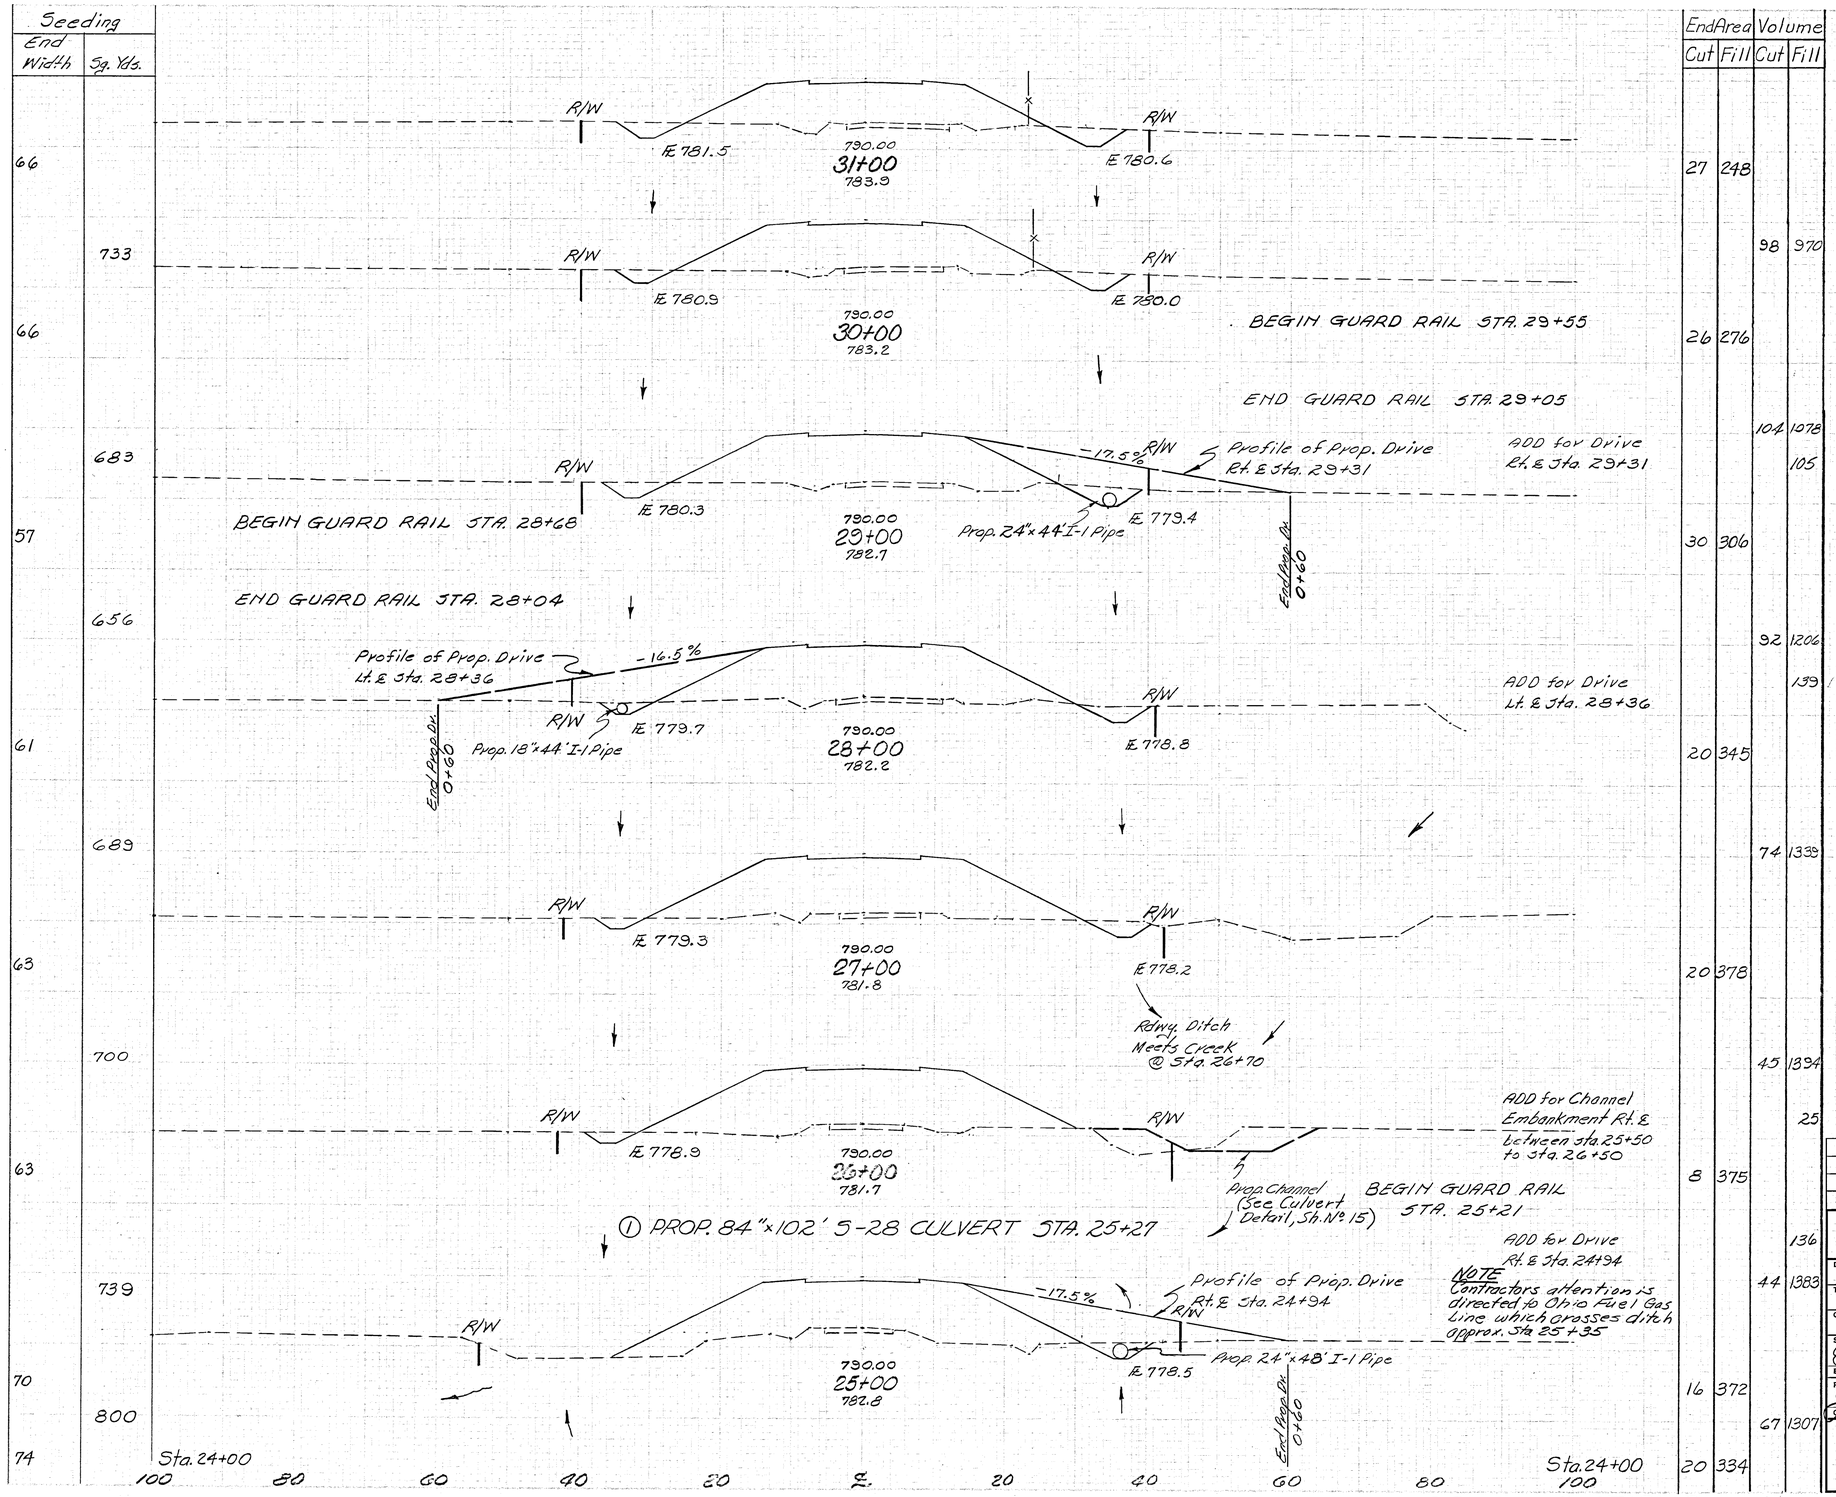

End Width	Sq. Yds.	Cut	Fill	Cut	Fill
66		27	248		
	733			98	970
66		26	276		
	683			104	1078
					105
57		30	306		
	656			92	1206
					139
61		20	345		
	689			74	1339
63		20	378		
	700			45	1394
				25	
63		8	375		
				136	
	739			44	1383
70		16	372		
	800			67	1307
74		20	334		

REVISION	DATE	DESCRIPTION	BY
	3/23/62	AS CONSTRUCTED	H.F.K.

U. S. ARMY ENGINEER DISTRICT, HUNTINGTON
CORPS OF ENGINEERS
HUNTINGTON, W. VA.

DRAWN BY: H. I. Z.
TRACED BY:
CHECKED BY: FCW
SUBMITTED BY: Elmer S. Barrett
ELMER S. BARRETT ASSOCIATES
RECOMMENDED: James W. Barnes
CHIEF ENG. DIV.
APPROVED: A. J. Sidman
COL. C.E., DISTRICT ENGINEER

LICKING RIVER
DILLON RESERVOIR PROJECT
READJUSTMENT OF
TOWNSHIP ROAD NO. 607
(MT-607-1)

DATE: AUGUST 1959

ELMER S. BARRETT ASSOCIATES
CONSULTING ENGINEERS
CHILLICOTHE, OHIO

SCALE: 1" = 10'
SPEC. NO.
DRAWING NUMBER
027f-UD9-68/13
SHEET 13 OF 16

WORK AS CONSTRUCTED CROSS SECTIONS — STA. 25+00 TO STA. 31+00