


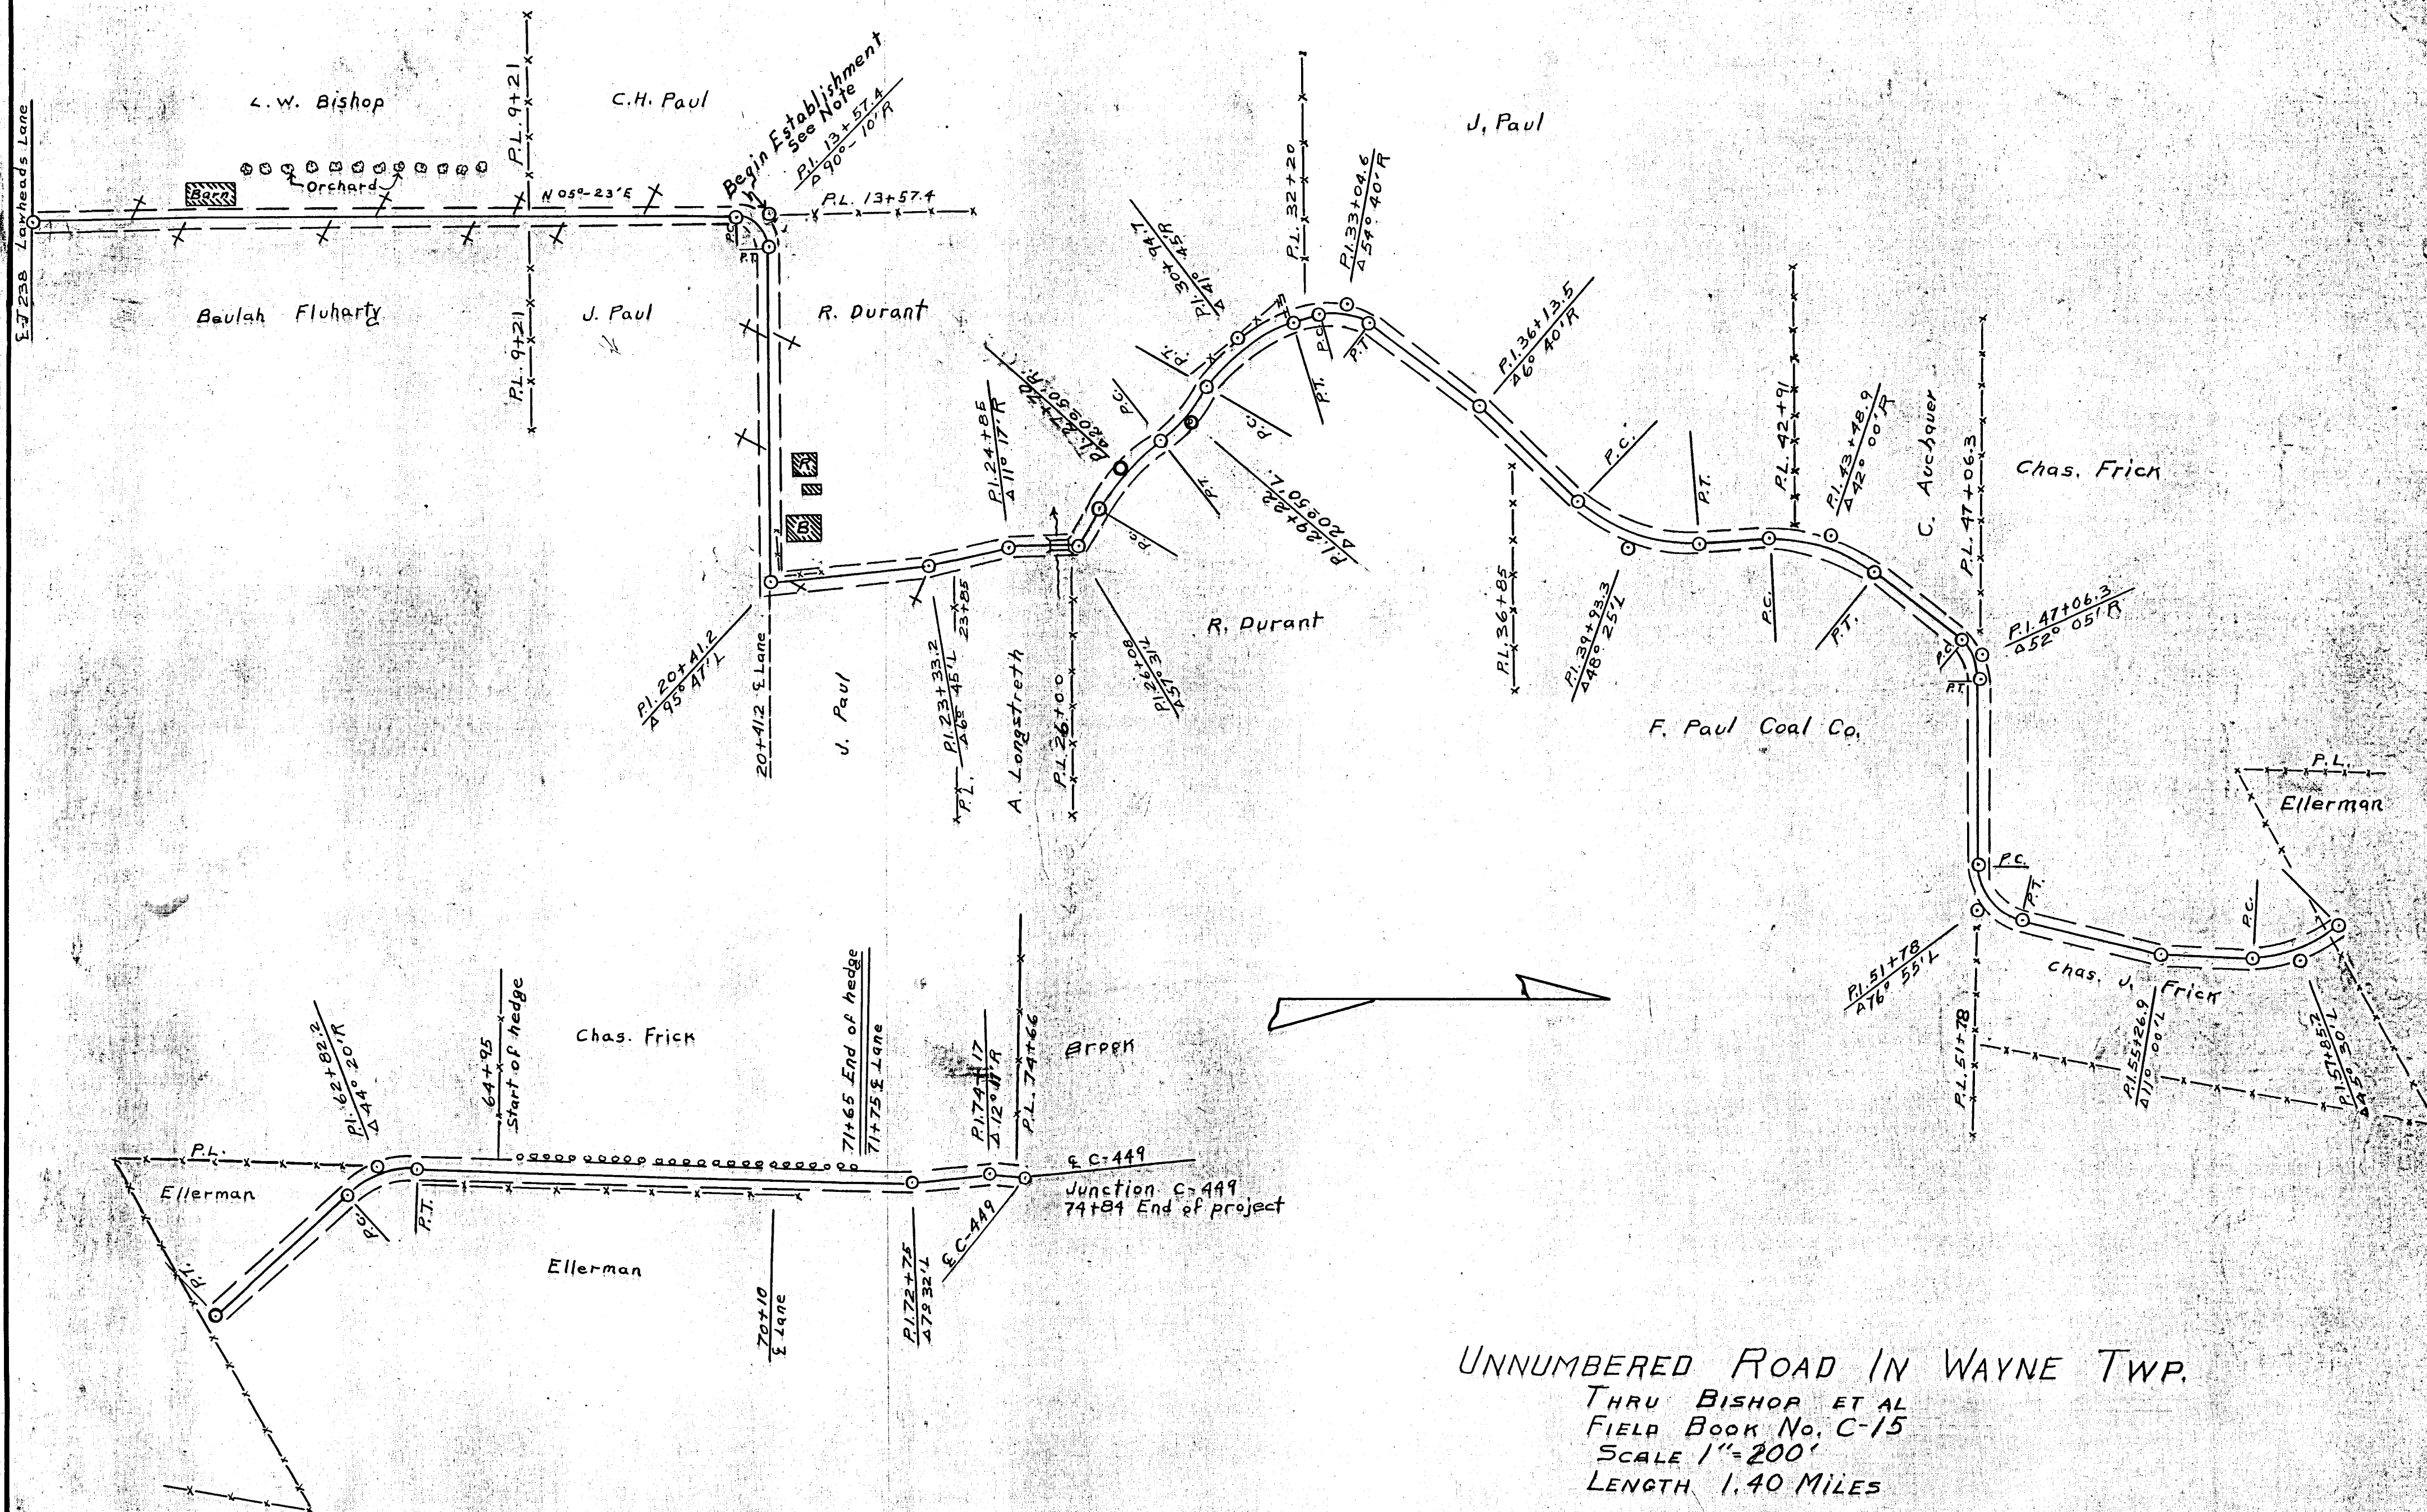

RESUBMITTED FOR APPROVAL FROM STA. 13+57.4 TO JUNCTION
WITH COUNTY ROAD 449, RIGHT OF WAY 30 FEET. 1.16 MILES
GIVEN TWP. RD. NO. 627

APPROVAL RECOMMENDED:

DATE Oct 5, 1948

John W. Alt
COUNTY ENGINEER

DATE Oct 6, 1948

Roy A. Baughman
COUNTY COMMISSIONERS

ROAD SURVEYED AS PETITIONED FOR
PETITION DISMISSED AT HEARING OF CLAIMS JUNE 24, 1946

UNNUMBERED ROAD IN WAYNE TWP.
THRU BISHOP ET AL
FIELD BOOK No. C-15
SCALE 1"=200'
LENGTH 1.40 MILES

DATE APPROVED May 15th 1946

COMMISSIONERS W. F. Heron

Roy A. Baughman

DATE APPROVED John W. Alt

May 15th 1946

MUSKINGUM COUNTY ENGINEER

T-127