

Received Dec 18, 1980 Time 2:18 P.M.
Recorded Dec 18, 1980
Plat Book 15 Page 101
Signed Donald M. Muck Recorder, Muskingum Co., Ohio
Fee \$ 8.75

CENTERLINE SURVEY PLAT

INTERSTATE ROUTE 70

MUS-70-21.31 MUSKINGUM COUNTY
UNION TOWNSHIP, T-1, R-5, SEC. 8, 9, 10, & 12

FED. RD. DIVISION	STATE	PROJECT
2	OHIO	

LIMITED ACCESS

MUS. 70 - 21.31

Plat Book 15
Pg. 101

The shaded area of this plan approved and accepted by us this 18th day of Dec. 19 80 for maintenance and public use

John E. Gibson Board of Commissioners of Muskingum Co., Ohio

I certify that the shaded area of this plan has been constructed according to the approved plan specification
Date: Dec 18, 1980

District Deputy Director

CURVE DATA

PI = STA 678+74.77
Δ = 21° 54' 00" LT.
D = 1° 00'
R = 5729.58'
T = 1108.53'
L = 2190.00'
E = 106.25'

C.H. 55 CURVE DATA


CURVE 1

PI = STA 22+26.75
Δ = 7° 30' 00" LT.
D = 8° 00' 00"
R = 716.20'
T = 46.94'
L = 93.75'
E = 1.54'

CURVE 2

PI = STA 31+64.64
Δ = 21° 40' 00" RT.
D = 6° 30'
R = 881.47'
T = 108.63'
L = 333.33'
E =


NOTES:
1. UPPER 6" TO BE FORMED
2. CONCRETE TO BE CLASS "C"
3. MONUMENTS TO BE SET BY CONTRACTOR

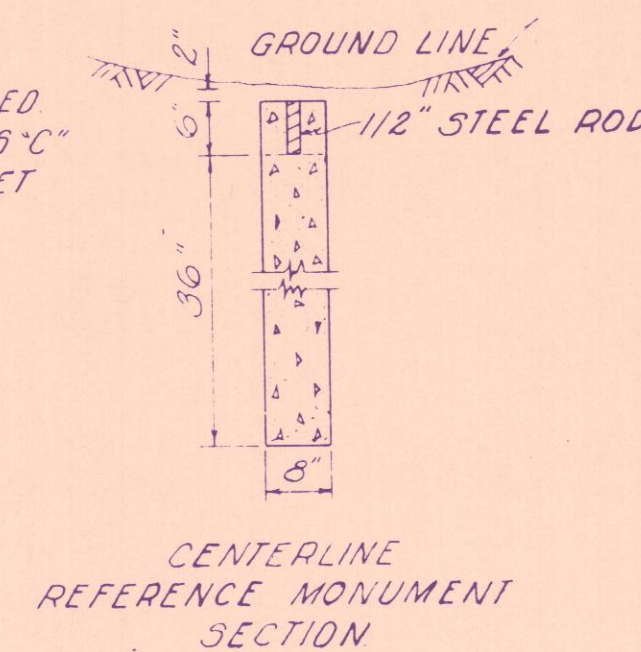

CURVE DATA

PI = STA 743+03.42
Δ = 23° 56' 00" LT.
D = 1° 28'
R = 3906.53'
T = 827.99'
L = 1631.82'
E = 86.78'

END PROJECT
MUS 70-21.31
STA. 746+00

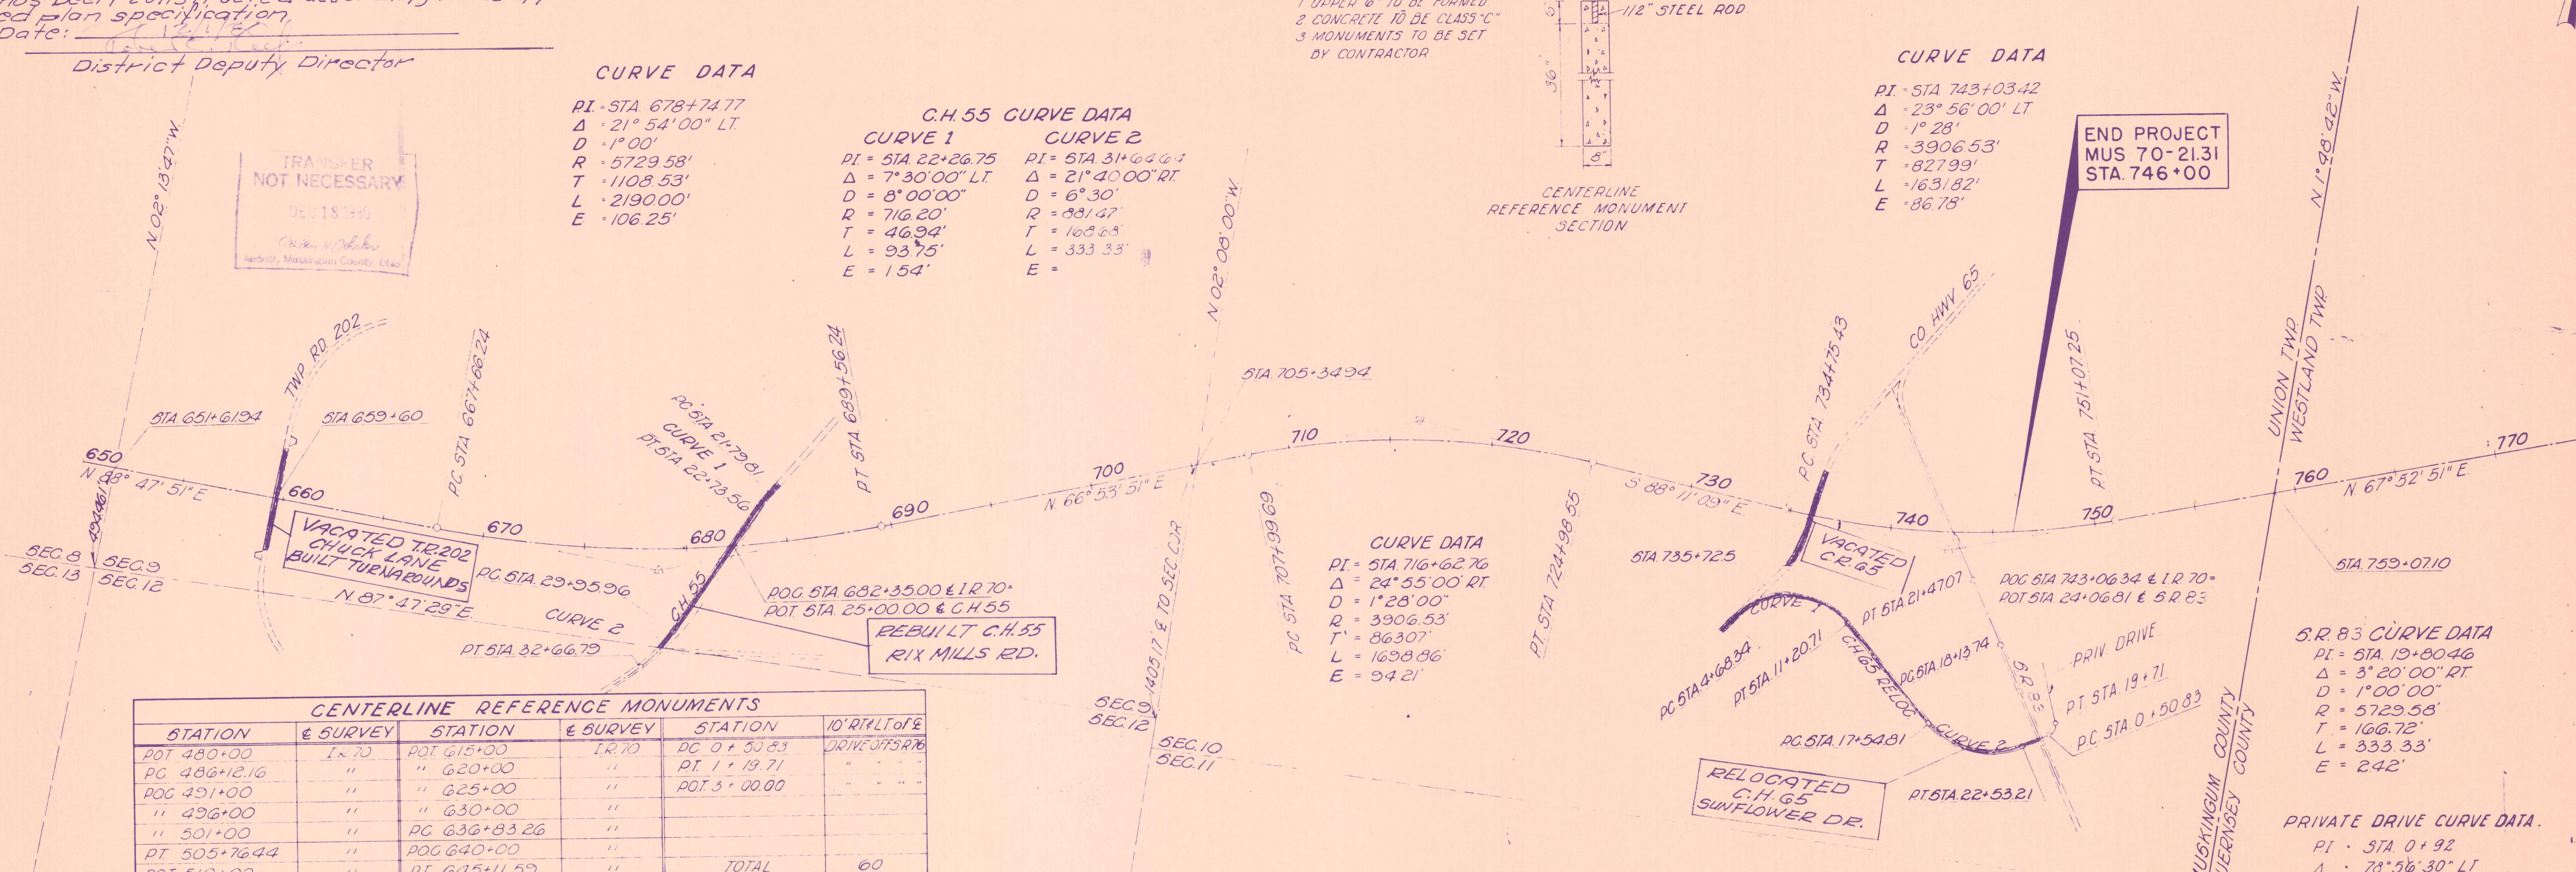

CENTERLINE REFERENCE MONUMENTS					
STATION	§ SURVEY	STATION	§ SURVEY	STATION	10' RT. LT. OF E
POT 480+00	IR 70	POT 615+00	IR 70	PC 0+50.83	DRIVE OFF SR 76
PC 486+12.16	"	" 620+00	"	PT 1+19.71	"
POC 491+00	"	" 625+00	"	POT 3+00.00	"
" 496+00	"	" 630+00	"	"	"
" 501+00	"	PC 636+83.26	"	"	"
PT 505+76.44	"	POC 640+00	"	TOTAL	60
POT 510+00	"	PT 645+11.59	"	"	"
" 515+00	"	POT 650+00	"	"	"
" 520+00	"	" 655+00	"	"	"
" 525+00	"	" 660+00	"	"	"
" 530+00	"	" 665+00	"	"	"
PC 534+63.60	"	PC 667+66.23	"	"	"
POC 540+00	"	POC 673+00	"	"	"
" 545+00	"	" 679+00	"	"	"
PT 549+59.05	"	" 685+00	"	"	"
POT 555+00	"	PT 689+56.24	"	"	"
" 560+00	"	POT 694+00	"	"	"
" 565+00	"	" 699+00	"	"	"
" 570+00	"	" 704+00	"	"	"
" 575+00	"	PC 707+99.69	"	"	"
" 580+00	"	POC 713+00	"	"	"
" 585+00	"	" 719+00	"	"	"
PC 591+33.16	"	PT 724+98.55	"	"	"
POC 595+00	"	POT 730+00	"	"	"
" 600+00	"	PC 734+75.33	"	"	"
" 605+00	"	POC 740+00	"	"	"
PT 610+16.43	"	" 745+00	"	"	"

CENTERLINE REFERENCE MONUMENTS WILL BE SET BEFORE OR AFTER CONSTRUCTION

MONUMENT ASSEMBLIES					
STATION	§ SURVEY	STATION	§ SURVEY	STATION	§ SURVEY
POT 18+00	CH 199	PC 14+57.39	CH 107	POT 10+00	SR 76
PC 20+57.80	"	PRC 16+24.89	"	" 14+00	"
PT 22+67.85	"	PT 20+78.22	"	PC 14+13.74	"
POT 24+15	"	POT 23+00	"	PT 14+47.07	"
PC 28+68.27	"	PC 27+13.39	"	POT 13+00	"
PT 30+48.13	"	PT 28+37.23	"	" 1+00	"
PC 41+97.57	CH 105	PC 1+85.64	CH 105 CONN	E 1+68.34	CH 65
PT 44+25.65	"	PT 5+30.97	"	" 1+20.71	"
PC 45+85	"	POT 18+50	CH 436	P 1+50	"
PT 47+85	"	" 24+00	"	P 1+54.81	"
POT 53+00	"	" 29+00	"	P 2+53.21	"
" 57+00	"	PC 34+08.42	"	"	"
" 58+50	"	PT 38+33.42	"	"	"
PC 62+98.96	"	PC 21+79.81	CH 55	"	"
PT 67+24.34	"	PT 22+73.56	"	"	"
POT 71+00	"	PC 29+95.96	"	"	"
				TOTAL	43

C.H. 65 CURVE DATA
CURVE 1
PI = STA 9+06.63
Δ = 97° 51' 18" RT.
D = 15° 00' 00"
R = 381.97'
T = 438.29'
L = 652.37'
E = 199.40'

CURVE 2
PI = STA 20+46.64
Δ = 74° 45' 38" LT.
D = 15° 00' 00"
R = 381.97'
T = 291.83'
L = 498.40'
E = 98.72'

S.R. 83 CURVE DATA
PI = STA 19+80.46
Δ = 3° 20' 00" RT.
D = 1° 00' 00"
R = 5729.58'
T = 166.72'
L = 333.33'
E = 242'

PRIVATE DRIVE CURVE DATA.
PI = STA 0+92
Δ = 78° 56' 30" LT.
D = 114° 35' 29"
R = 50'
T = 41.17'
L = 68.88'
E = 14.77'

I hereby certify that this is a true delineation of a survey made for the Ohio Department of Highways in 1962 by RACKOFF ASSOCIATES.
David S. Guthrie
Date Feb. 17, 1964
Registered Surveyor No. 4378

COMPLETION DATE. FEB. 17-64	
REV. DATE.	DESCRIPTION.