

Received Dec 18, 1980 Time 2:20 P.M.
 Recorded Dec 18, 1980
 Plat Book 15 Page 103
 Signed Will M. Quick Recorder, Muskingum Co., Ohio
 Fee \$8.25

The shaded area of this plan approved and
 accepted by us this 13th day of October 1980
 for maintenance and public use.

President, City Council of Zanesville, Ohio


I certify that the shaded area of this plan
 has been constructed according to the approv-
 ed plan specification.

Date: 12/1/80
Will M. Quick
 District Deputy Director



I find that the section of road shown by the
 shaded area has been constructed in a satis-
 factory manner and is in good repair.

Date: October 20, 1980
Will M. Quick
 Director of Public Services

LOCATION PLAN MUS.~70~10.65,11.52,11.78 INTERSTATE~70 CITY OF ZANESVILLE

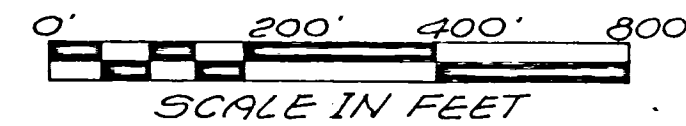

LIMITED ACCESS

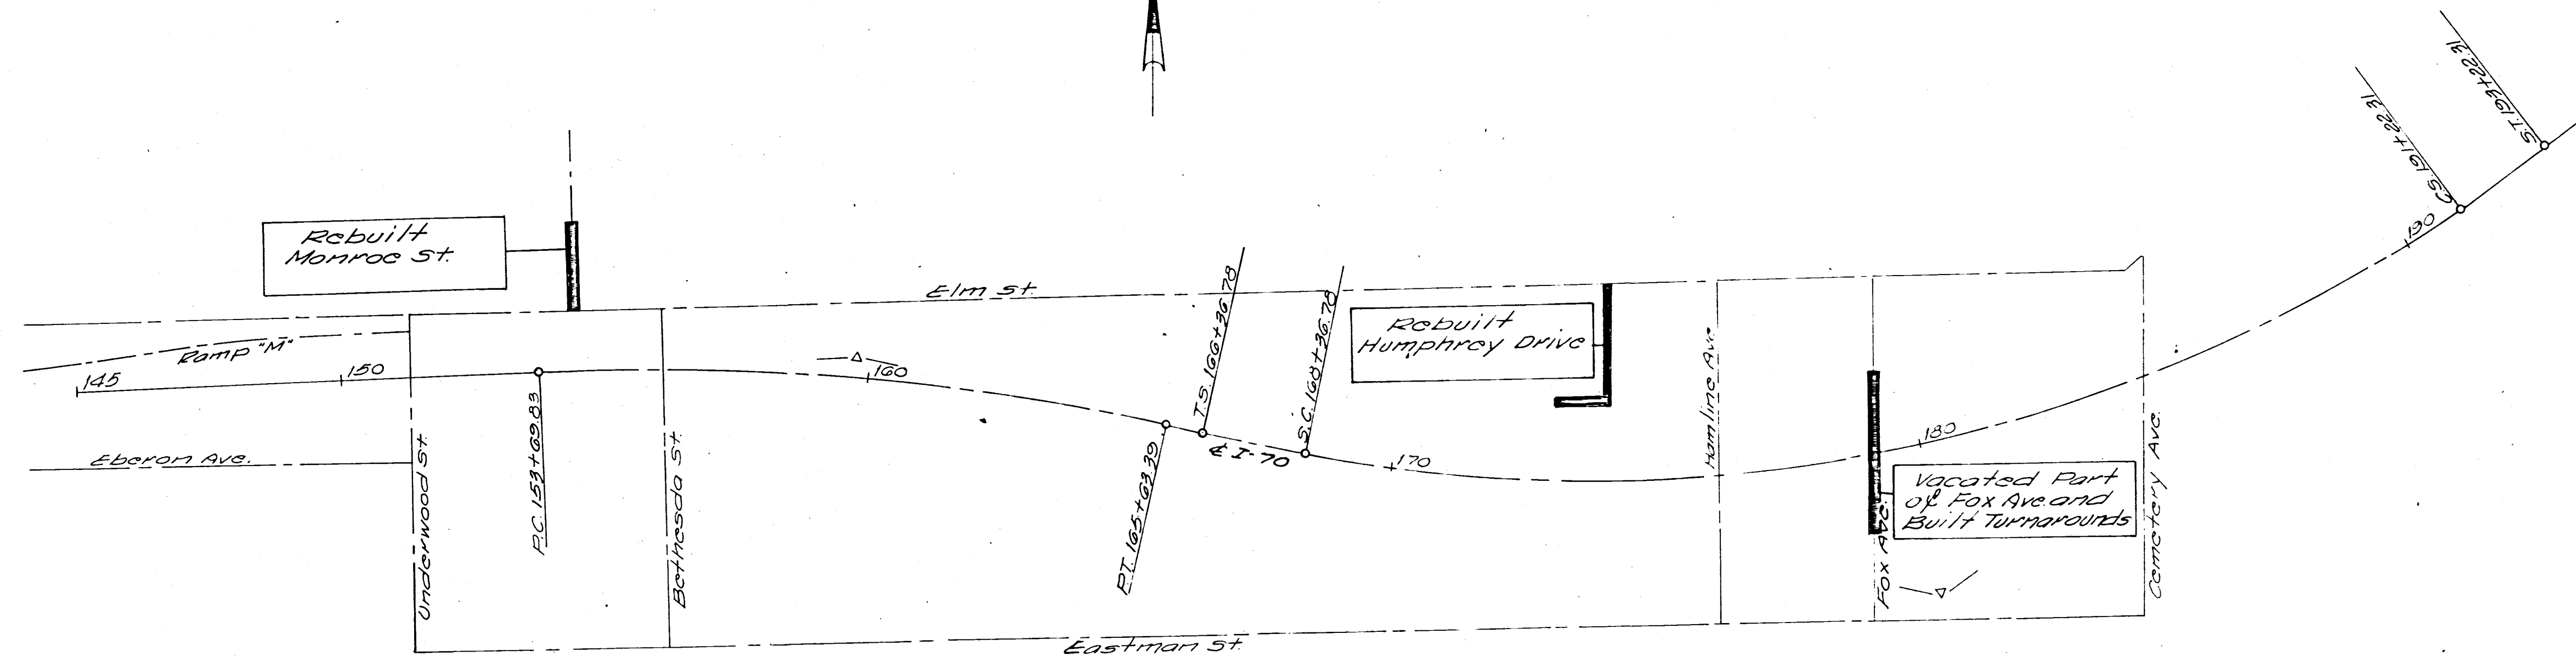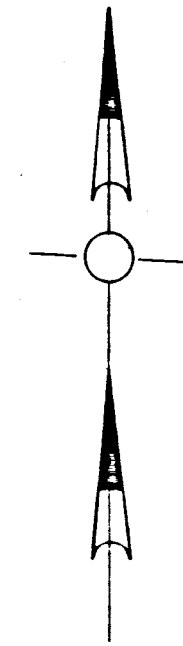

CURVE DATA

	I-70	I-70
PI	159+70.00	180+61.12
Δ	14°55'10"	42°42'33"
DC	1'15'00"	2'00'00"
R	4583.56'	2364.79'
Ls	200.00'	200.00'
Os	2'00'00"	2'00'00"
Ts	1427.34'	1427.34'
Eor Es	39.13'	293.03'
Lc	1193.56'	2285.53'
S	0.031'	0.0471'
Xc	192.98'	192.98'
Yc	2.33'	2.33'
Tc	600.17'	600.17'

FHWA REGION	STATE	PROJECT
5	OHIO	

MUSKINGUM COUNTY
 MUS.~70~10.65,11.52,11.78

Plat Bk. 15
 Pg. 103