

Muskingum Co. Perry Twp.
Sec. 12 1st Qtr. T-1 R-6 U.S.M.L.


FED. RD. DIVISION	STATE	PROJECT
2	OHIO	

363

16
23

MUS-70-17.74
R/W PLAN
LIMITED ACCESS
(Formerly Mus-40-18.01)

Railroad Curve Data
Δ = 68°25' Rt.
D = 4°41'
Lc = 1198.3'
Ls = 262.5'

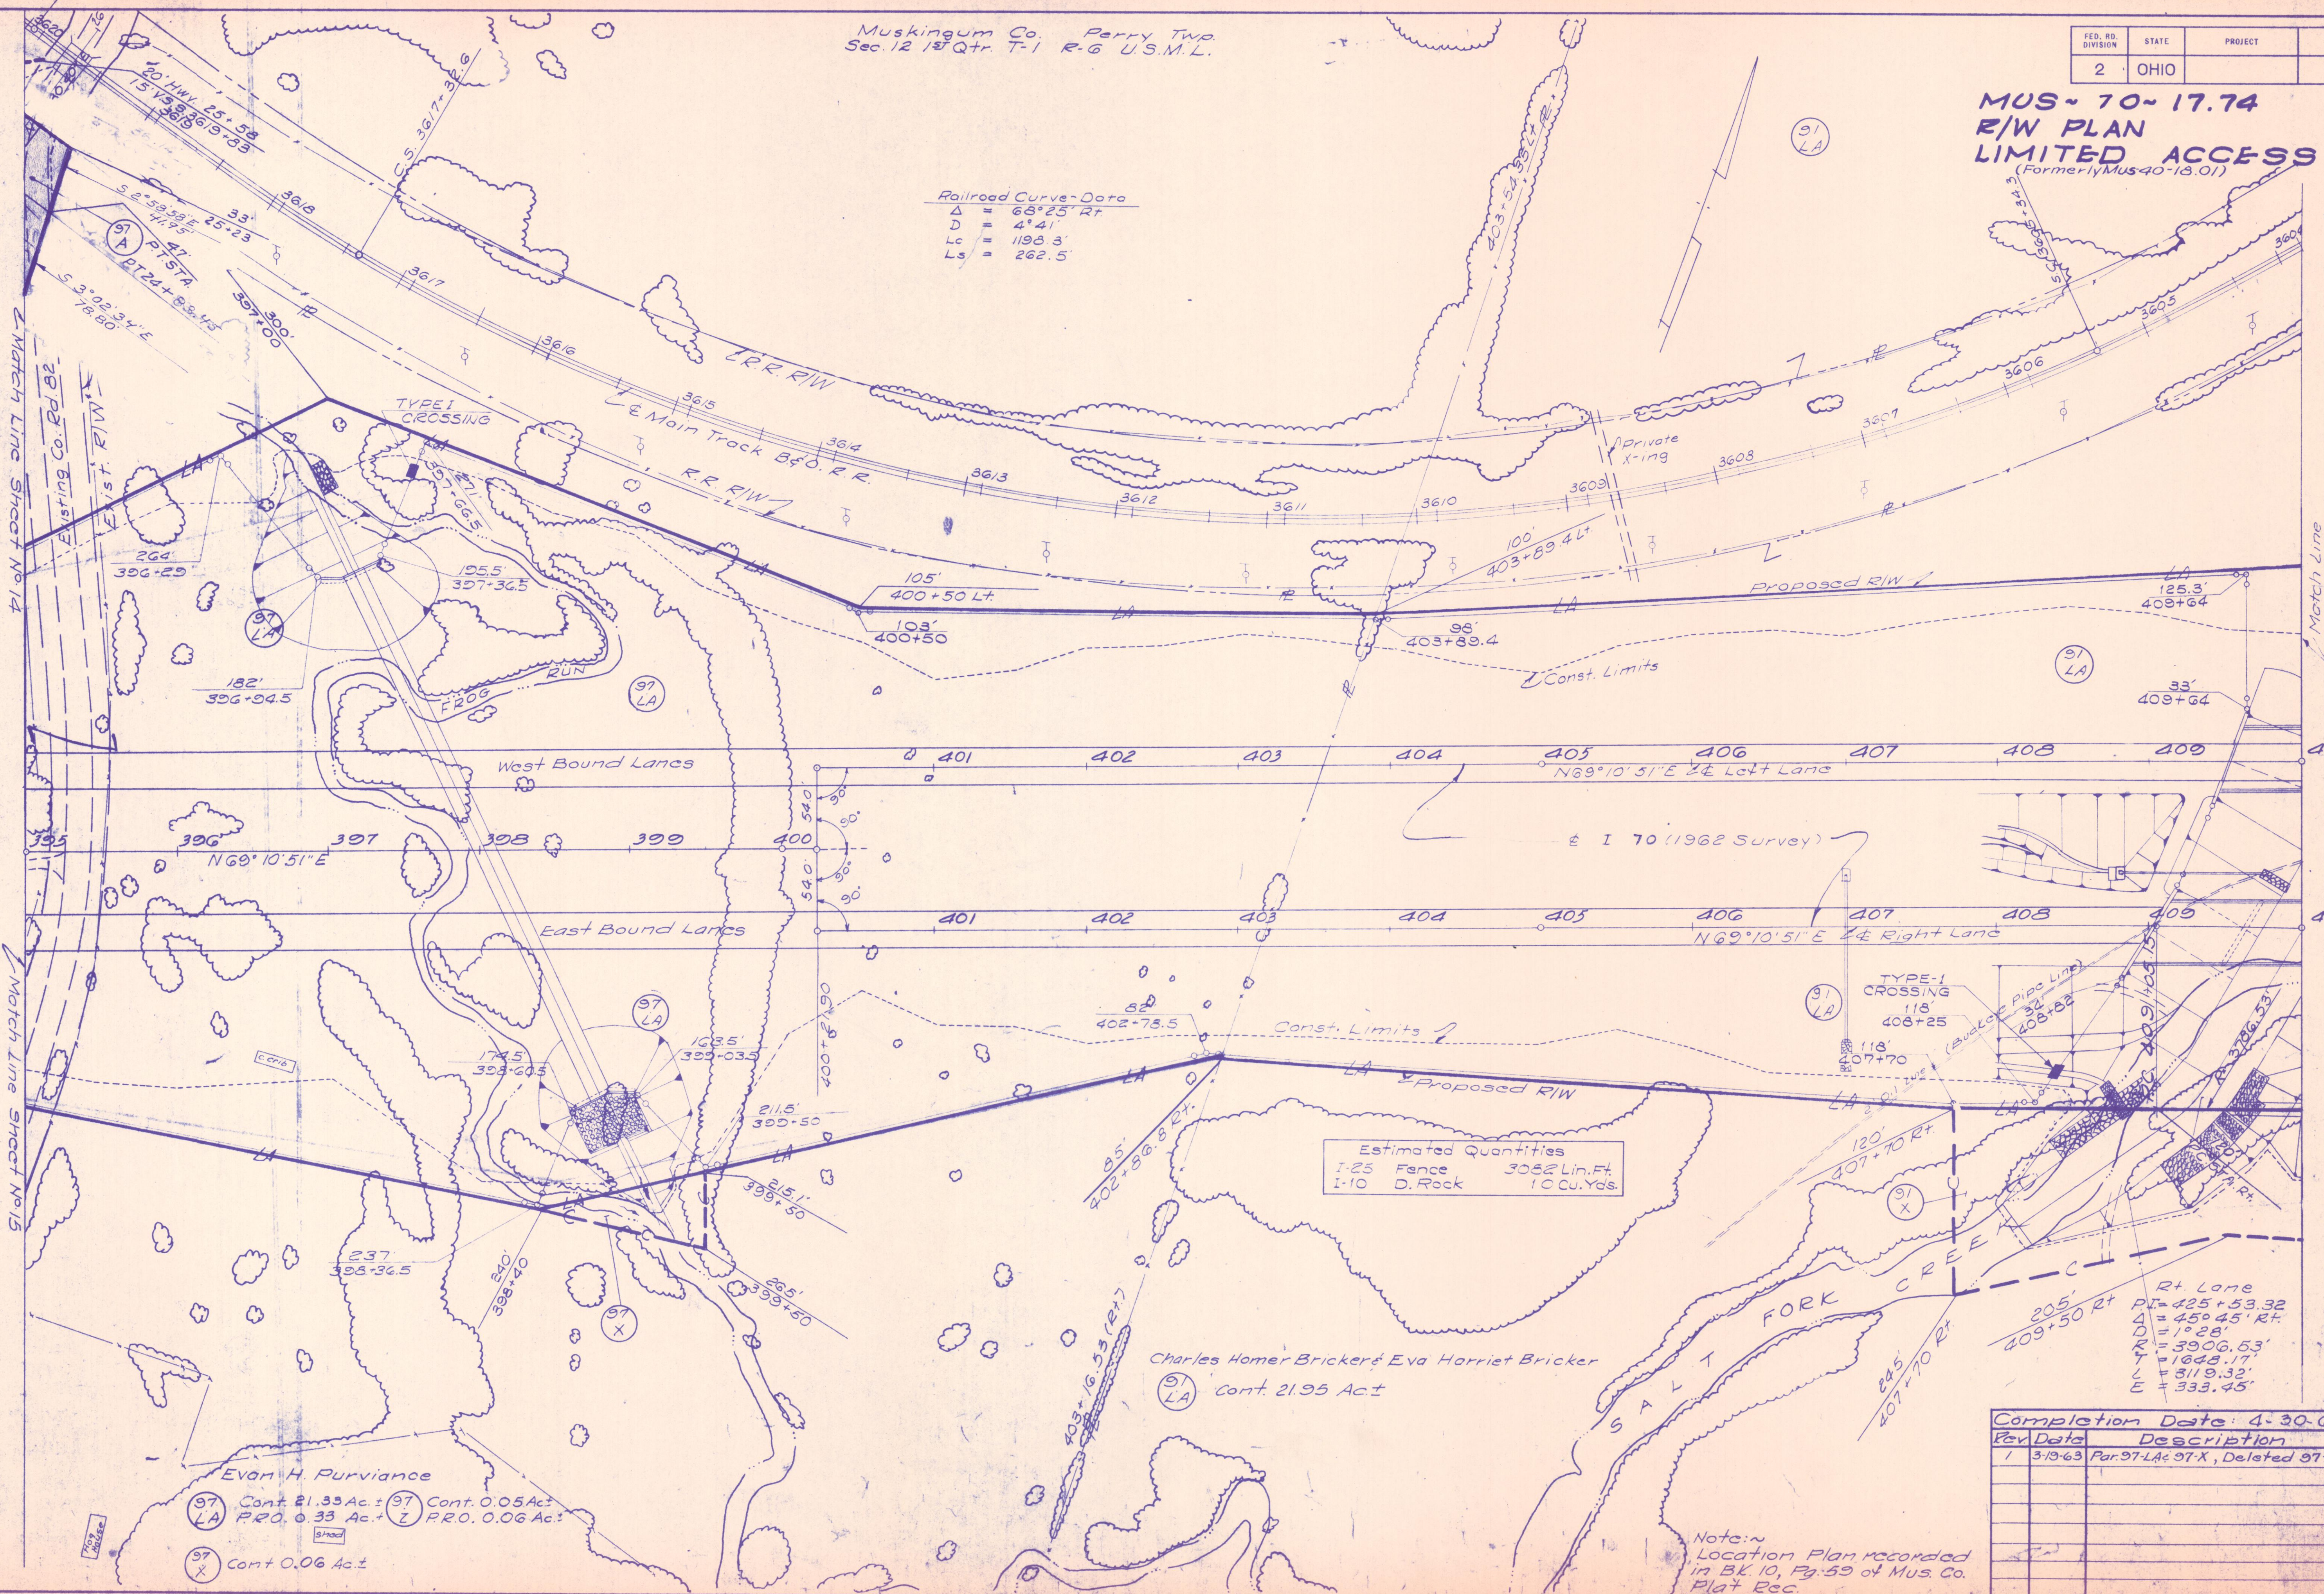

Estimated Quantities
1-25 Fence 3052 Lin. Ft.
1-10 D. Rock 10 Cu. Yds.

Rt. Lane
PT = 425+53.32
Δ = 45°45' Rt.
D = 1°28'
R = 3906.53'
T = 1648.17'
L = 5119.32'
E = 333.45'

Completion Date: 4-30-62

Rev	Date	Description
1	3-13-63	Par. 97-LA & 97-X, Deleted 97-Y

Note: Location Plan recorded in BK 10, Pg. 59 of Mus. Co. Plat Rec.

Evan H. Purviance
97 LA Cont. 21.35 Ac. ±
97 LA P.R.O. 0.33 Ac. ±
97 X Cont. 0.06 Ac. ±
97 LA Cont. 0.05 Ac. ±
97 Z P.R.O. 0.06 Ac. ±

Charles Homer Bricker & Eva Harriet Bricker
97 LA Cont. 21.95 Ac. ±