



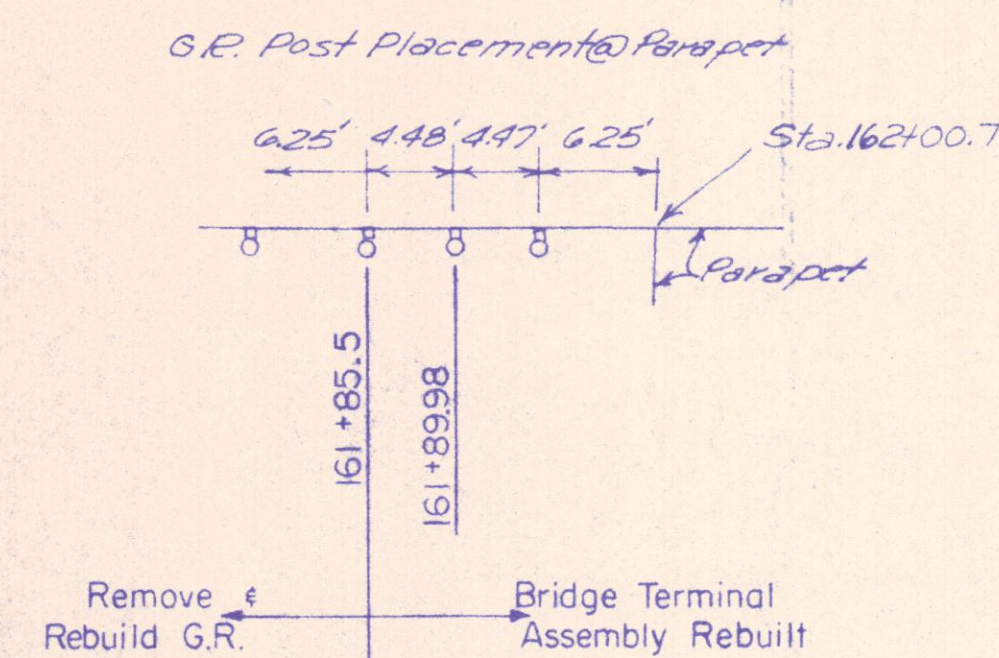

BM. □ Top NE. Corner
SW. Conc. Wing Wall
Br. MU5-70-16.05 R
79.5' Rt. Sta. 162+00 L
Elev. 883.70

Excavation	6411 C.Y.
Embankment	5629 C.Y.
Seeding & Mulching	3450 S.Y.

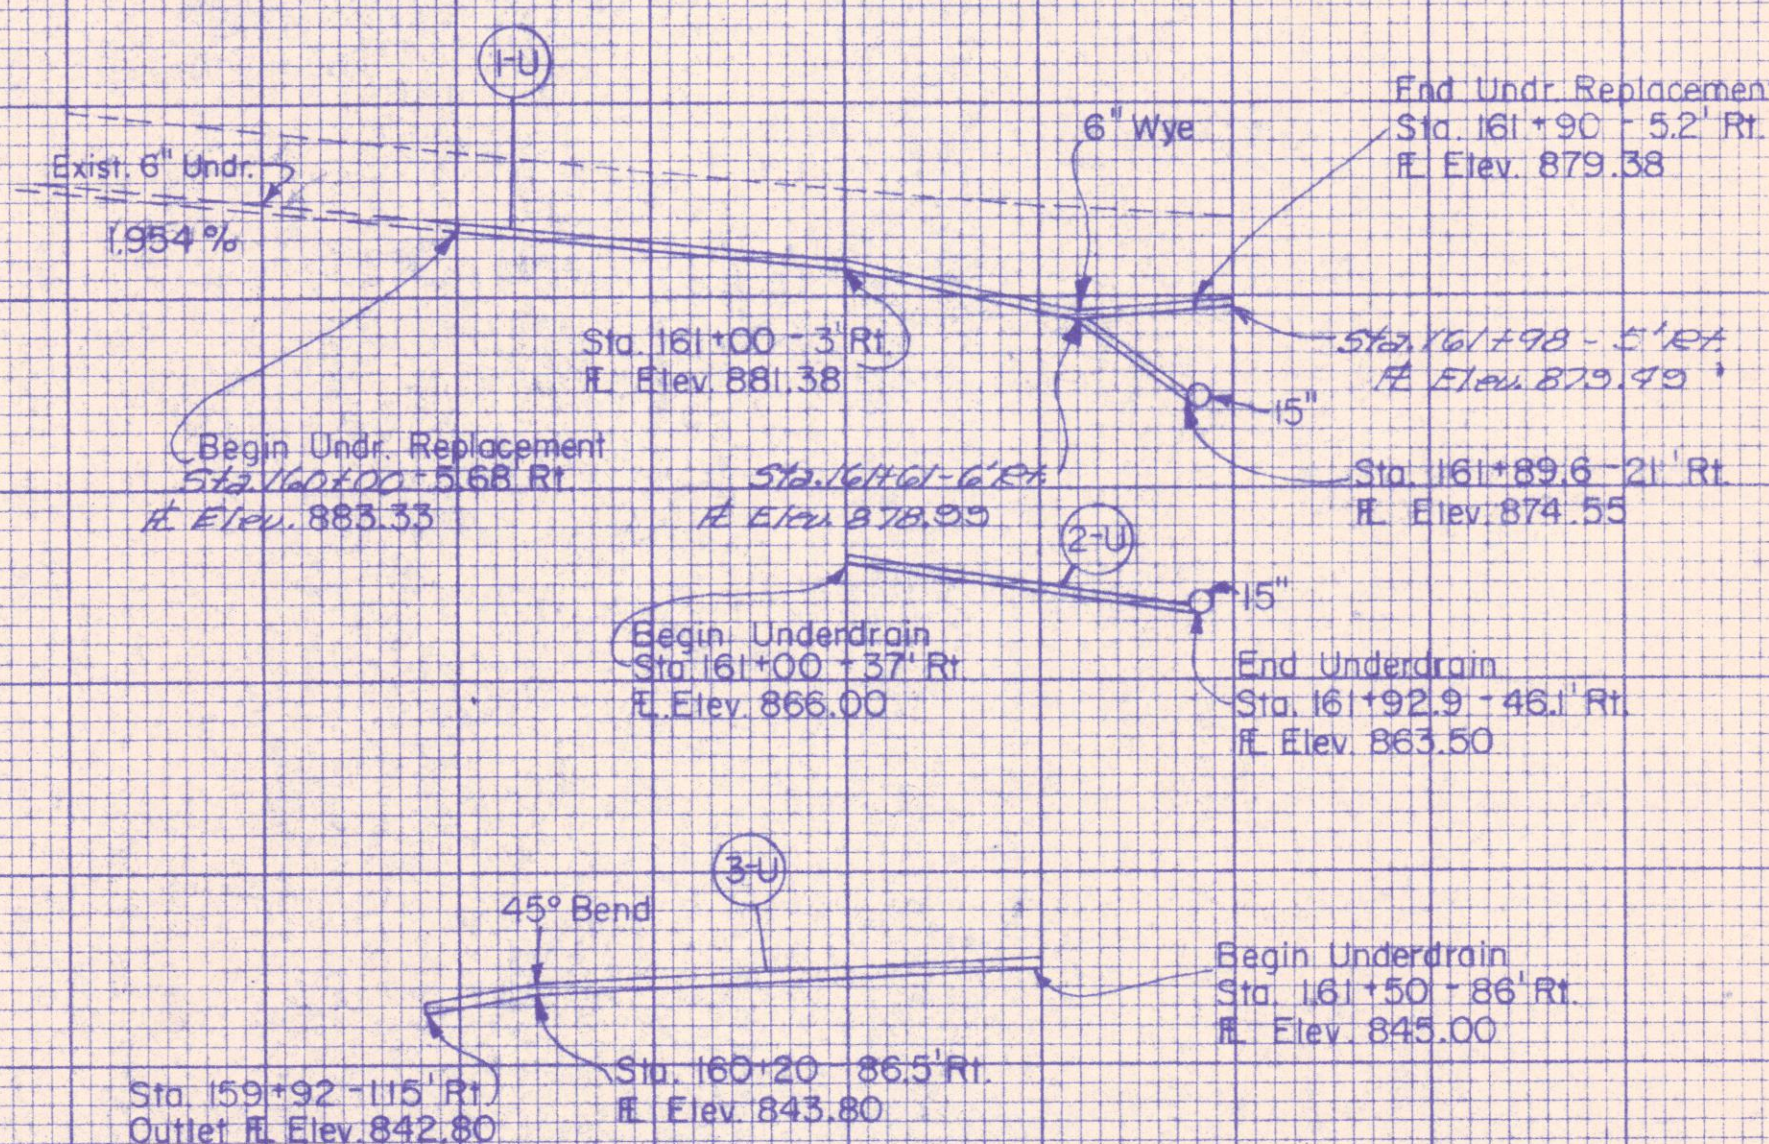

ESTIMATED QUANTITIES																						
REF. NO.	STATION TO STATION	SIDE	625	625	625	625	625	625	625	625	625	625	625	625	625	625	625	625	625	625	625	606
			Light Pole Foundation	Guard Rod	NEQAMG Pole and Bracket Cable	Trench	1 1/2" Duct Cable w/ 2 NE4AMG 600V Cables	Light Pole Erection	Type AT-X Transformer Base	Connector Kit, Type III	6" Pipe Underdrains	Conduit, Type F	15" Cond Bend	15" x 6" Connect Tee	Rock Core Drill Bit Washed	Pipe 24" x Under	Conc. Masonry	Dump Rock Fill Type C	Fence Removed for Reuse	Guardrail Rebuilt, Type 5	Fence Type 47	Bridge Terminal Rebuild, Type C
			Each	Each	Lin. Ft.	Each	Each	Each	Each	Each	Each	Each	Each	Each	Each	Each	Each	Each	Each	Each	Each	
I-L 2-L	158 + 54 - 161 + 43 161 + 43	Rt. Rt.	1	1	90	289	299	1	1	1												
I-G 2-G	158 + 48 - 161 + 85.5 161 + 85.5 - 162 + 00.7	Rt. Rt.															337.5	337.5			1	
I-F 2-F	159 + 00 - 161 + 50 159 + 00 - 161 + 97	Rt. Rt.															210			430		
I-U 2-U 3-U	160 + 00 - 161 + 90 161 + 00 - 161 + 78.7 159 + 92 - 161 + 50	Rt. Rt. Rt.							222 93 155	1	10											
I-R 2-R I-R	159 + 20 - 159 + 55 161 + 96 - 161 + 00 CR 161 + 89 - 161 + 98.7 161 + 81 - 161 + 89	Rt. Rt. Rt.														43						
TOTAL S			1	1	90	289	299	1	1	1	1	10	82	6	66	.27	43	210	337.5	337.5	430	1
</																						