

SEE TAX SHEET N^o
G-14-C-2


R.14 W. NORTH EAST QTR. OF SECTION 13 T.16 N.
R.13 W. NORTH WEST QTR. OF SECTION 15 T.12 N.

CORP. LINE
CITY OF ZANESVILLE
SPRINGFIELD TWP.

CHESIE SYSTEM
R/R

R/W & CORP. LINE

CITY OF ZANESVILLE
~~249-345~~
467-308 (Par #1)
20.69

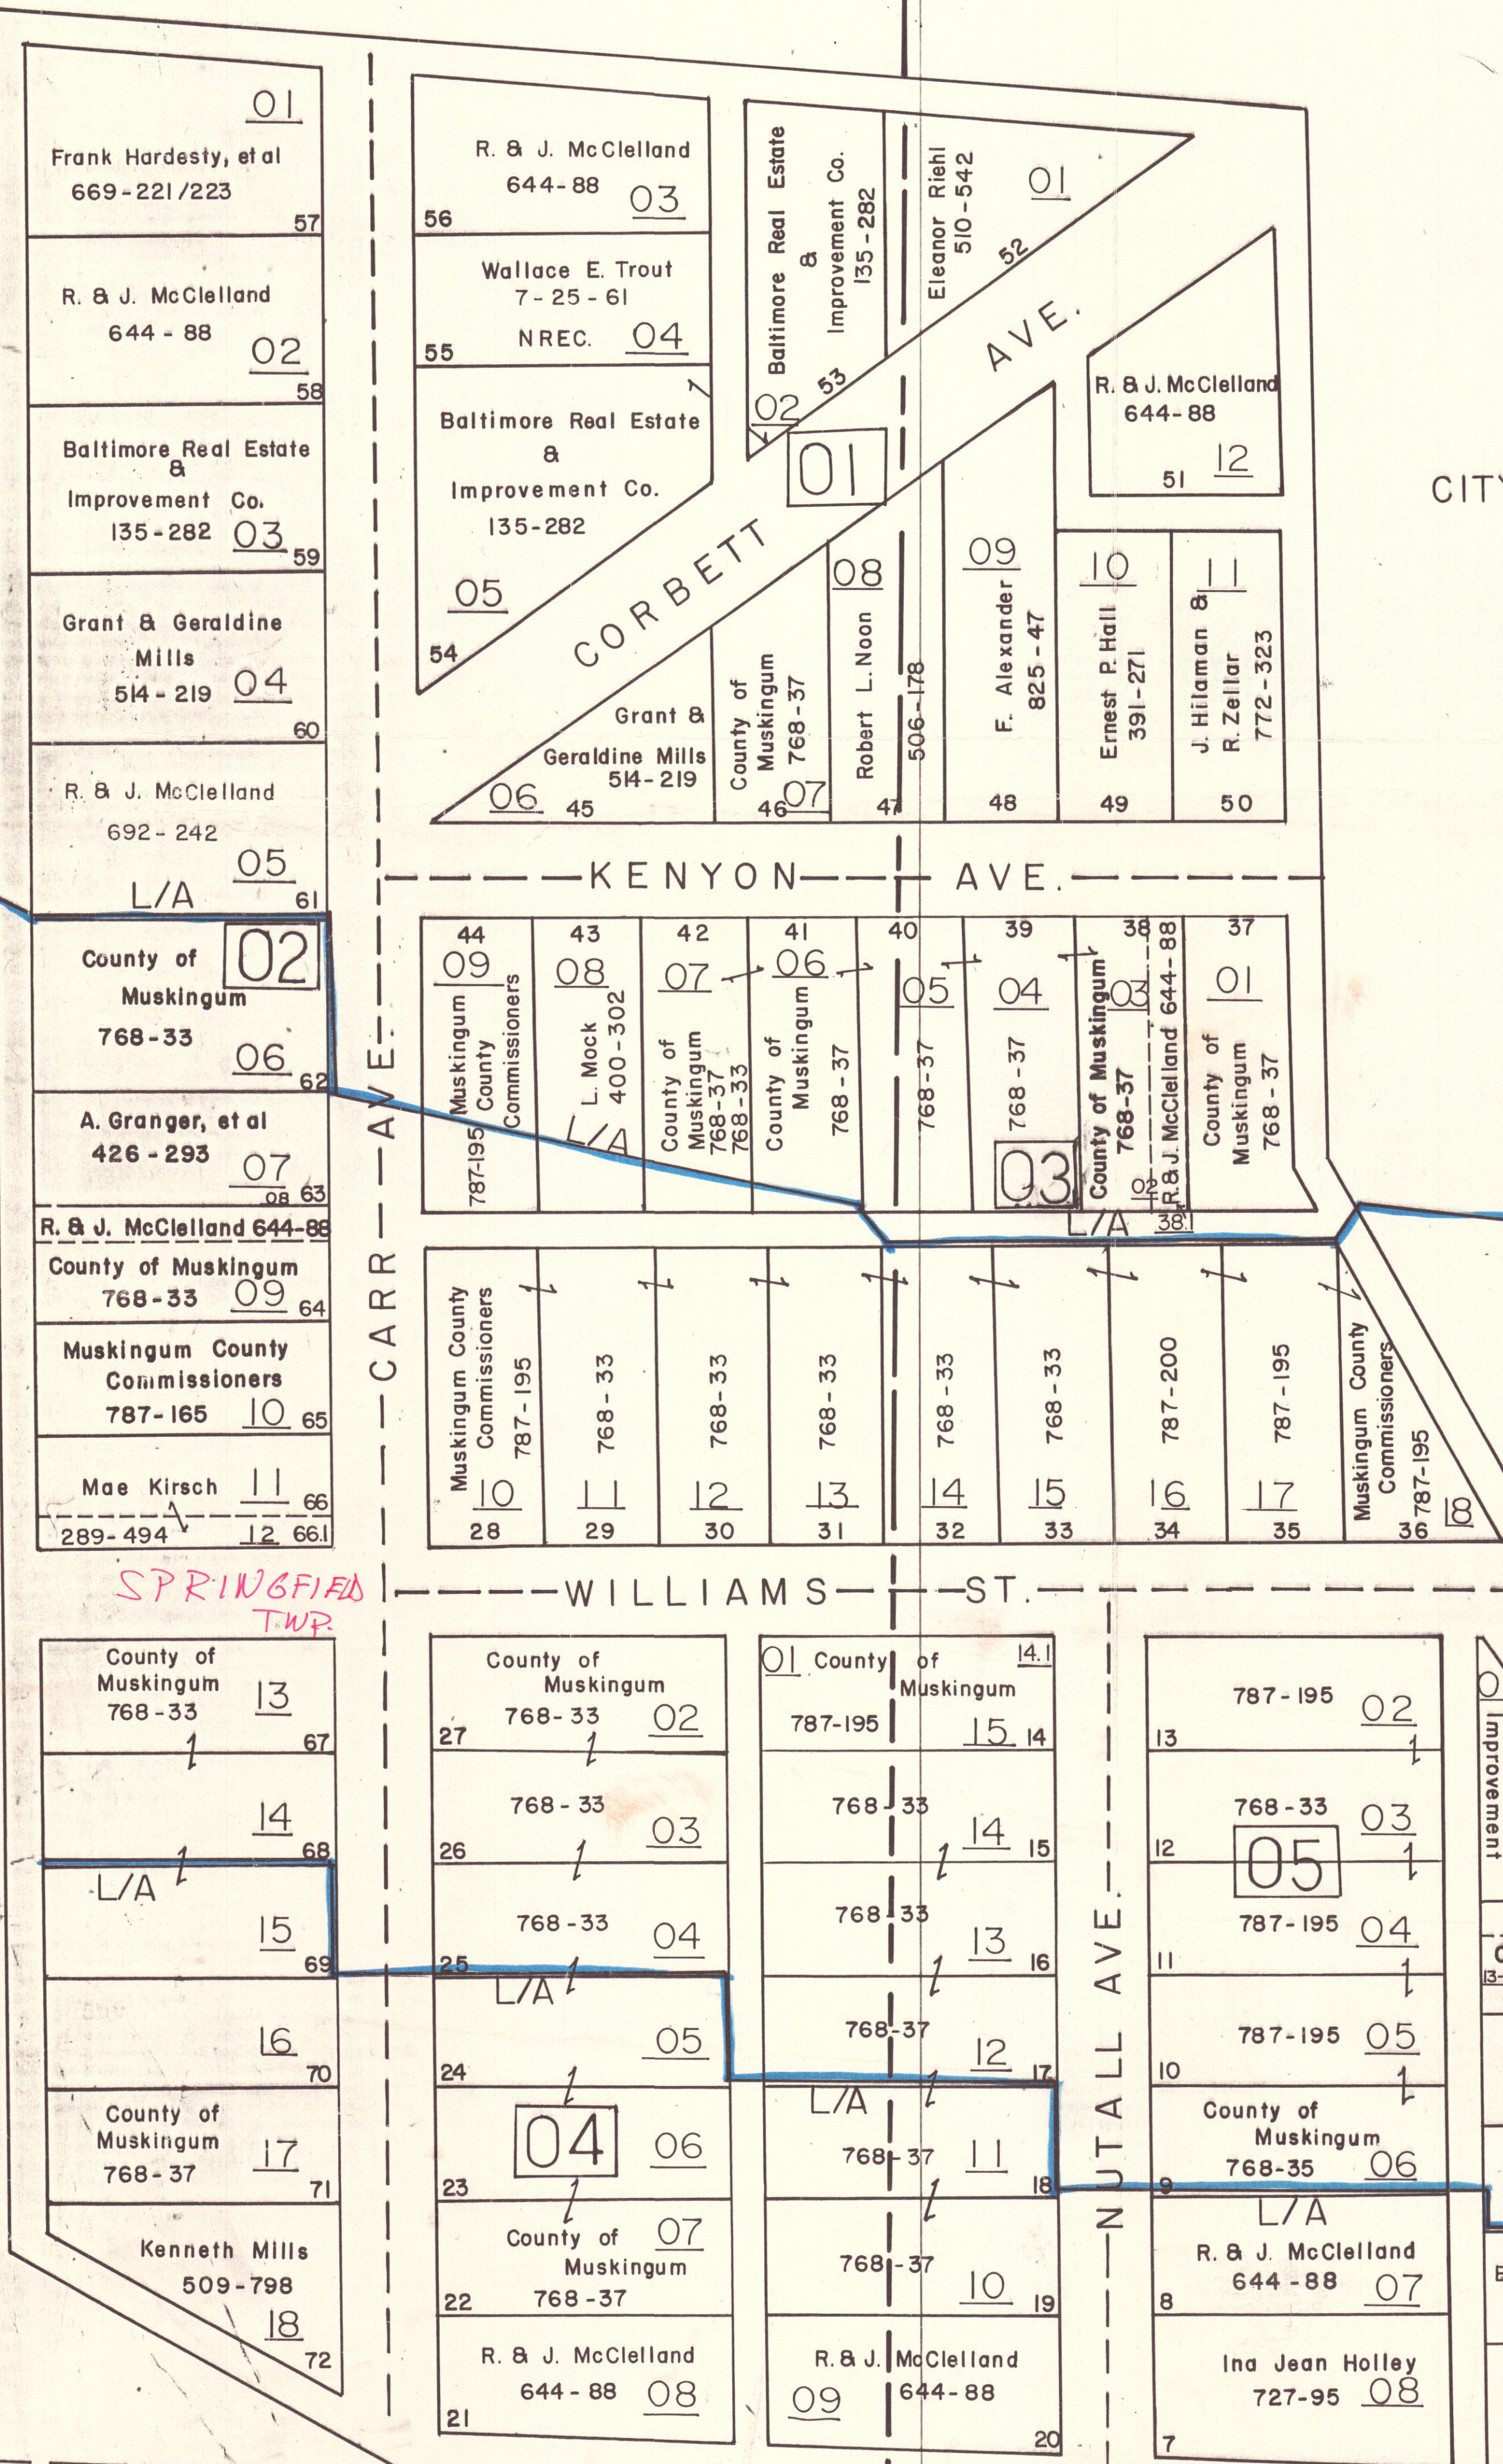

L/A

L/A

NOT OPEN

TO NEW S.R. 555 BRIDGE

SPRINGFIELD TWP.

CITY OF ZANESVILLE

CITY OF ZANESVILLE
SPRINGFIELD TWP.

467-308
(Par #1)

NORTH WEST QTR. SEC. 15
SOUTH WEST QTR. SEC. 15

SPRINGFIELD TWP.
SPRINGFIELD TWP.

CORP. LINE

OCT. 1985
UPDATED
D. L.

NORTH WEST QTR. SEC. 15 T.12 N. R.13 W.
CORP. LINE SEE CITY OF ZANESVILLE
TWP. LINE SEE SPRINGFIELD TWP.
SOUTH WEST QTR. SEC. 15 T.12 N. R.13 W.
UPDATED THRU 7-1-83

(15)
GRAND VIEW SUB.
PLAT BOOK 3 PAGE 90

LOREN C. CAMP P.E.
COUNTY ENGINEER

SCALE
1" = 50'

SHEET INDEX
SEE CITY OF ZANESVILLE
62-56 SEE WAYNE
62-58 TWP.

MUSKINGUM COUNTY, OHIO
GRAND VIEW NORTH WEST QTR. OF SECTION 15 T.12 N. R.13 W.
TWP. SPRINGFIELD

TAX SHEET N^o 62-57
REV. 5/21/86 RD