COUNTY ROAD NO. 72
DIETZ LANE DITCH
WAYNE TWP.
SCALE 1" = 50'

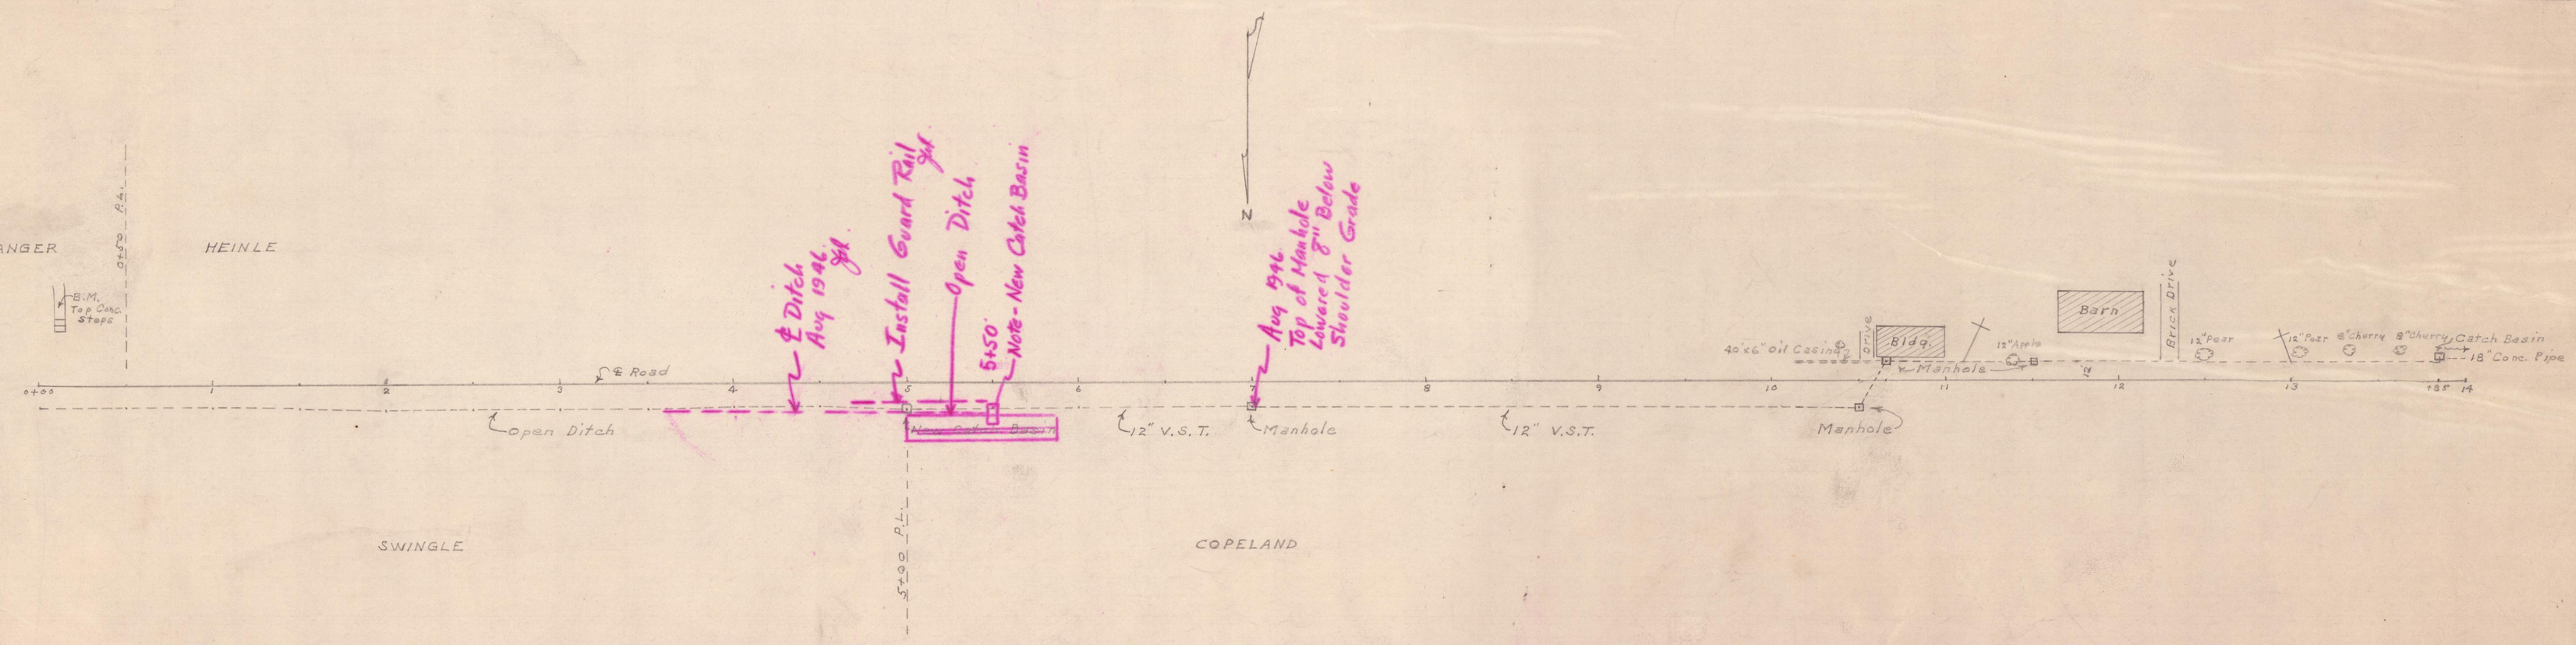


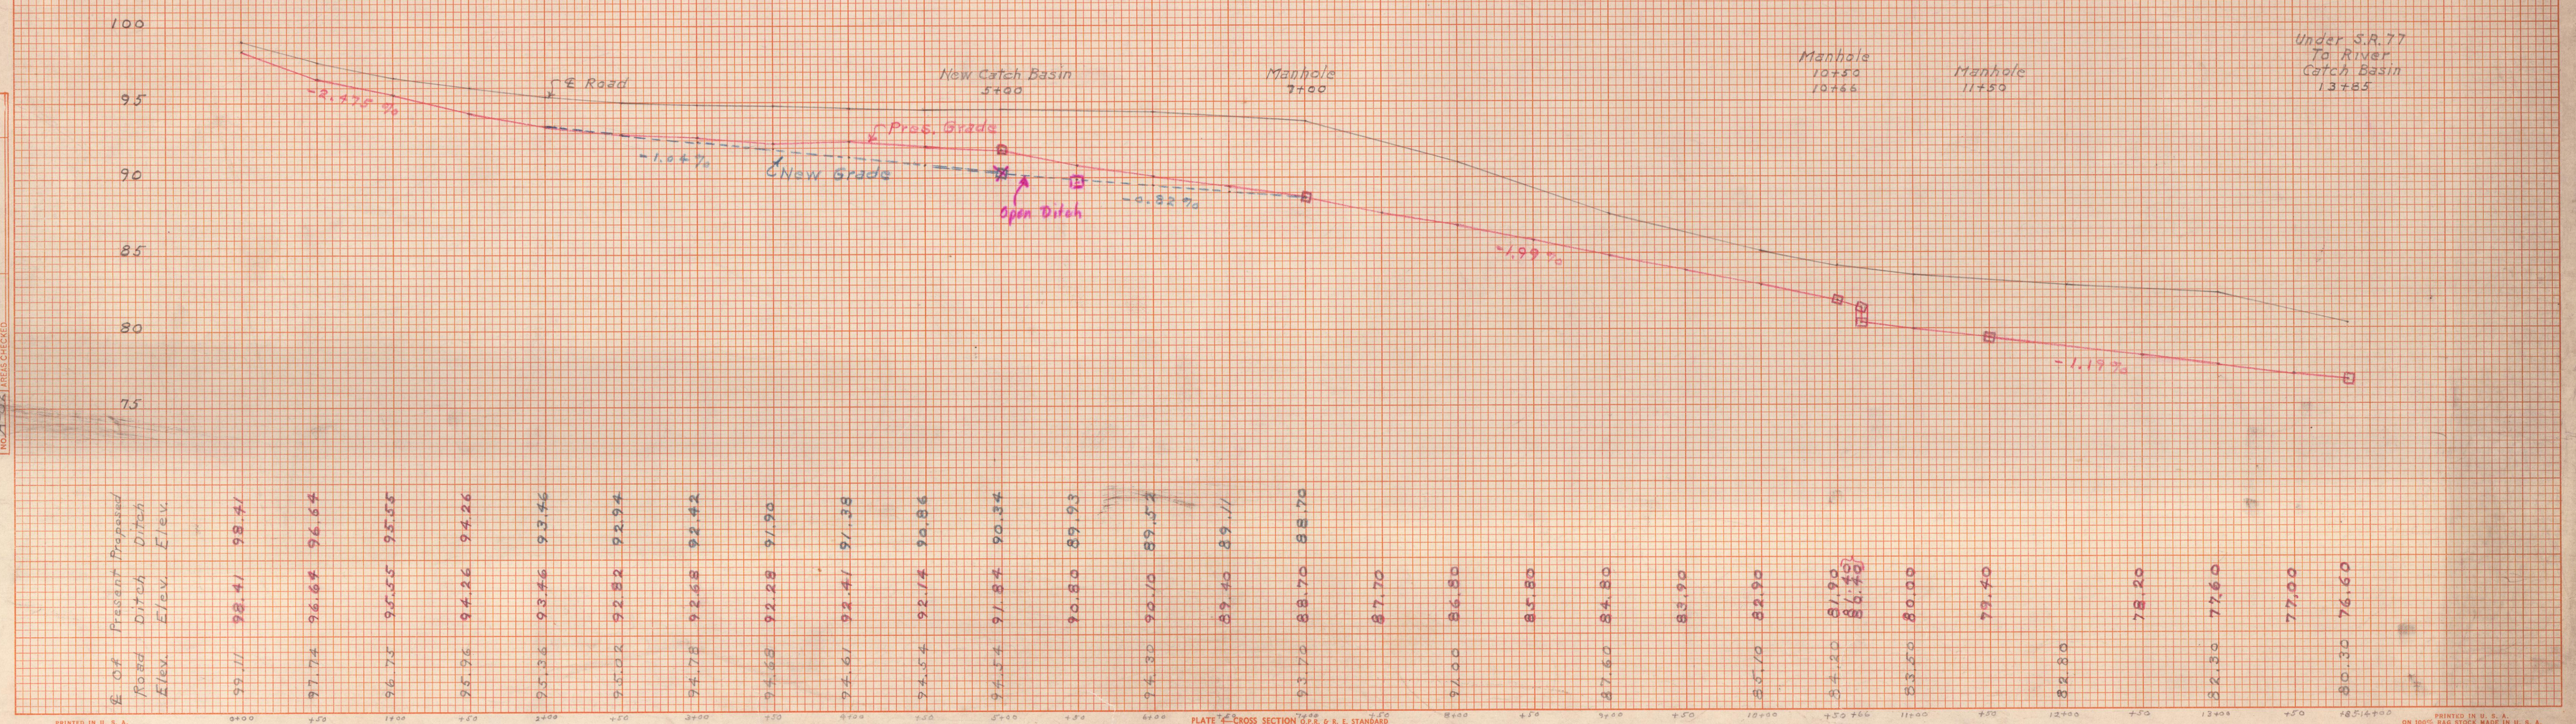


| | Present Ditch Elev. | Proposed Ditch Elev. | ℄ of Road Elev. |
|---|---|---|---|
| 0+00 | 98.41 | 98.41 | 99.11 |
| +50 | 96.64 | 96.64 | 97.74 |
| 1+00 | 95.55 | 95.55 | 96.75 |
| +50 | 94.26 | 94.26 | 95.76 |
| 2+00 | 93.46 | 93.46 | 95.36 |
| +50 | 92.94 | 92.82 | 95.08 |
| 3+00 | 92.42 | 92.68 | 94.78 |
| +50 | 91.90 | 92.28 | 94.68 |
| 4+00 | 91.38 | 92.41 | 94.61 |
| +50 | 90.86 | 92.14 | 94.54 |
| 5+00 | 90.34 | 91.84 | 94.24 |
| +50 | 89.93 | 90.80 | 93.70 |
| 6+00 | 89.52 | 90.10 | 94.30 |
| +50 | 89.11 | 89.40 | 93.70 |
| 7+00 | 88.70 | 88.70 | 93.70 |
| 7+50 | | 87.70 | 91.00 |
| 8+00 | | 86.80 | 87.60 |
| +50 | | 85.80 | 85.70 |
| 9+00 | | 84.80 | 84.20 |
| +50 | | 83.90 | 83.50 |
| 10+00 | | 82.90 | 83.20 |
| +50 | | 81.90 | 83.20 |
| 10+66 | | 81.40 | 83.20 |
| 11+00 | | 80.00 | 83.50 |
| +50 | | 79.40 | 82.80 |
| 12+00 | | 78.20 | 82.30 |
| +50 | | 77.60 | 80.30 |
| 13+00 | | 77.00 | |
| +50 | | 76.60 | |
| 13+85 | | | |
| 14+00 | | | |

PLATE 4 CROSS SECTION O.P.S. & R. E. STANDARD

PRINTED IN U. S. A. ON 100% RAG STOCK MADE IN U. S. A.
EUGENE DIETZGEN CO., CHGO.-N.Y.

| FINAL SURVEY | | BY | DATE |
|---|---|---|---|
| NOTE BOOK NO. | SURVEYED | | |
| | PLOTTED | | |
| | TEMPLATE | | |
| | AREAS | | |
| | AREAS CHECKED | | |

| ORIGINAL SURVEY | | BY | DATE |
|---|---|---|---|
| NOTE BOOK NO. A-92 | SURVEYED | | 8-22-46 |
| | PLOTTED | R.H.Wood | 8-24-46 |
| | TEMPLATE | | |
| | AREAS | | |
| | AREAS CHECKED | | |

Dietz Lane Ditch

A-14