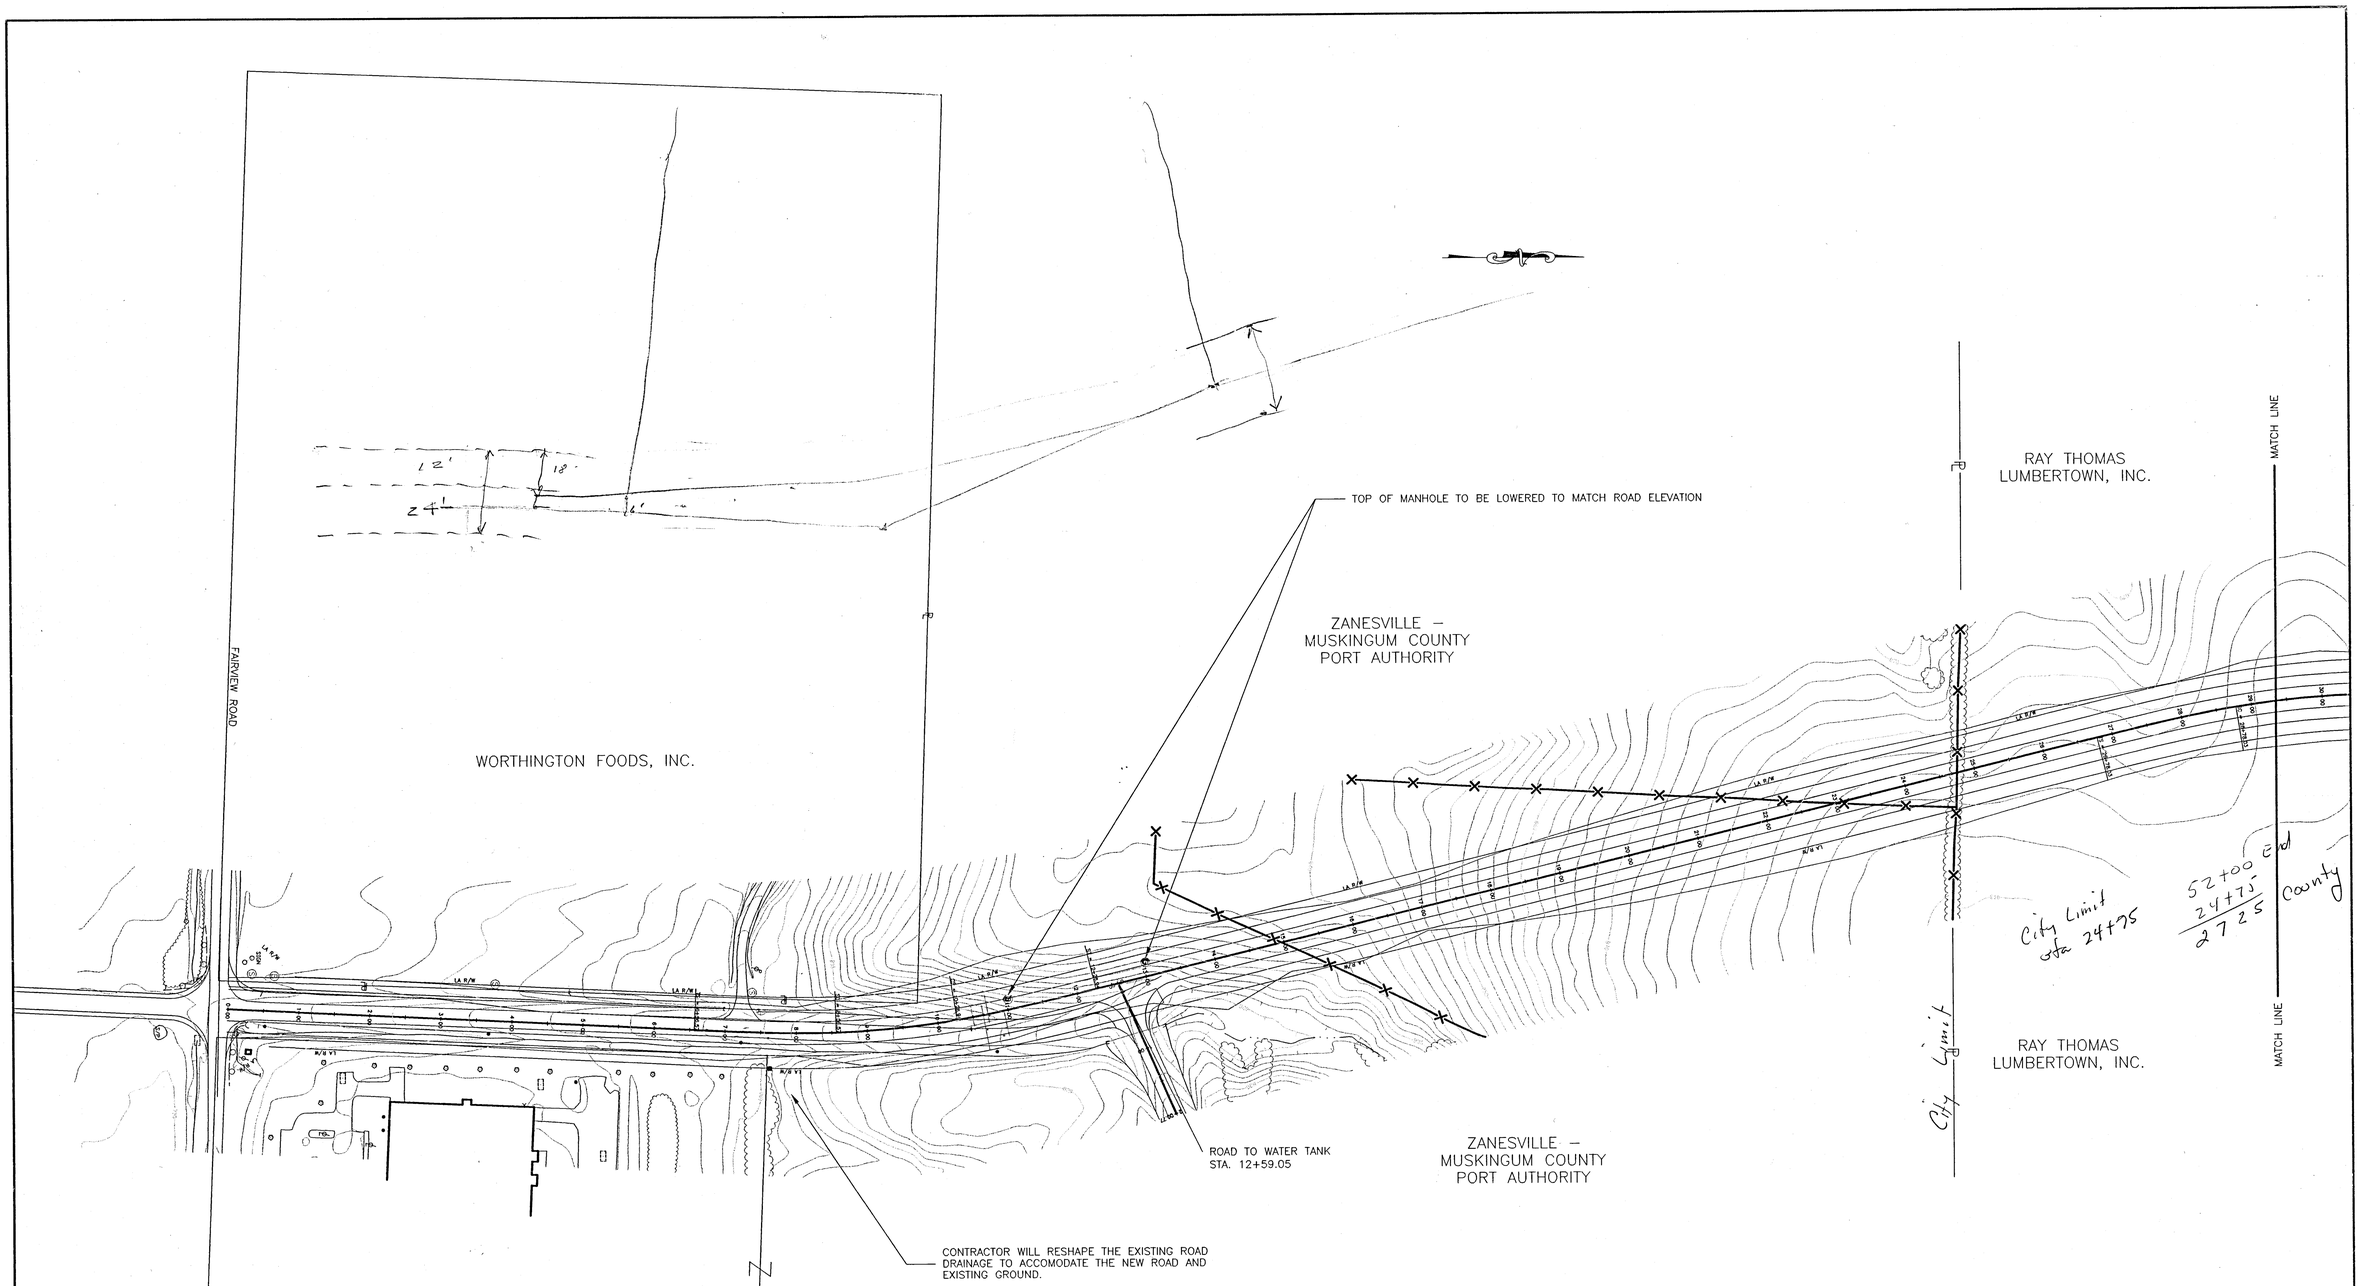

The TCW Company
1218 St. Rt. 93 NE
New Lexington, Ohio 43764 (614) 342-5131

ENGINEERING
SURVEYING
RESOURCE DEVELOPMENT

MUSKINGUM COUNTY ENGINEERING OFFICE
155 REHL ROAD
ZANESVILLE, OHIO 43701

SCALE	1" = 100'	CHECKED	TCW
DATE	1/6/98	APPROVED	
REVISED	2/11/98	CERTIFIED	
DRAWN	VP Jr.		

MUSKINGUM COUNTY
COUNTY ROAD 723 PROJECT
PLANS
PLAN VIEW

3