



FINAL SURVEY	BY	DATE
SURVEYED		
PLOTTED		
NOTED BOOK		
AREAS		
NO.		
AREAS CHECKED		

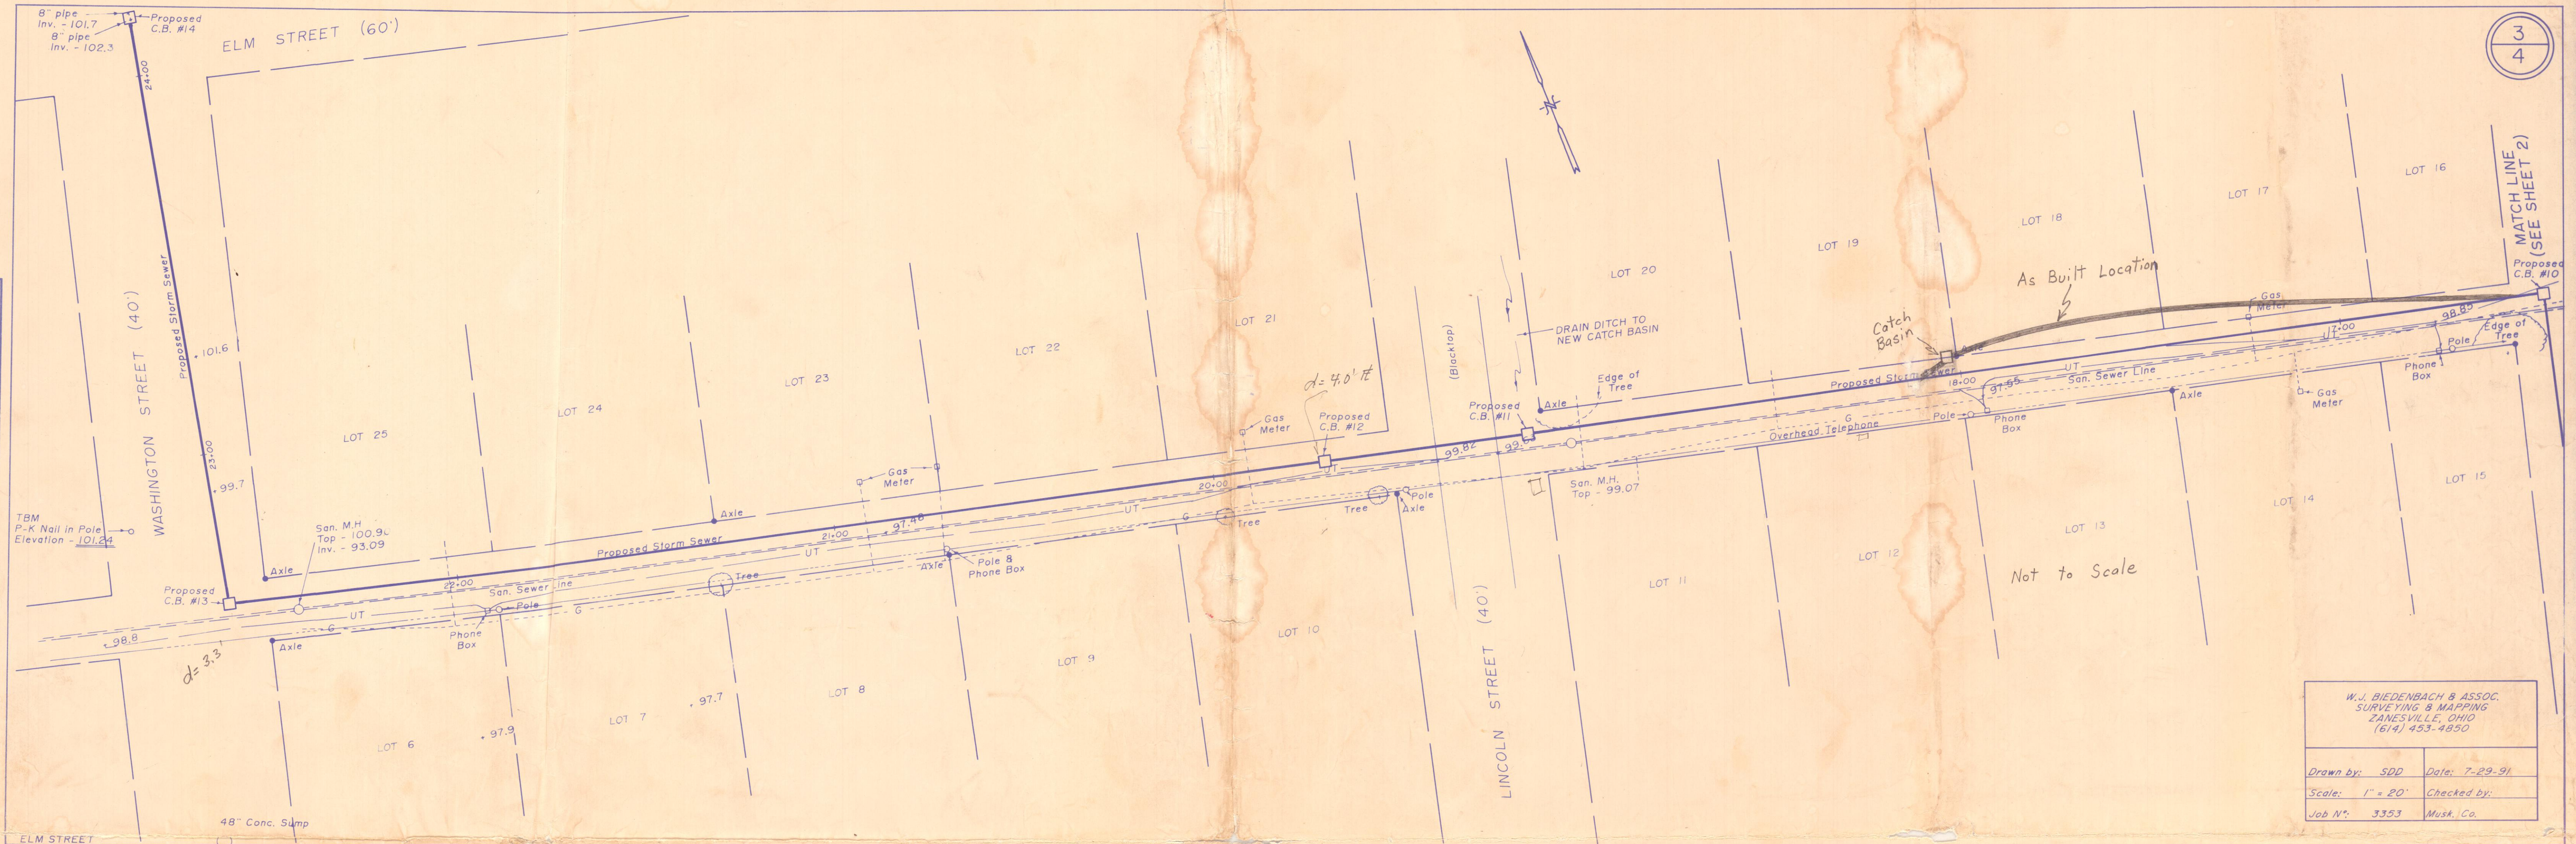

W.J. BIEDENBACH & ASSOC. SURVEYING & MAPPING ZANESVILLE, OHIO (614) 453-4850	
Drawn by: SDD	Date: 7-29-91
Scale: 1" = 20'	Checked by:
Job N°: 3353	Musk, Co.

ORIGINAL SURVEY	BY	DATE
SURVEYED		
PLOTTED		
NOTED BOOK		
AREAS		
NO.		
AREAS CHECKED		

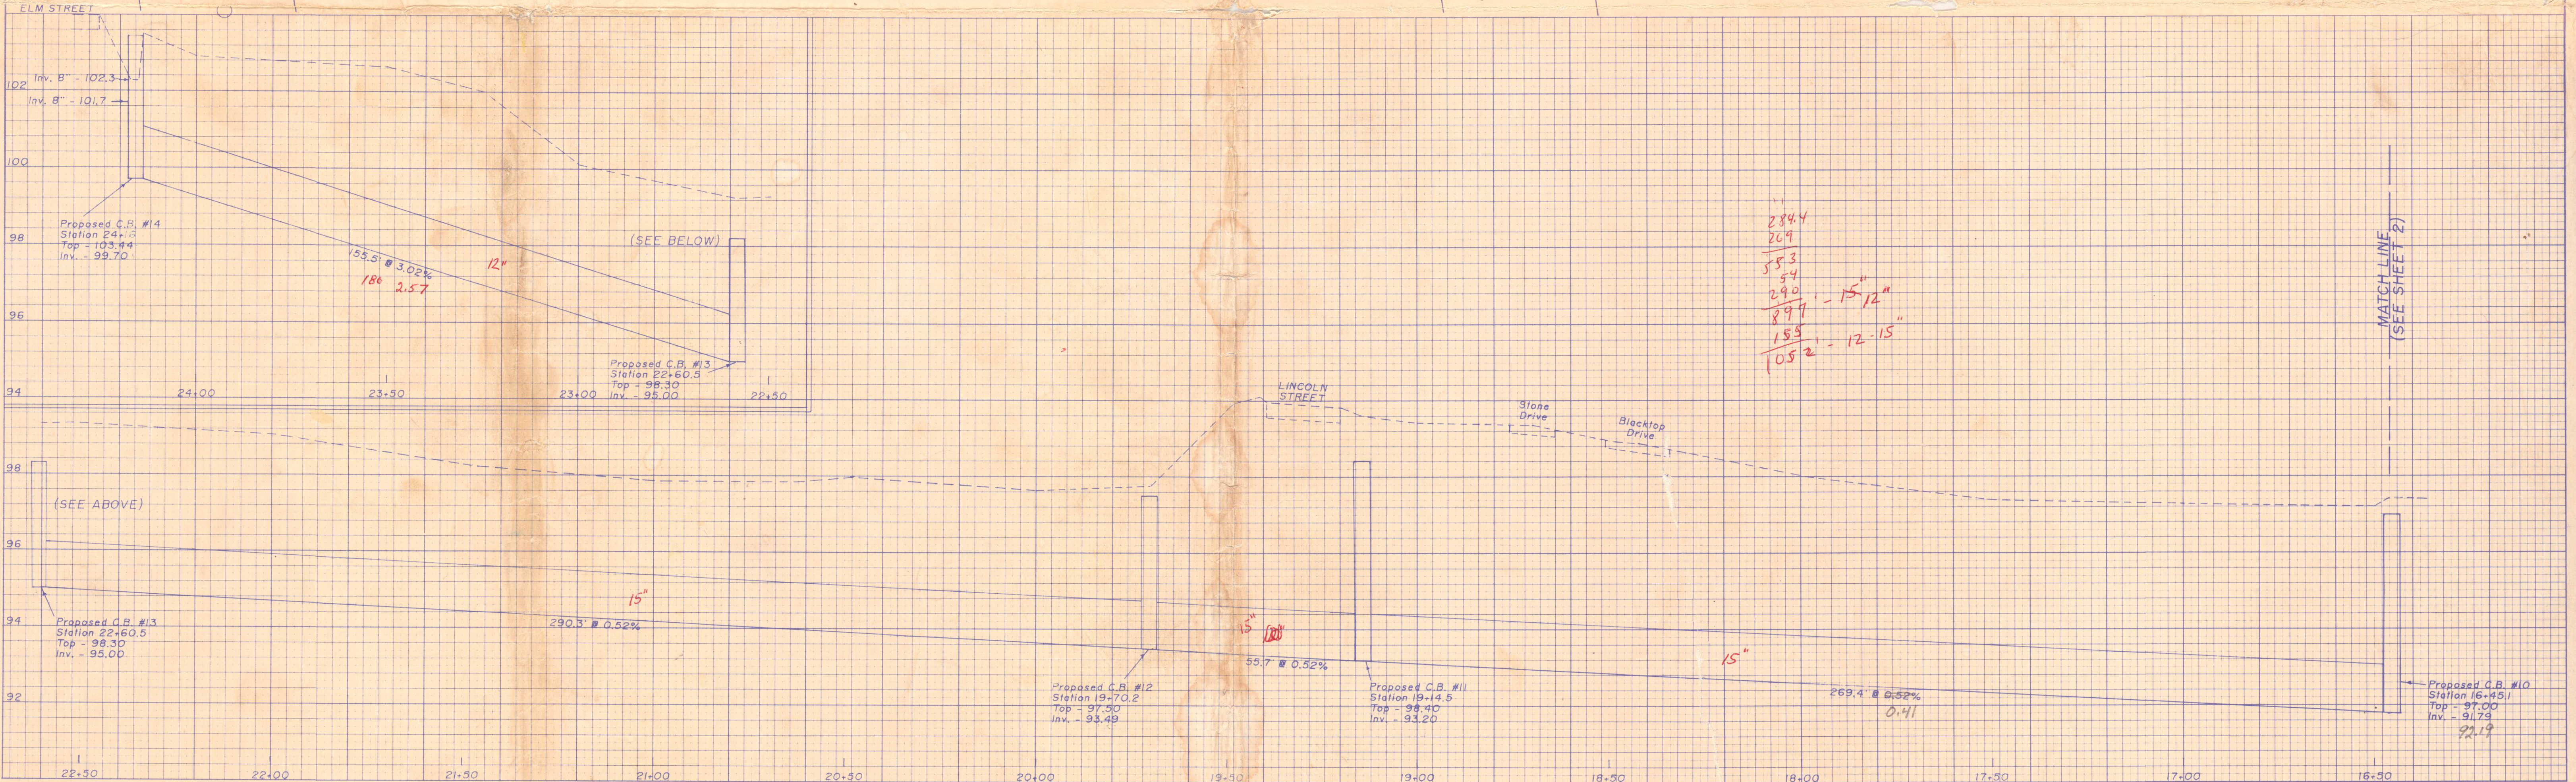

284.4
 209
 55.3
 54
 290
 897 - 15' 12"
 155
 1052 - 12' 15"

103.9
 99.7
 3.7