


FINAL SURVEY	DATE	BY
SURVEYED		
PLOTTED		
NOTE BOOK		
AREAS CHECKED		

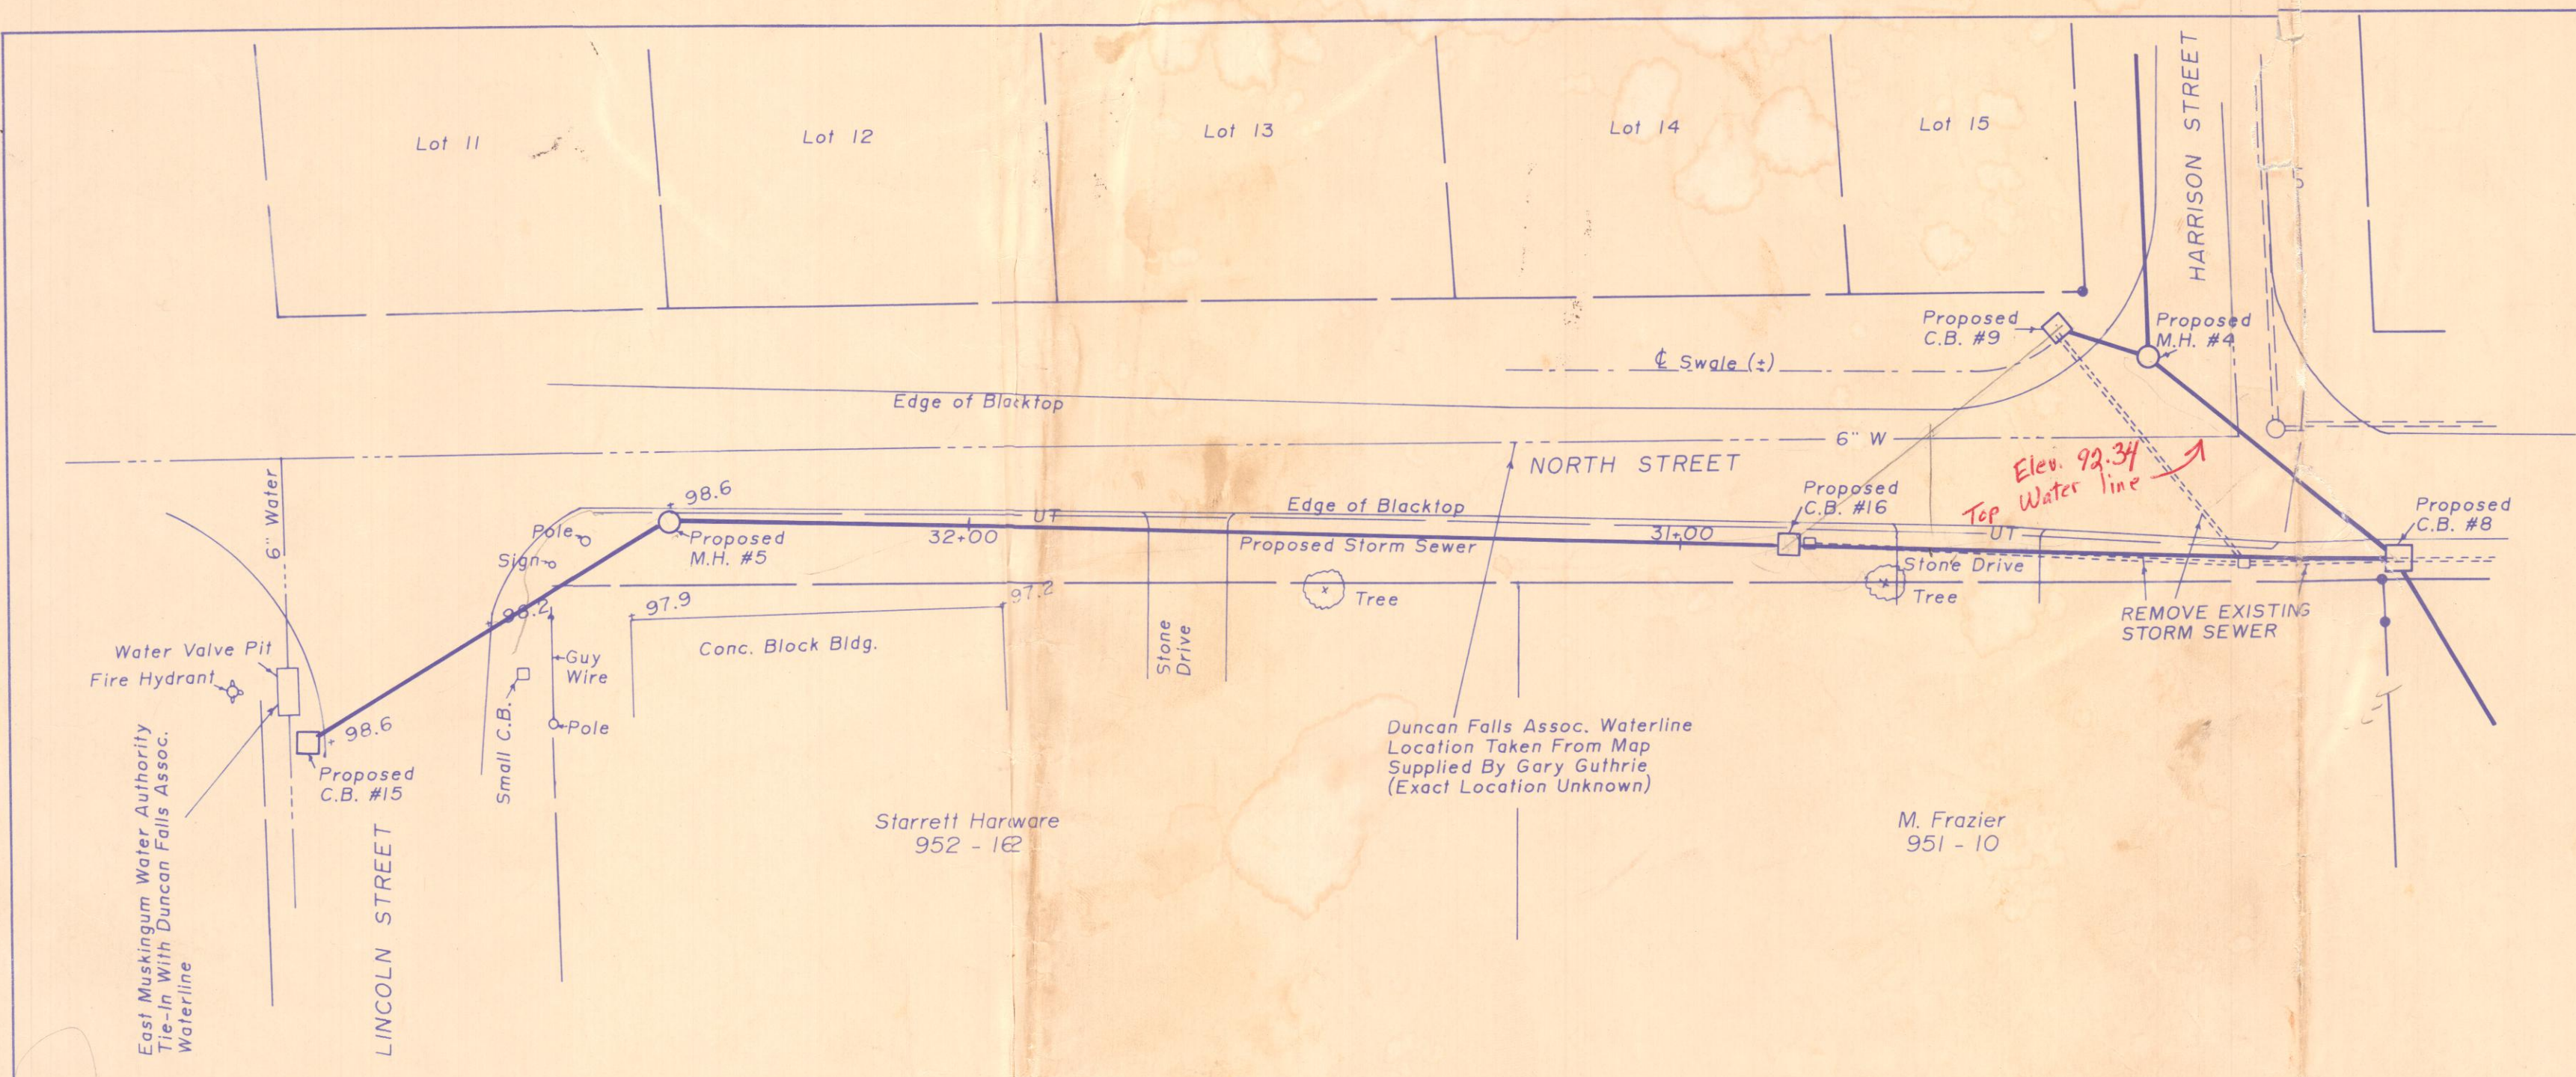

- Legend**
- Proposed Storm Sewer Line
 - Proposed Manhole
 - Proposed Catch Basin
 - Existing Storm Sewer Line
 - Existing Catch Basin
 - Existing Sanitary Manhole
 - Existing Sanitary Line
 - Existing Water Line
 - Existing Underground Telephone Line
 - Existing Overhead Utilities
 - Existing Gas Line
 - Lot or Property Line
 - Iron Pin
 - Edge of Pavement or Stone
 - Tree
 - Pole
- Quantities**
- | | |
|------|---------------------|
| 16 | Catch Basins |
| 5 | Manholes |
| 2768 | Linear Feet of Pipe |

1052' - 12"
1716' - 18"

W.J. BIEDENBACH & ASSOC.
SURVEYING & MAPPING
ZANESVILLE, OHIO
(614) 453-4850

Drawn by: SDD Date: 7-29-91
Scale: 1" = 20' Checked by:
Job N°: 3353 Mush. Co.

ORIGINAL SURVEY	DATE	BY
SURVEYED		
PLOTTED		
NOTE BOOK		
AREAS CHECKED		

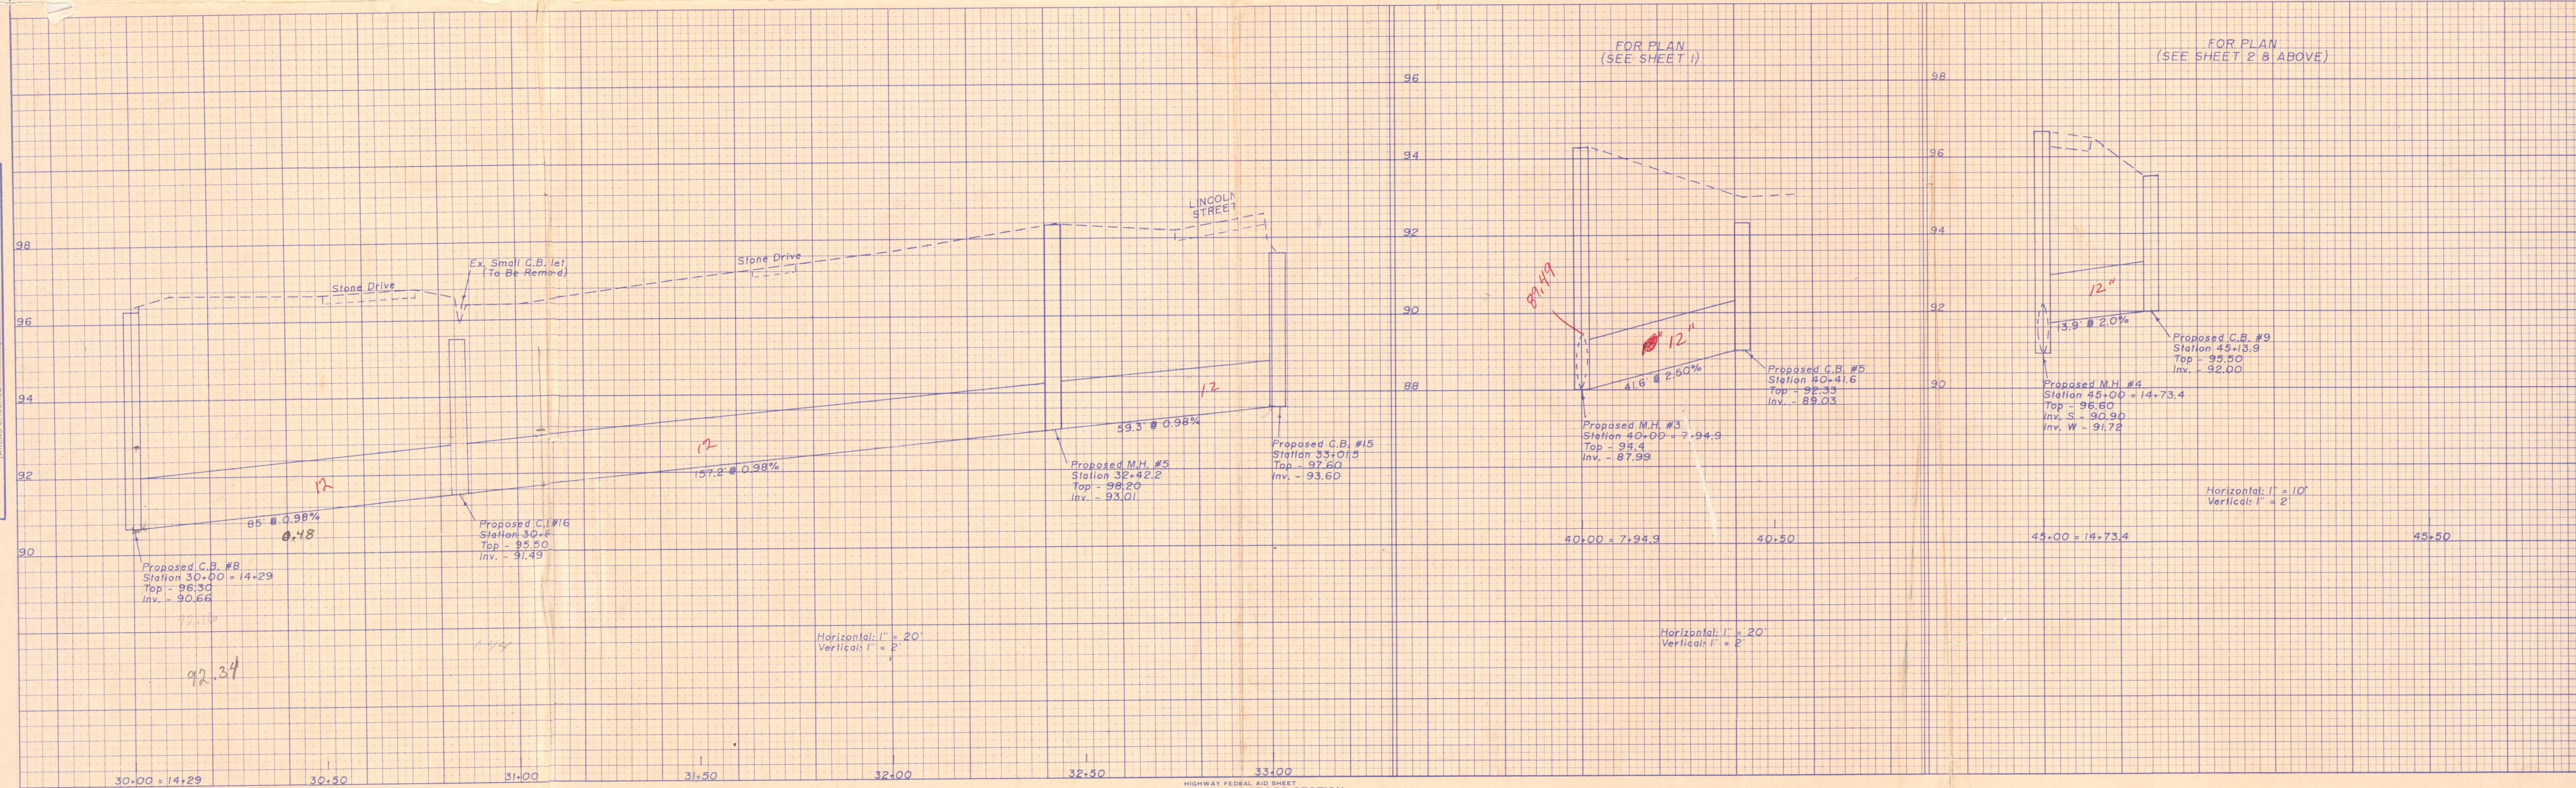


PLATE 4-SINGLE PLAN AND CROSS SECTION-FULL LINE
PRINTED U.S.A.