


PLAN
 CHANGE
 NOTE BOOK
 NO. 1
 OF 1
 OF 1

PROFILE
 CHANGE
 NOTE BOOK
 NO. 1
 OF 1
 OF 1

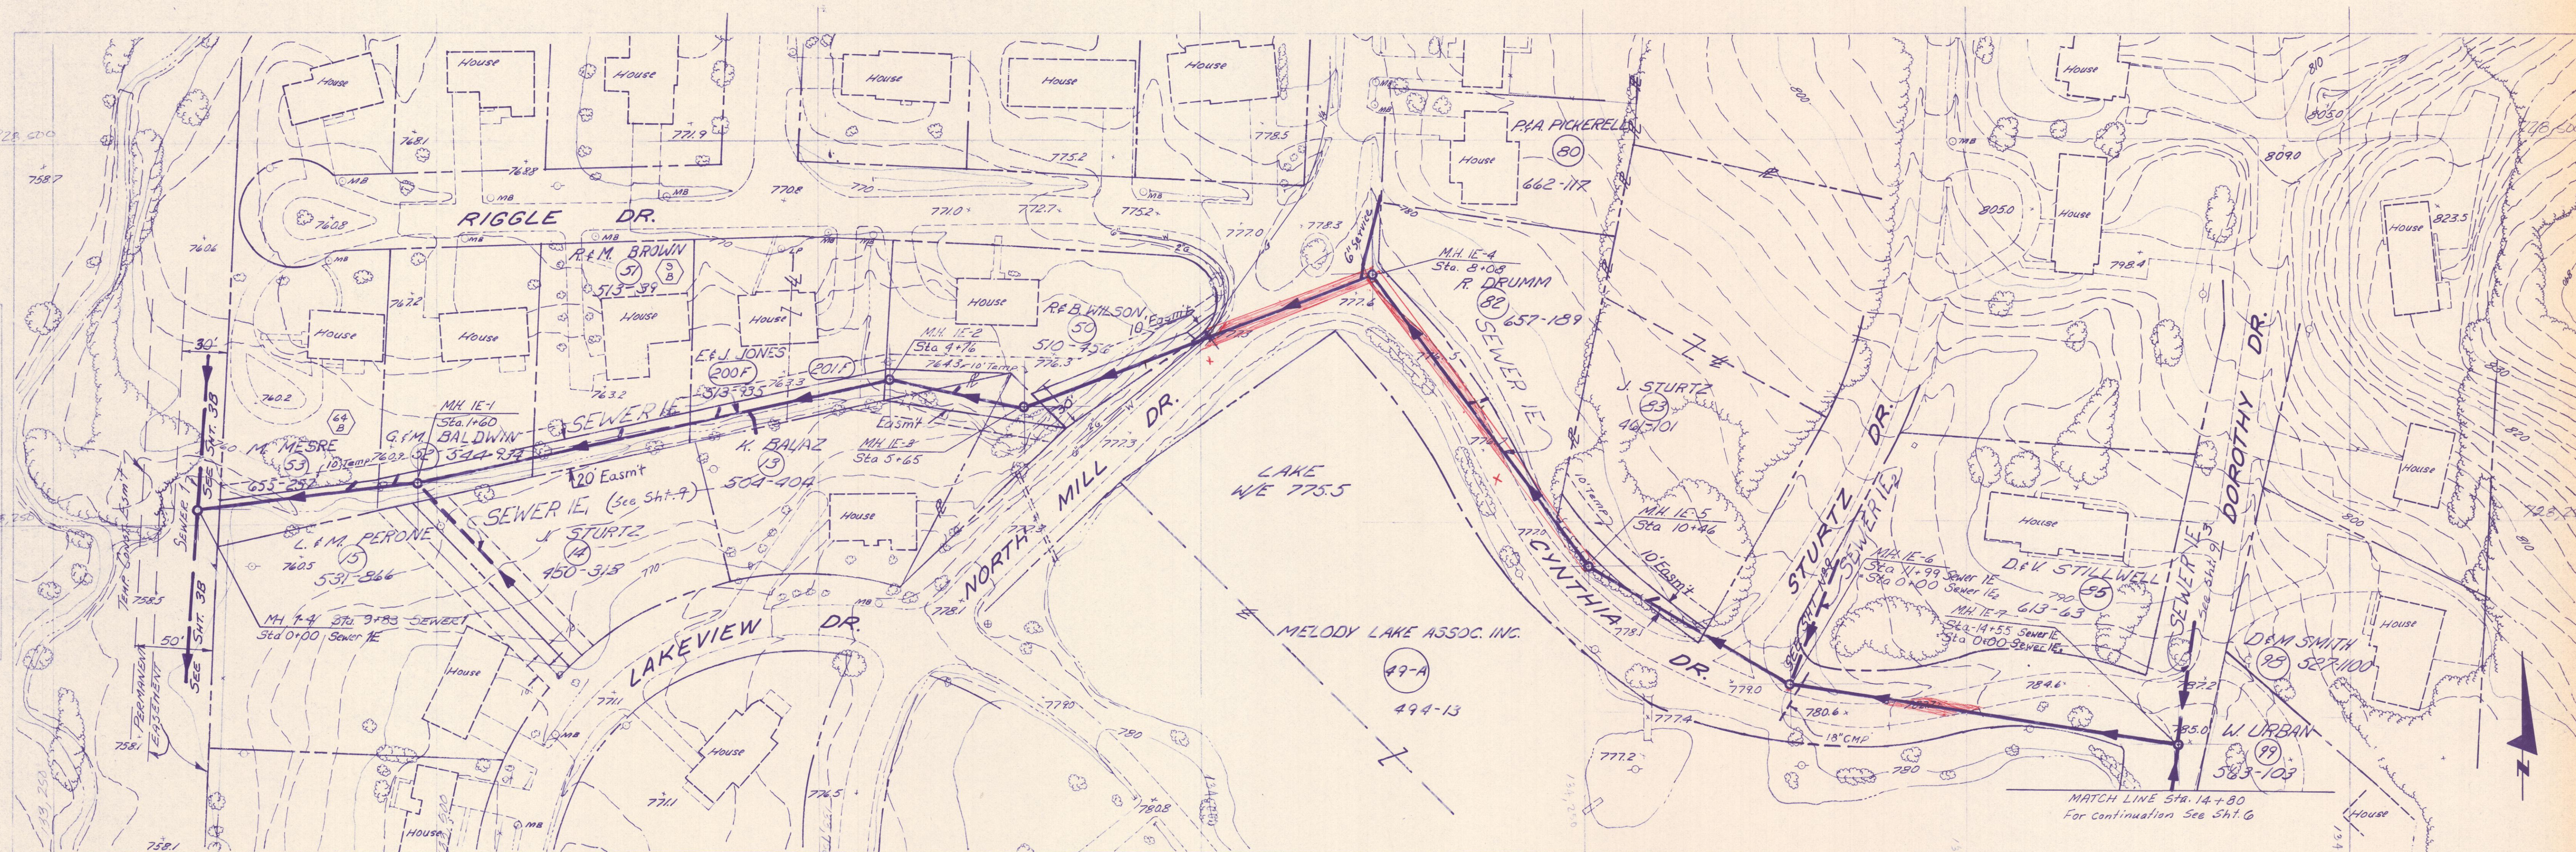

B.M. ELEV. 772.42
 (#822, F.B. 2, PG. 21)
 R.R. SPIKE 1 FOOT UP STREET LAMP
 POST ON S. SIDE OF INTERSECTION
 OF MAYHEW & RIGGLE DR.

B.M. ELEV. 780.92
 (#809, F.B. 2, PG. 15)
 R.R. SPIKE 1 FOOT UP STREET LAMP
 POST AT CENTERLINE-CENTERLINE OF
 NORTH MILL DR. & CYNTHIA DR.

B.M. ELEV. 781.80
 (#811, F.B. 2, PG. 15)
 R.R. SPIKE 1 FOOT UP STREET LAMP
 POST ON N.E. CORNER OF STURTZ DR.
 & CYNTHIA DR.

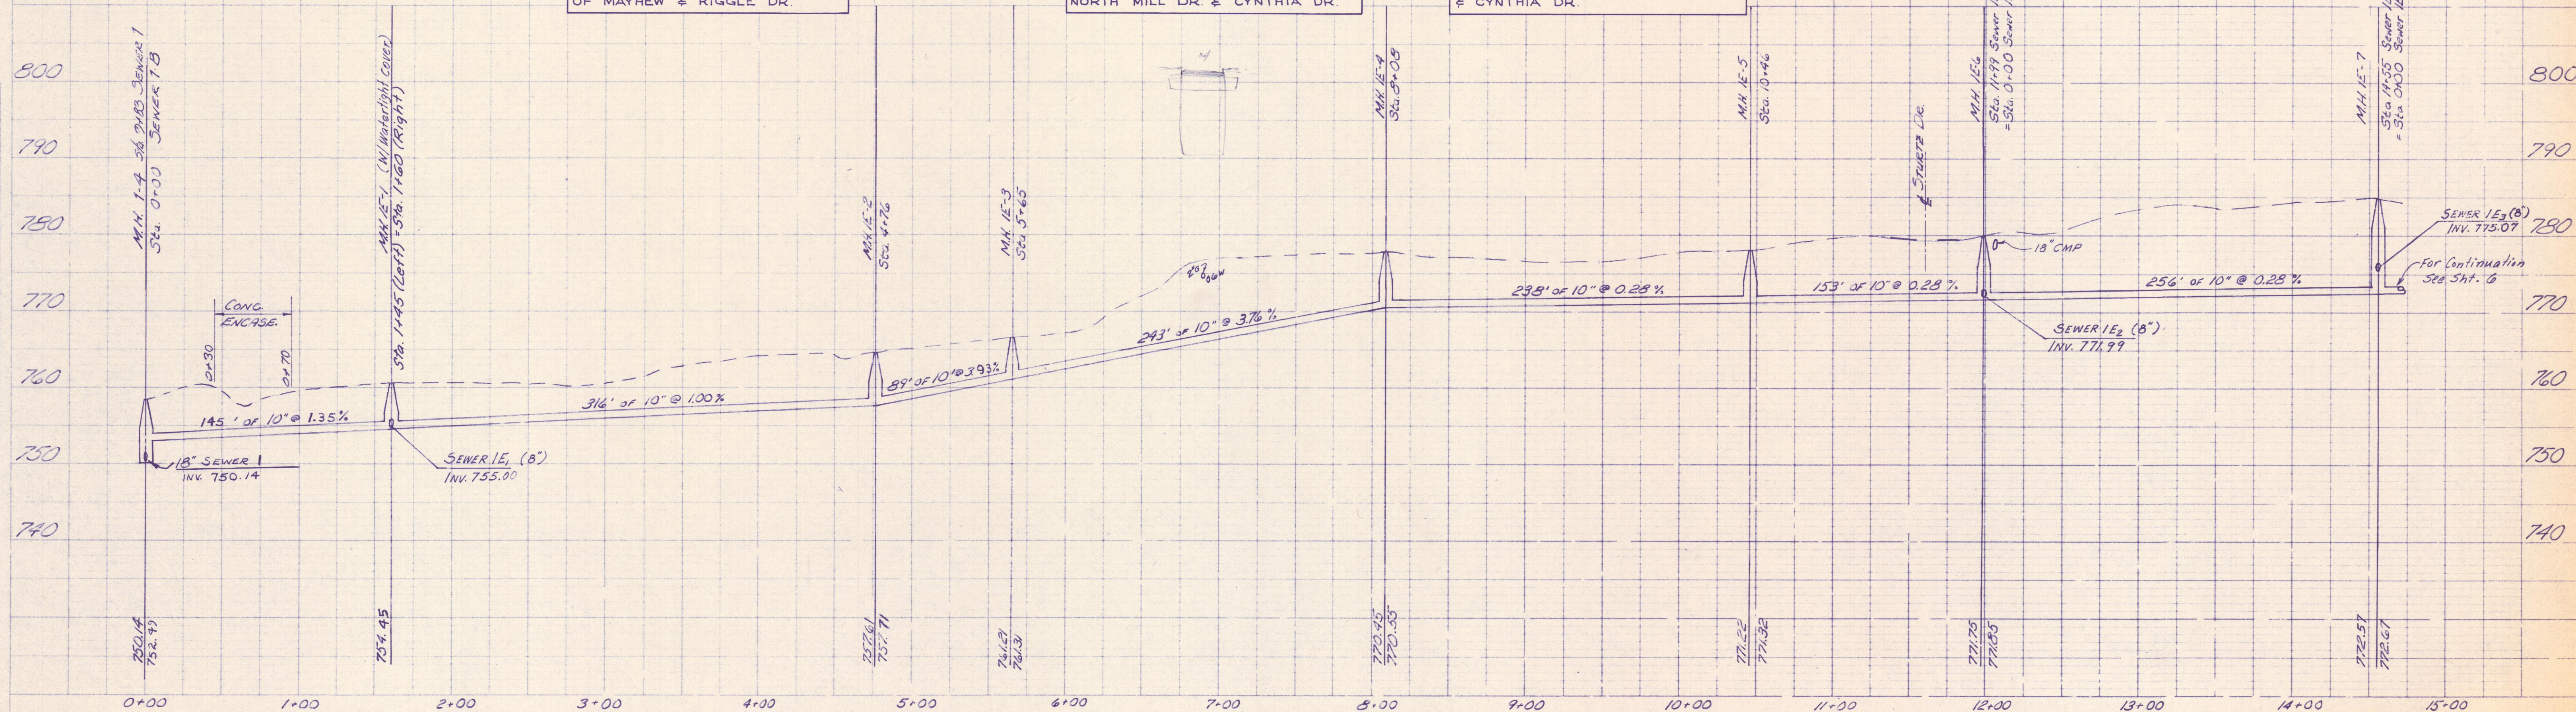


PLATE 1-SINGLE PLAN AND PROFILE FULL-1E
 TELEPHONE NATIONAL TRADING CORP.
 PRINTED IN U.S.A.

CONTRACT 1B
 LINE 1E
 CKD 8/26/75 HGM 5
 51