



FREDA LANE  
STORM SEWER  
STA 4+10 +/-

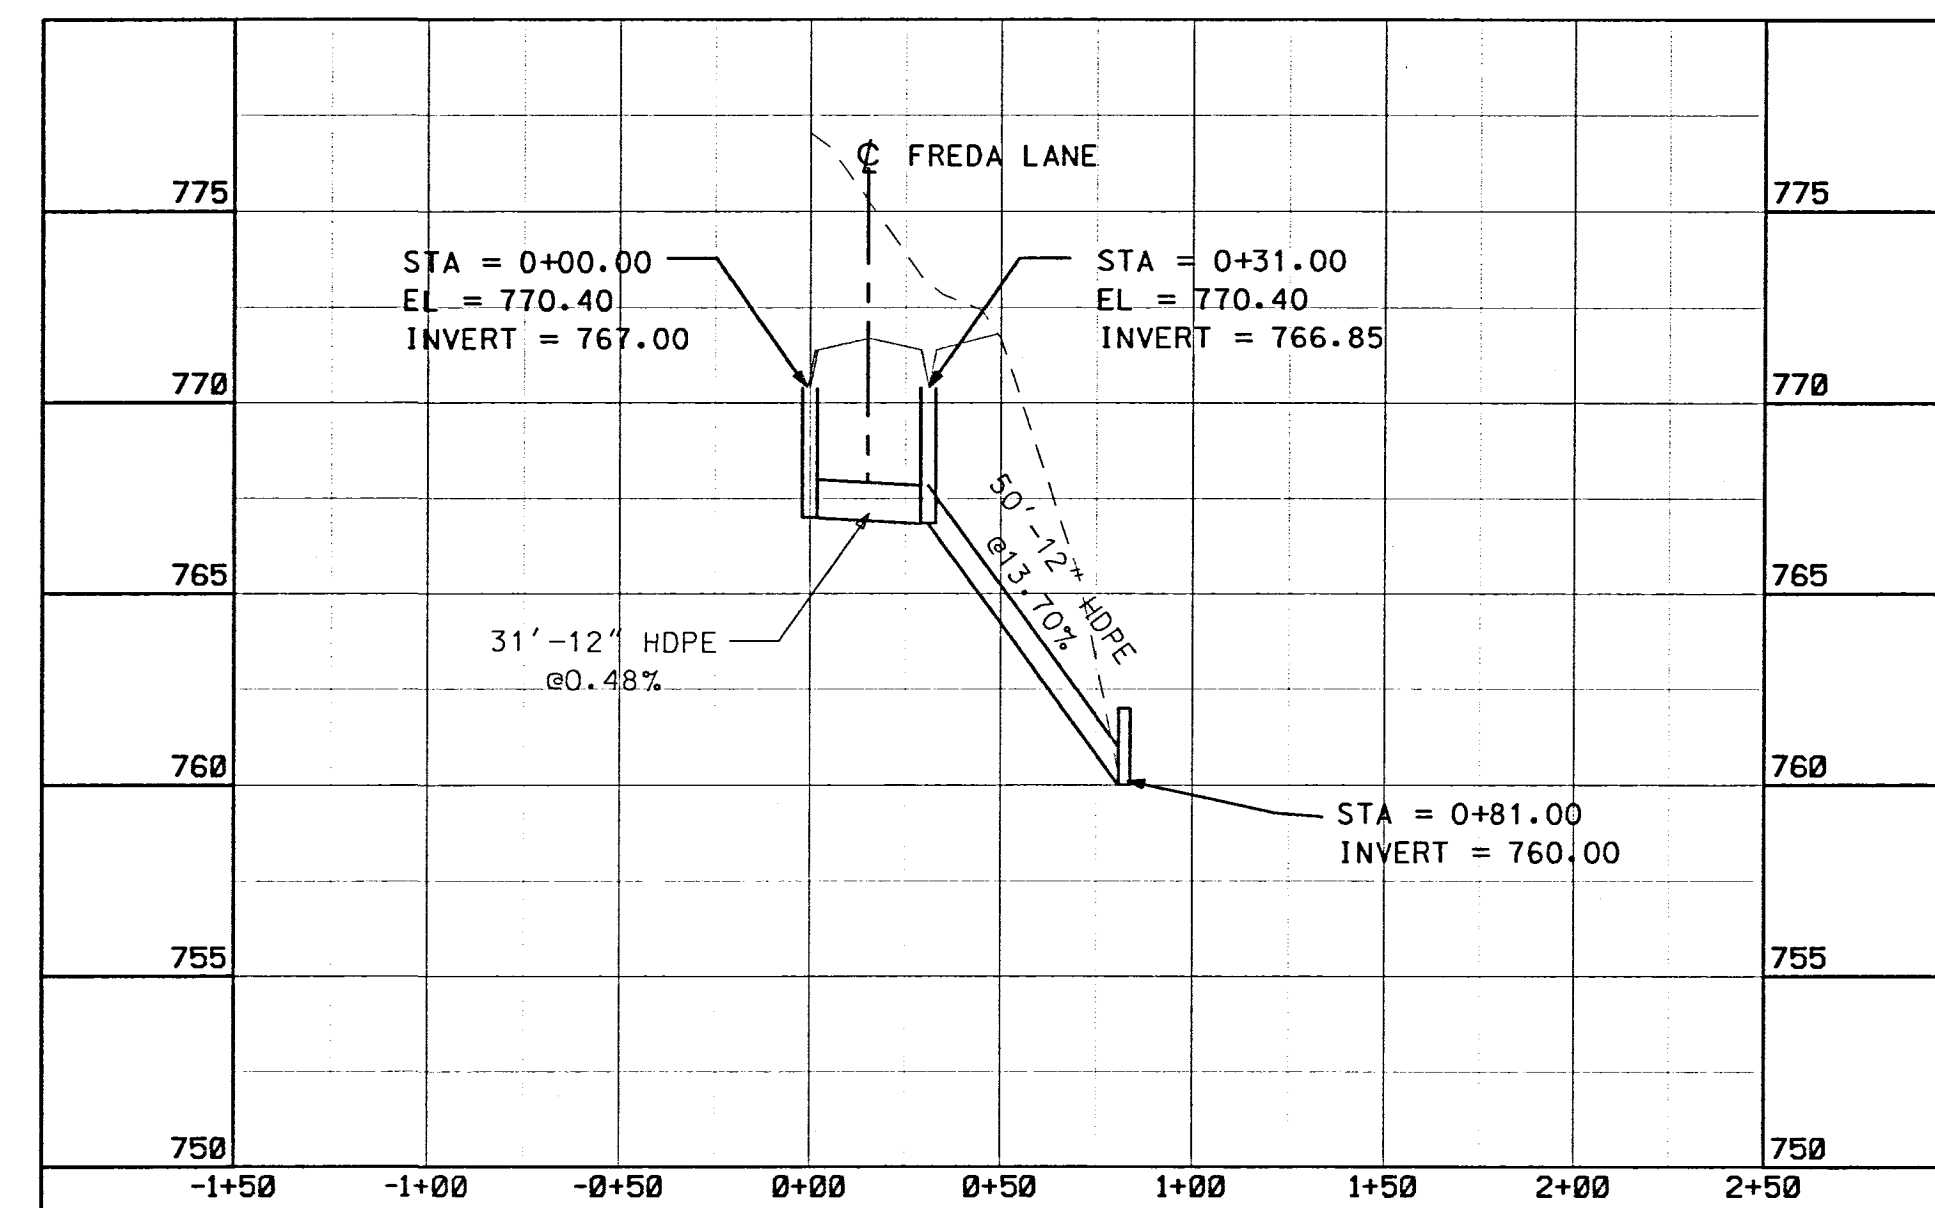


DETENTION POND OUTLET


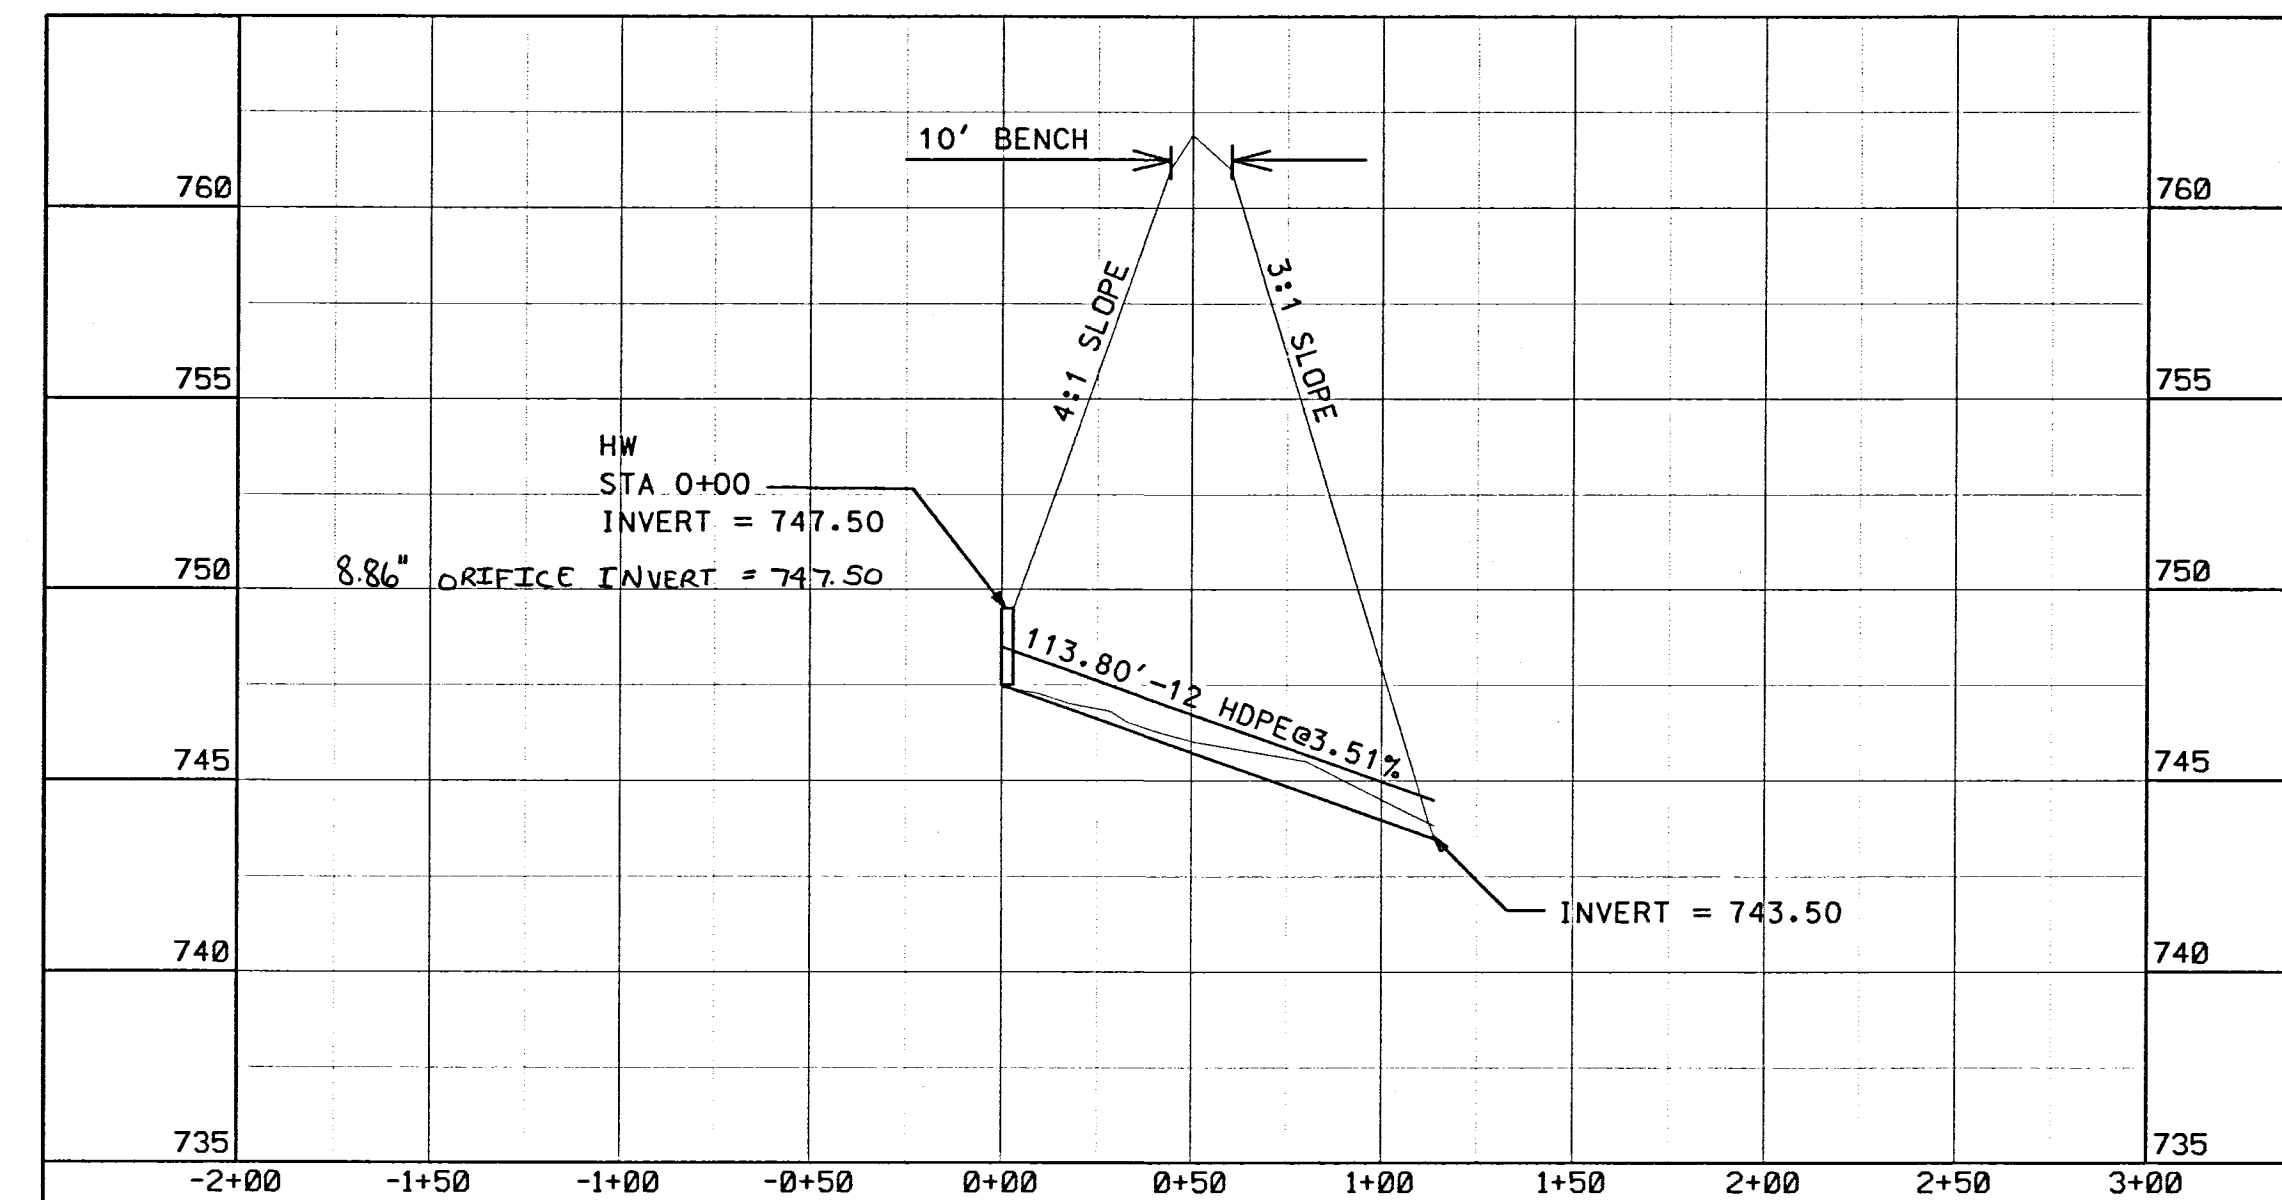


SCALES:  
1" = 50' HOR  
1" = 5' VER

SHERMAN DRIVE  
STORM SEWER  
STA 16+10 +/-

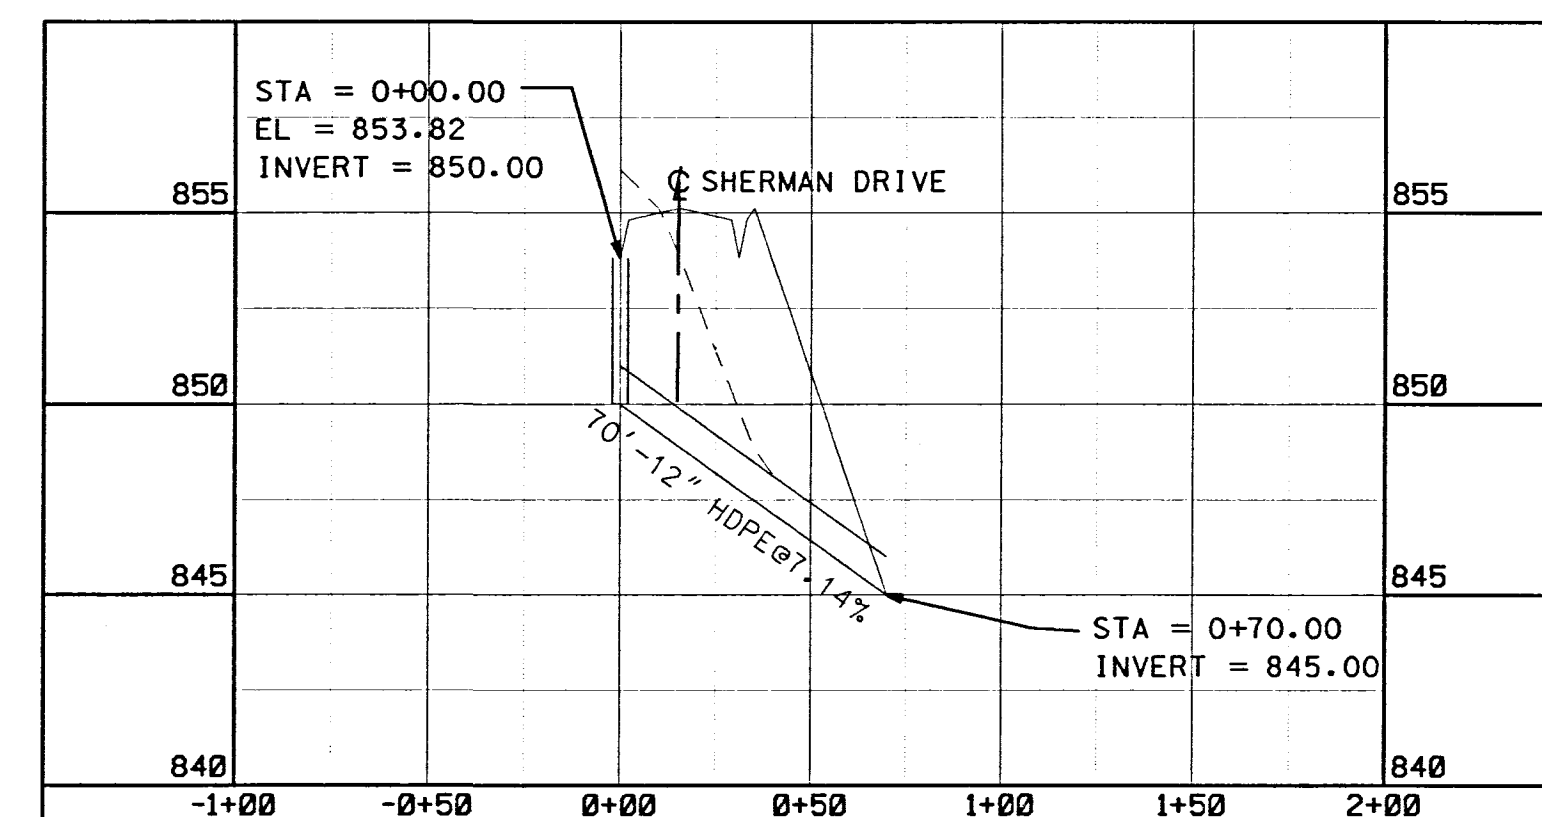

FREDA LANE  
STORM SEWER

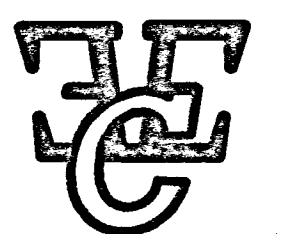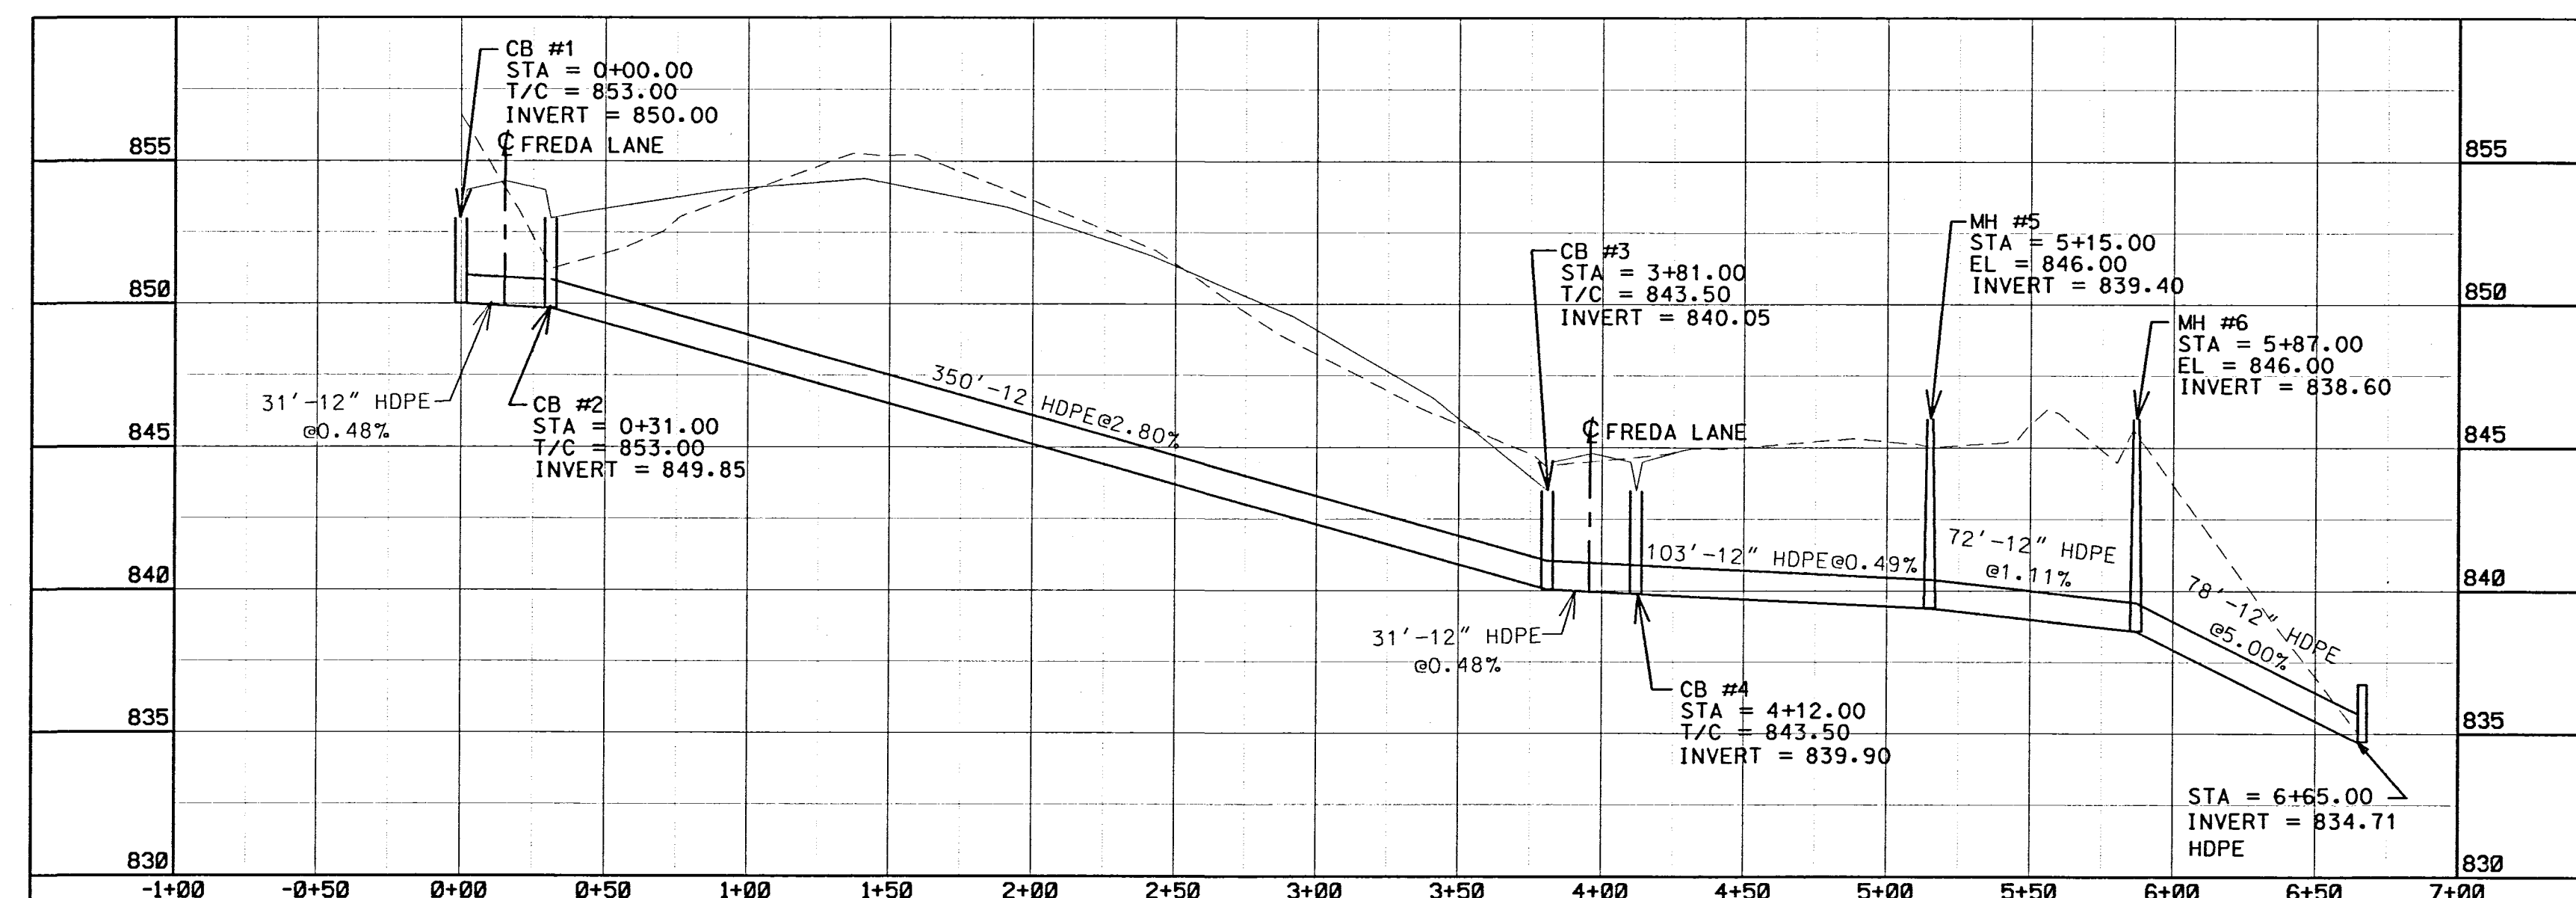

EICHER ENGINEERING  
AND CONSULTING

MARK J. EICHER, P.E.  
38 N. 4TH ST., SUITE 305  
ZANESVILLE, OHIO 43701  
(740) 450-9309

GEORGIA PINES ESTATES  
NEWTON TOWNSHIP  
MUSKINGUM COUNTY, OH

DATE  
4/17/02

TITLE  
PROFILE  
STORM SEWER

SHEET  
C-12