


West Approach
Add 75' Rail or Fence
Add 20' washout repair
Set or drive small posts
back w/ Flooring then Fill.
Both Sides.

Concrete Approach
15' across

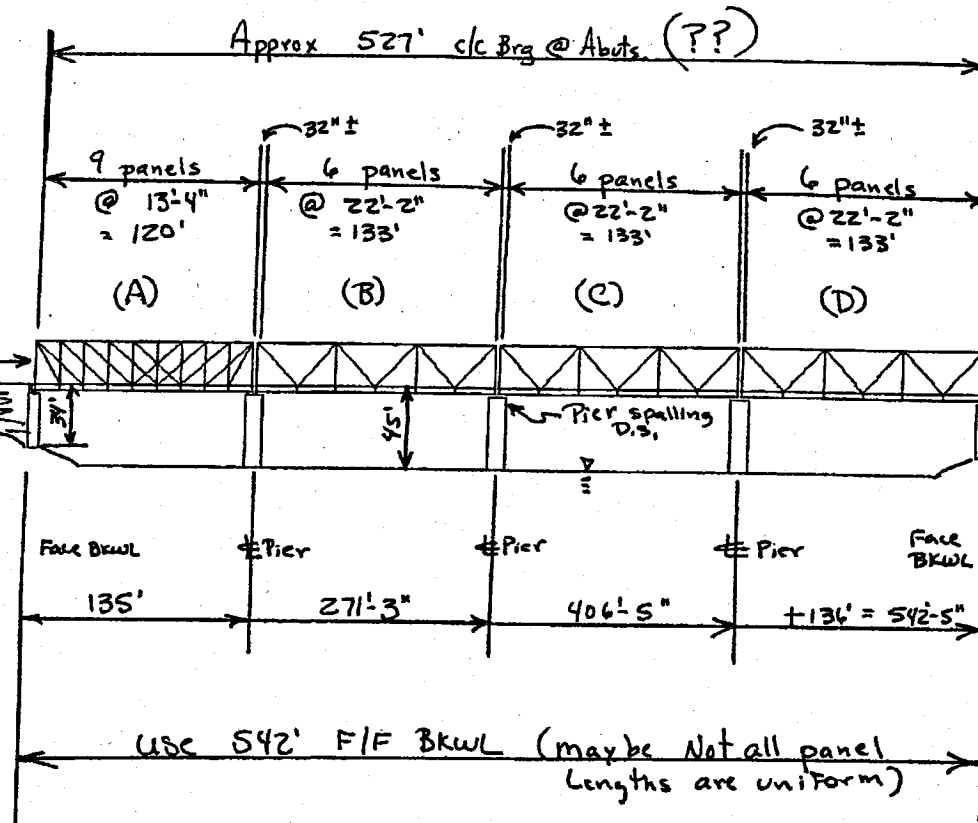

East Approach
55' x 15'

(A) = F.B's = 31" x 14" Str. 25" x 12 1/2 6'-6" O.C. 16'-6" c/c truss 14' inside. 10'-3" clear.

(B), (C), (D) = F.B's ≈ 45" deep, 12" Flg Stringers = 35 1/2" deep 13" Flg. Recessed @ 5" @ 6'-6" O.C.
ties ≈ 12" hi x 10" wide @ 15" O.C.

17' cc trusses 15' clear between ~~girders~~ ^{Trusses}

BP
11 17 11
24

Ties - 8-3% East curb 8" x 5" h.

Muskingum County Bikeway
RR Bridge @ Ellis Dam
over Muskingum River
- 101a.