

# Herdman's Addition to Cannellville

Plat of a subdivision of lands into lots streets and alleys to be known as Herdman's Addition to Cannellville, I the undersigned of the City of Zanesville in the County of Muskingum and State of Ohio owner in fee and proprietor of land as sub-divided and shown in the foregoing plat and lying in the south east quarter of section 26 range 10 township 11 Brush Creek Township, Muskingum County Ohio have caused part of the same to be laid out into lots streets and alleys as shown by this plat. The lots are numbered from one to fifty six inclusive and are of the number of feet or feet and fractions of a foot front and depth. The Streets and alleys are of the width as marked thereon. Stones are planted at all corners marked 'Stone' from which to make and regulate future surveys. A deed was made by Solomon Goodlive and wife conveying to the undersigned a strip of land 20 feet wide (dated June 9 1887) for a street called Goodlive street and 20 feet given by the undersigned making said Street 40 feet wide. Columbus Street runs north and south and Brush Avenue, Manly Street and Webster Street and the alleys east and west. There is in said Addition six acres and forty three hundredths of an acre. In witness whereof I have hereunto set my hand and seal this 11th day of July A.D. 1887. Signed, sealed and acknowledged in


James Herdman (Seal) presence of us. S. Scarvell  
Frances G. Camp

The State of Ohio Muskingum County ss. I the undersigned Notary Public in and for said County do hereby certify that on the 11th day of July A.D. 1887 before me personally appeared James Herdman whose name is subscribed to the foregoing plat and acknowledged the signing and sealing of the foregoing plat to be his voluntary act and deed. Given under my hand and seal Notarial this day and year above written. Llewellyn Scarvell Notary Public (Seal)

I the undersigned do hereby certify that the foregoing plat is in all respects correct as I verily believe as surveyed by me June A.D. 1887 and that there is in said Addition six acres and forty three hundredths of an acre (6.1300).

Llewellyn Scarvell Surveyor

Entered for transfer Oct 20, 1887 - A. Knight Auditor  
Received for record Oct 20th 1887 at 2 oclock P.M. Recorded Oct 20th 1887 D. Zimmer Recorder per Cunningham

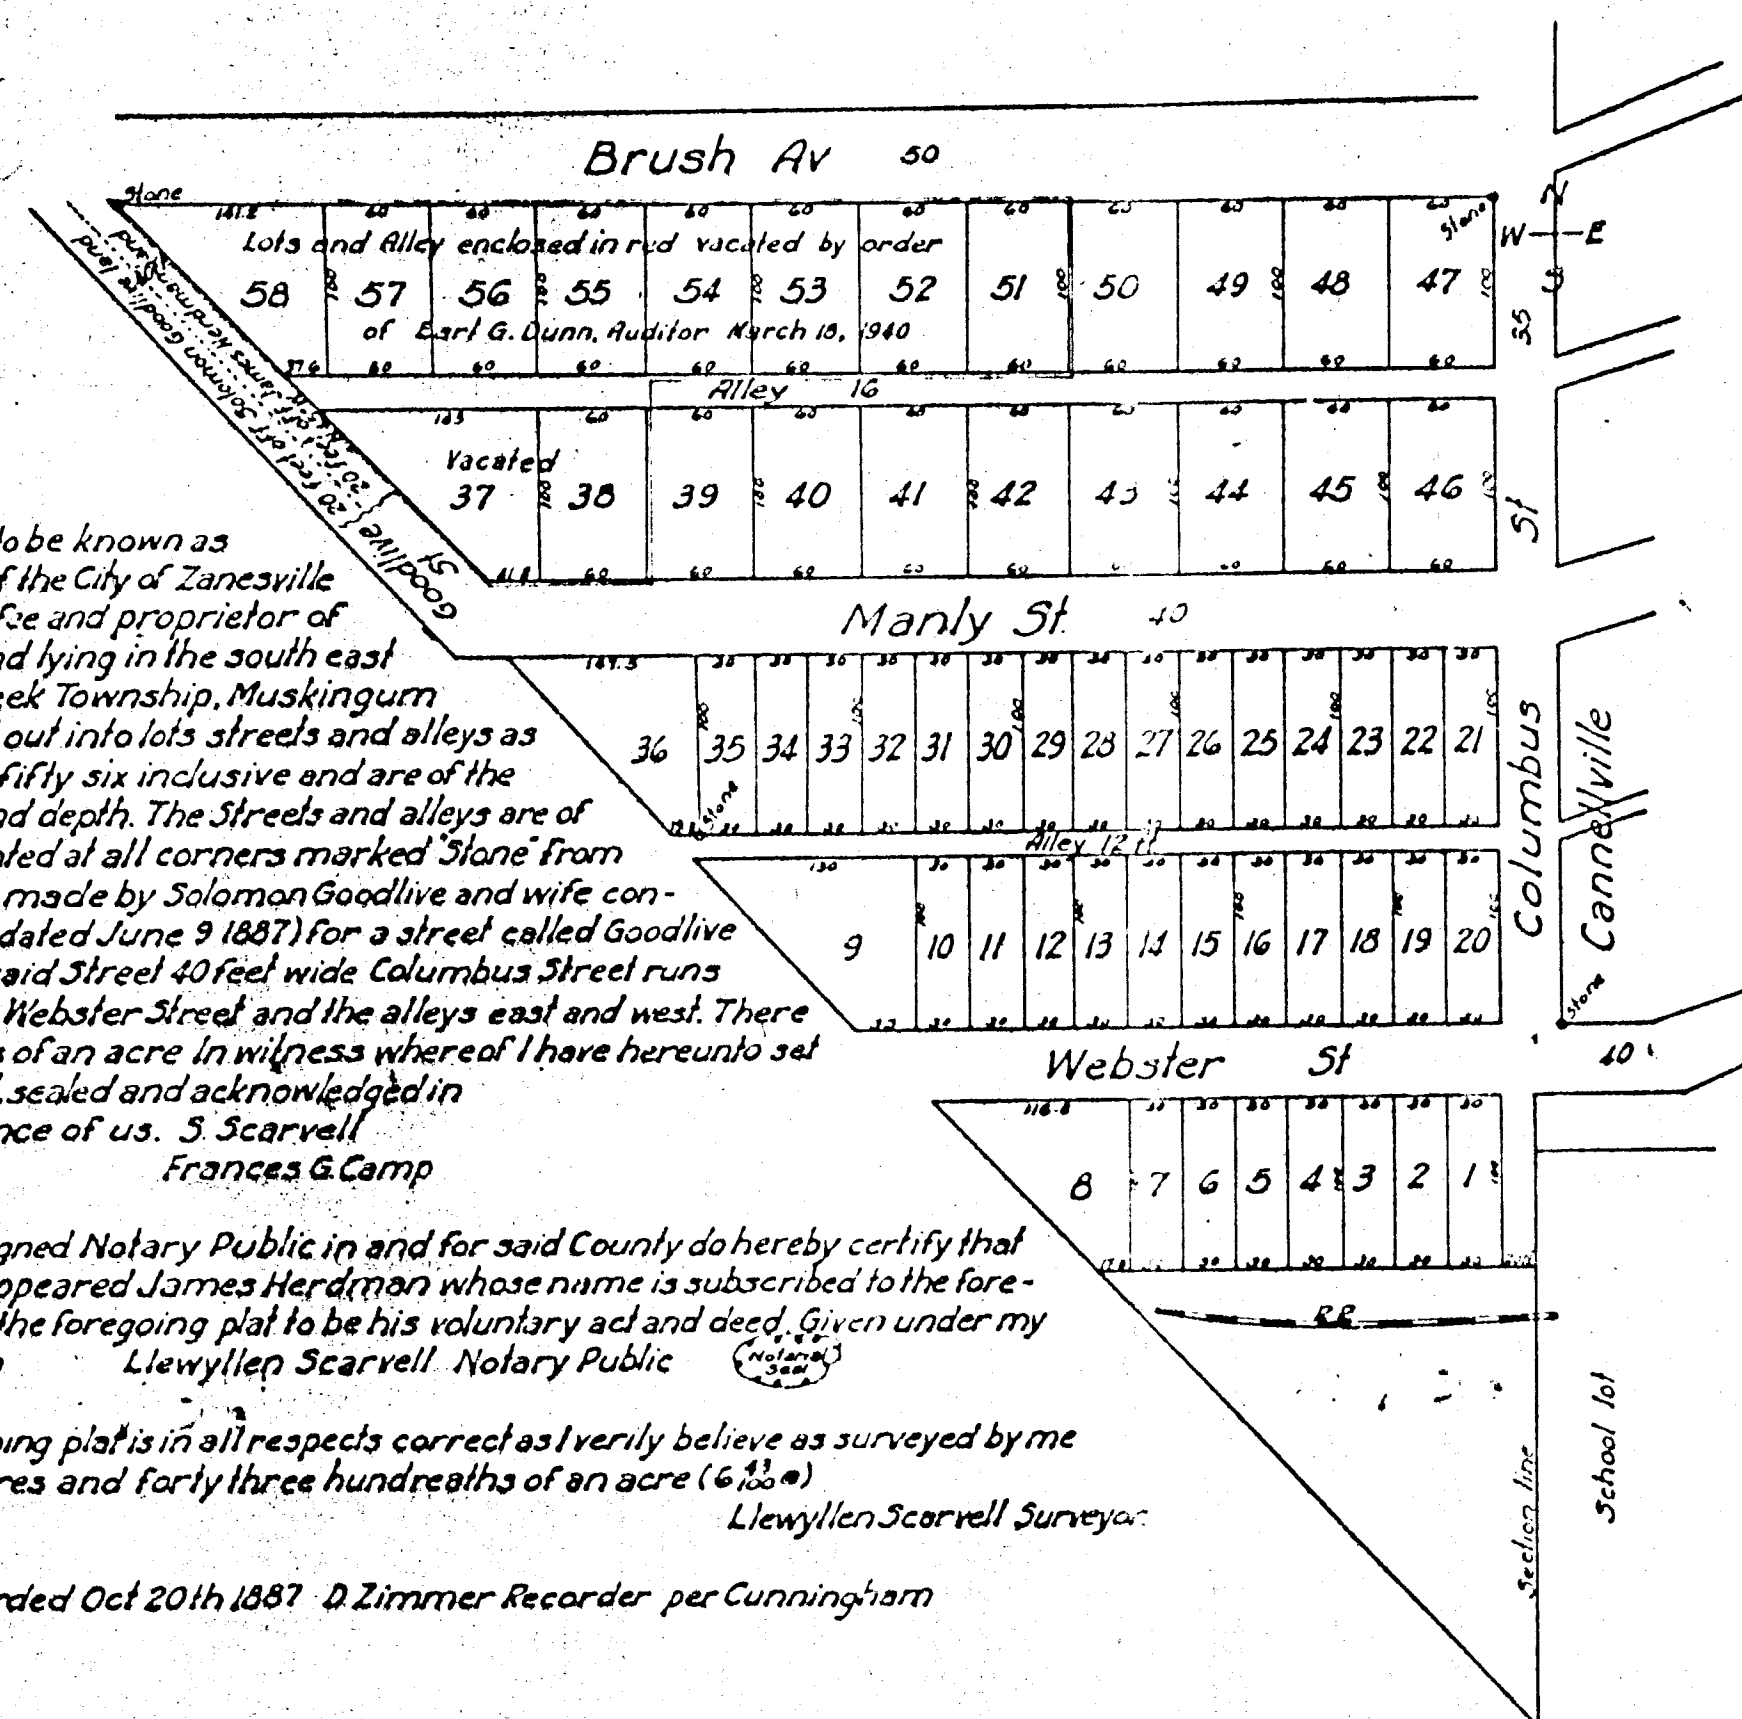

Flowers Subdivision