


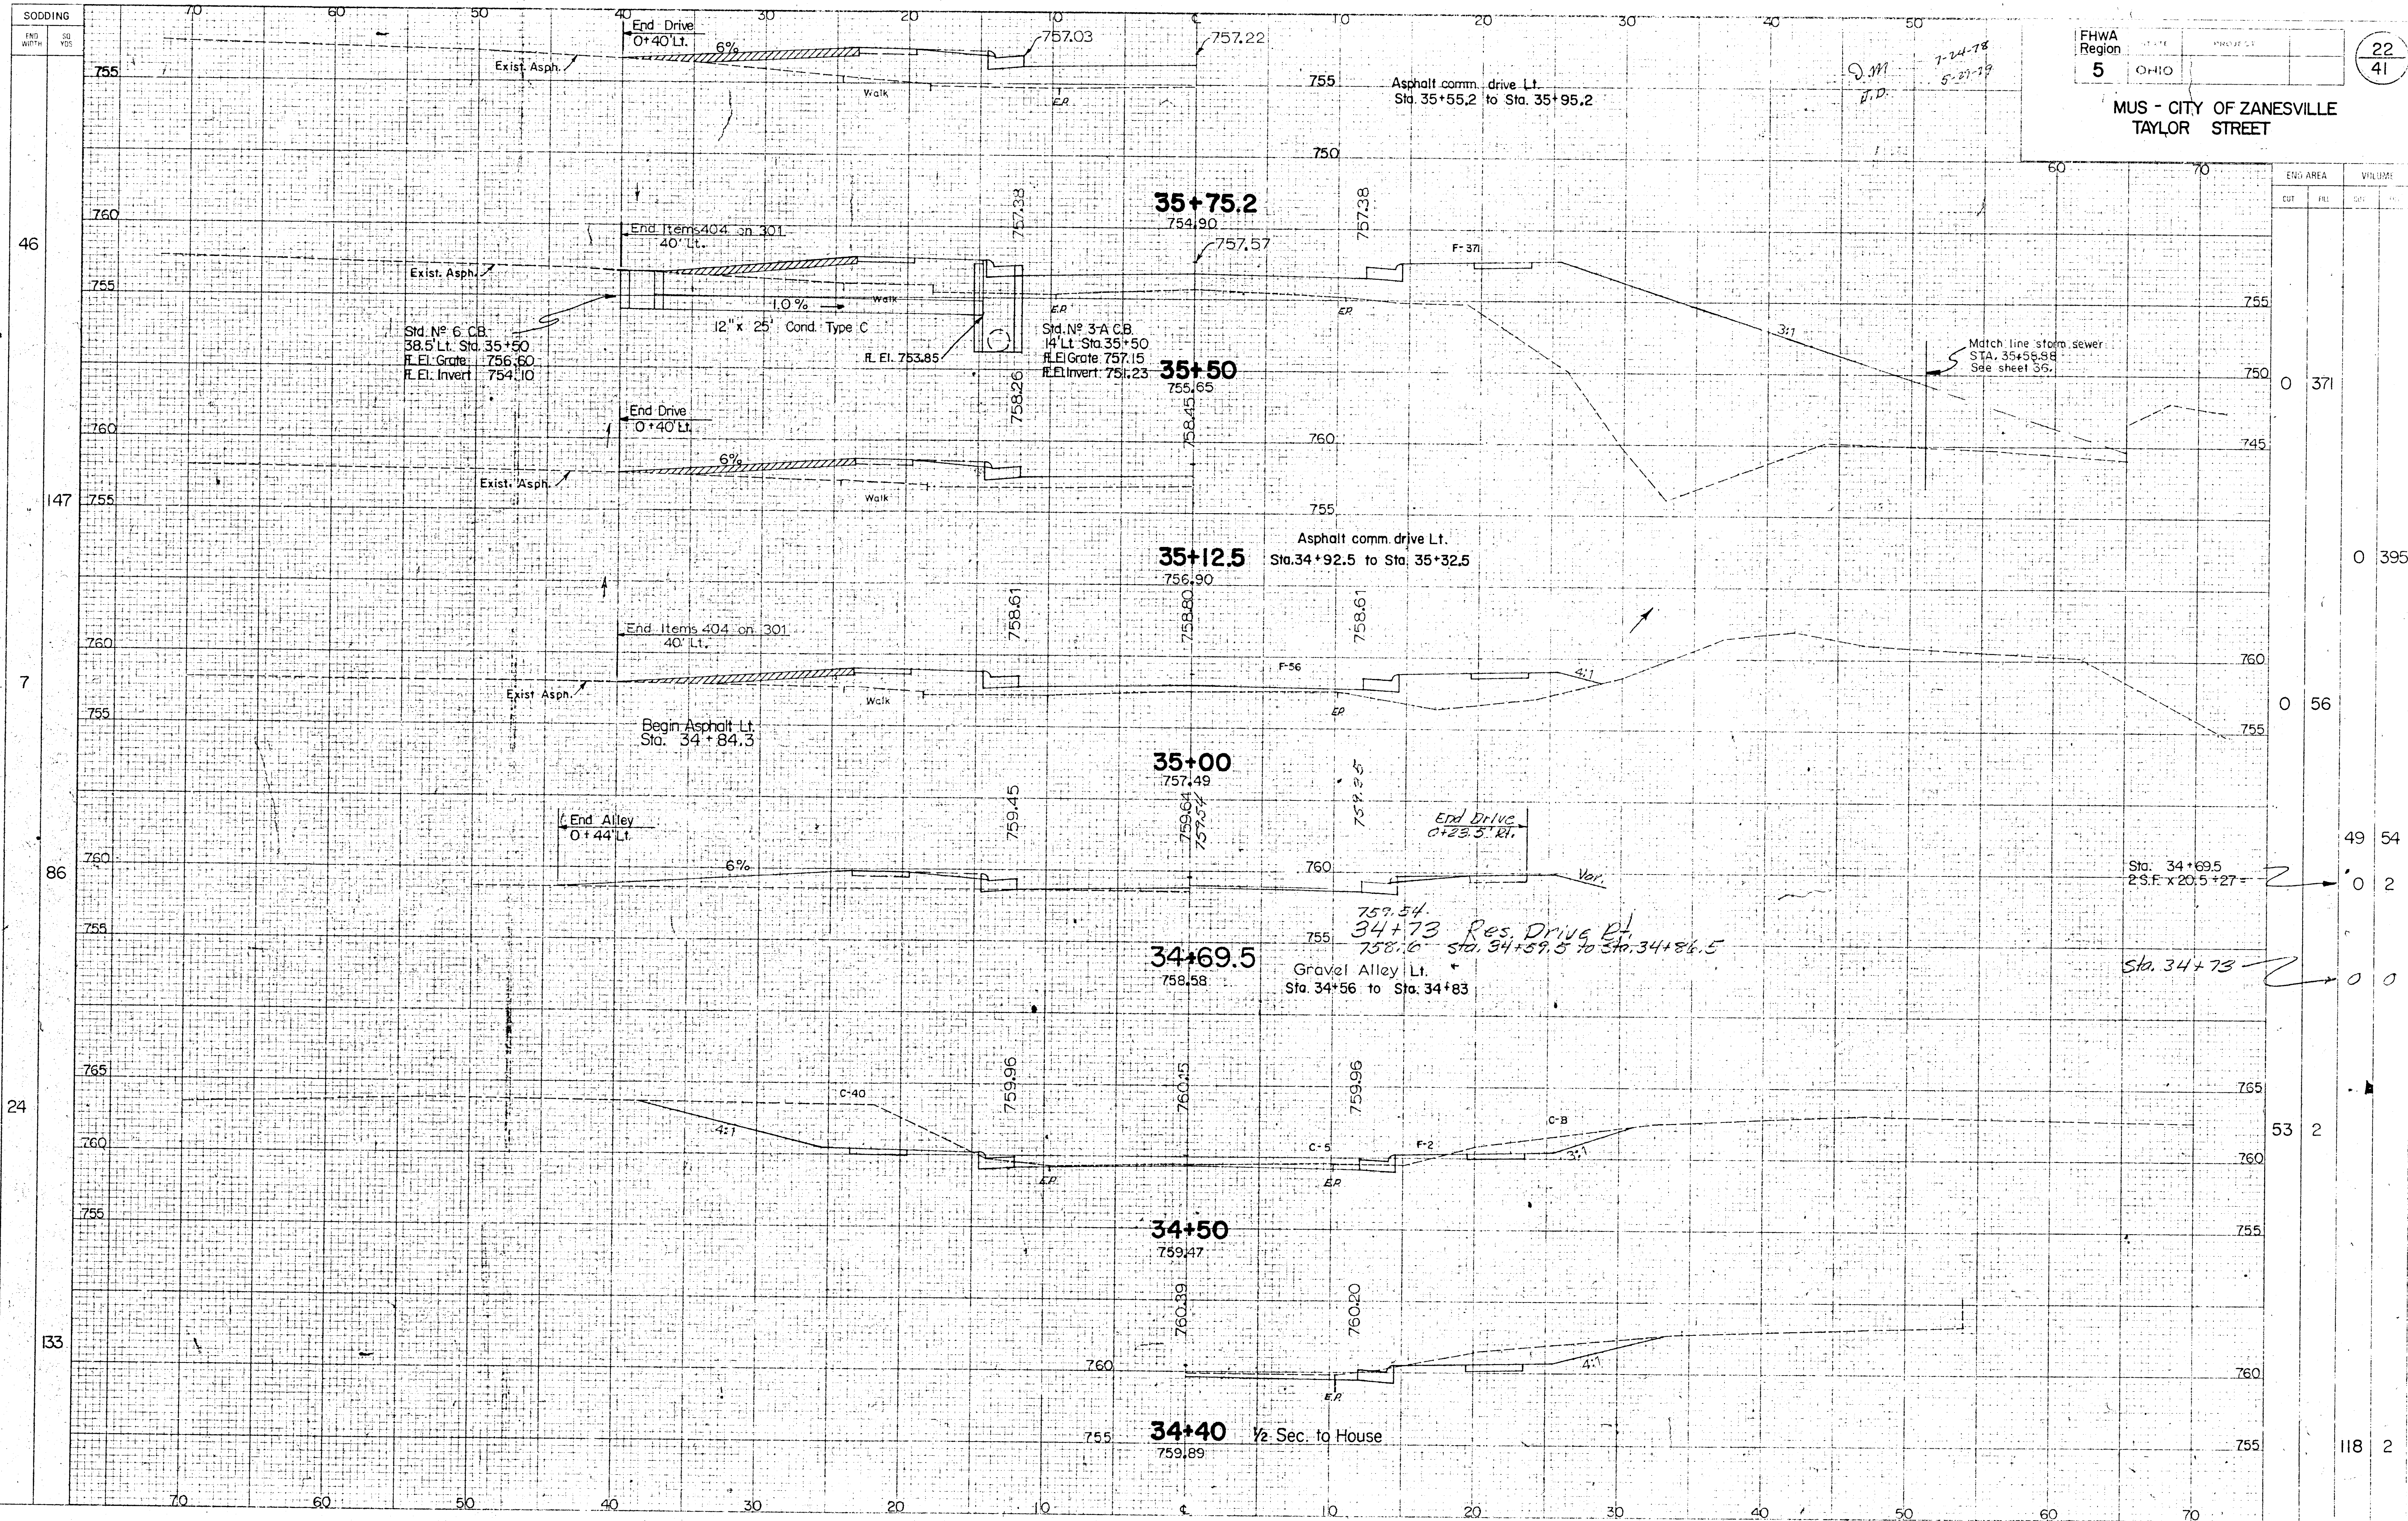

DATE	5-1-74
BY	B.H.
CHECKED	W.D.
DESIGNED	C.M.
IN CHARGE	C.P.
DATE	8-13-78
BY	W.L.
CHECKED	D.M.
DESIGNED	3-8-78