



BENCH MARKS (Left Edge of Exist. Pav't)	
Station	Elevation
1094+00	789.07
1111+00	790.77
1119+00	787.57

REMOVAL		(R)	
Mark	Station	Side	Rem & Disp. Curb & Gutter Lin. Ft.
From	To		
MUSKINGUM COUNTY			
1	1111+00	1112+93 Rt.	198
2	1114+03	1116+98 Rt.	295
3	1117+03	1119+98 Rt.	295
4	1113+45	1113+98 Rt.	53
Total			841

GUARD RAIL		(G)	
Mark	Station	Side	Lin. Ft.
From	To		
MUSKINGUM COUNTY			
1-G	1097+50	1099+53 Lt.	208
2-G	1117+75	1120+00 Lt.	225
3-G	1117+75	1120+00 Rt.	225
Total			658

FED. RD. DIVISION	STATE	PROJECT	TYPE FUNDS
2	OHIO	F-633-10	Post War


24
88

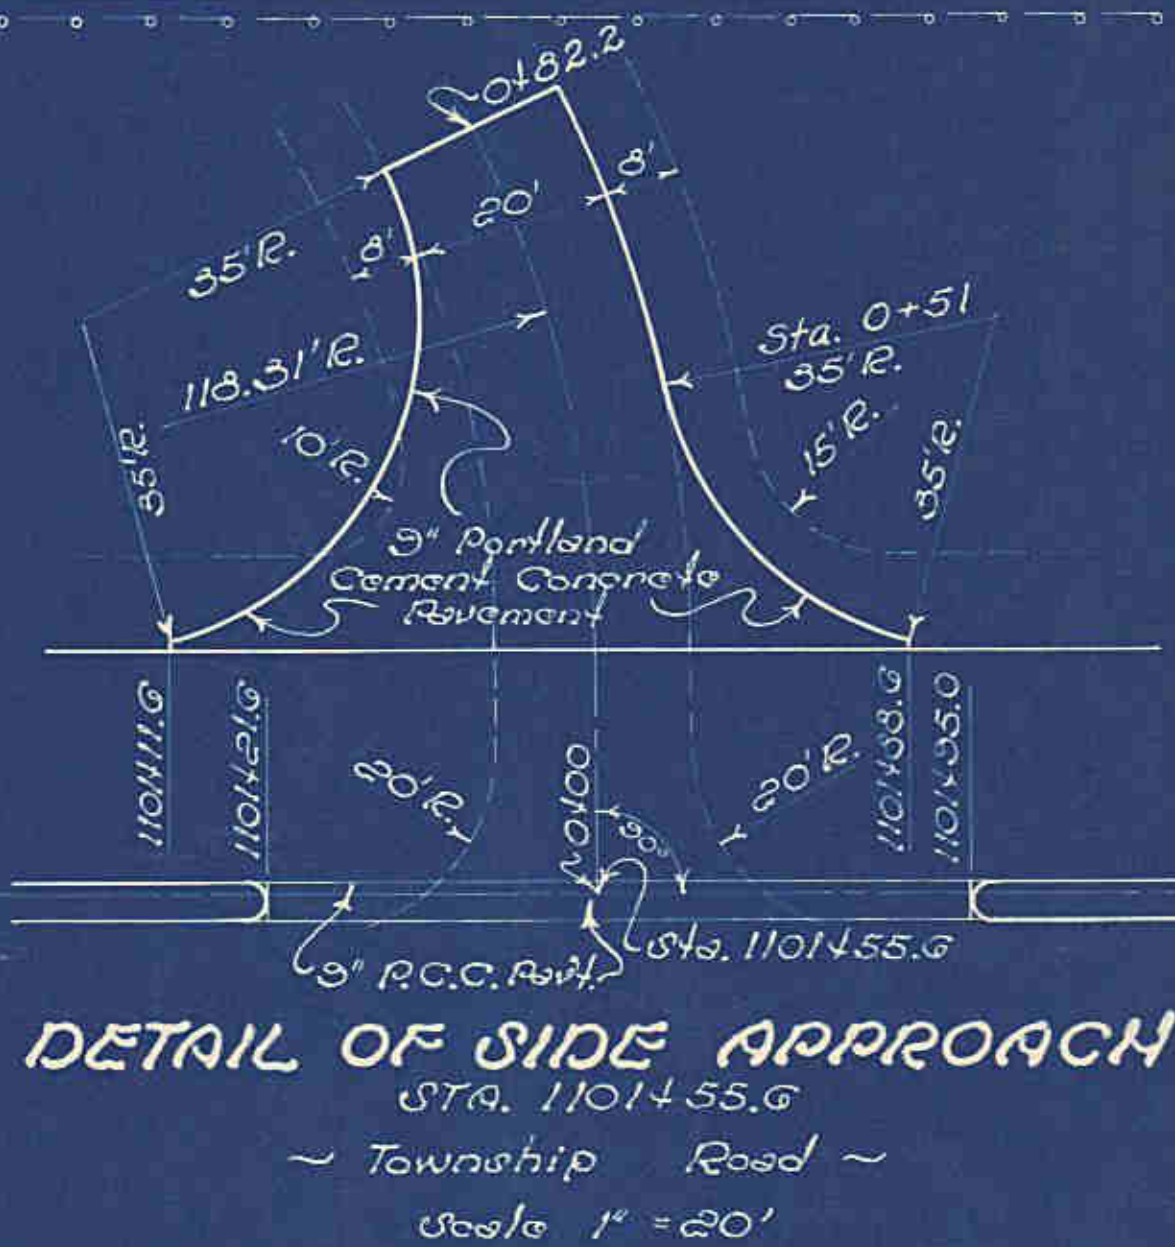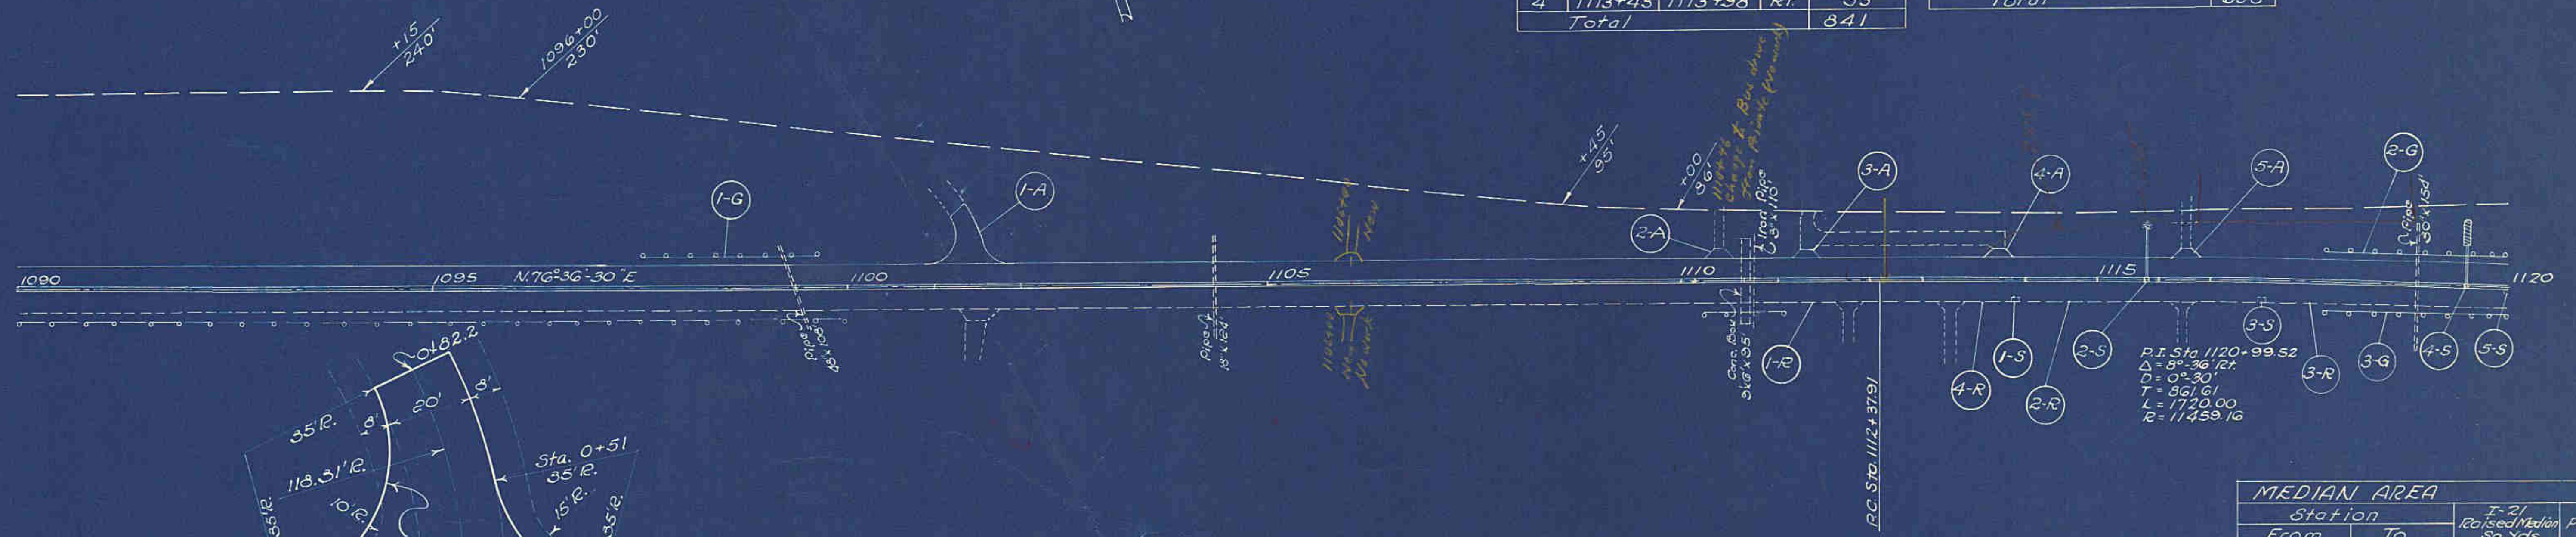

CATCH BASINS & OUTLETS										(5)	
Mark	Station	I-8 Catch Basins Each		I-16 Catch Basins Abandoned Each		I-2 Storm Sewer Under Pav't Lin. Ft.		I-2 Storm Sewer Lin. Ft.		I-10 Rip-Rap Type "A" Sq. Yds.	I-14 Paved Gutter Lin. Ft.
		3Grate	4Grate			8"	12"	8"	12"		
MUSKINGUM COUNTY											
1	1114+00				1						
2	1115+55	1				64				1	
3	1117+00				1						
4	1119+50		1			54					36
5	1120+00				1						
Totals		1	1		3	118				1	36

DRIVES & APPROACHES							(A)		
Mark	Station	Side	T-70	I-17	SS-5	E-8			
			P.C.C.		Class.	Pav't. Removal			
			Pav't.	Aggregate	Emb.	Sq.Yds.			
			Sq.Yds	Cu.Yds.	Cu.Yds		T-35	T-70	B-20
MUSKINGUM COUNTY									
1	1101+556	Lt.	202.45		37				212
2	1110+46	Lt.		2					
3	1111+49	Lt.		2					
4	1113+82	Lt.		2					
5	1116+05	Lt.		2					
Totals			202.45	8	37				212

MEDIAN AREA		T-21 Raised Median Sq. Yds.		T-10 P.C.C. Pav't. Sq. Yds.	
Station	From To				
MUSKINGUM COUNTY					
1090+00.0	1101+21.6	498.5			
1101+21.6	1101+95.0			32.6	
1101+95.0	1110+13.0	363.6			
1110+13.0	1110+19.0			29.3	
1110+19.0	1111+16.0	16.4			
1111+16.0	1112+30.0			50.7	
1112+30.0	1112+89.0	26.2			
1112+89.0	1114+15.0			56.0	
1114+15.0	1115+51.0	60.4			
1115+51.0	1115+70.0	9.3			
1115+70.0	1116+38.0			30.2	
1116+38.0	1119+44.86	136.4			
1119+44.86	1120+00.0	19.9			
Totals		1130.7		198.8	

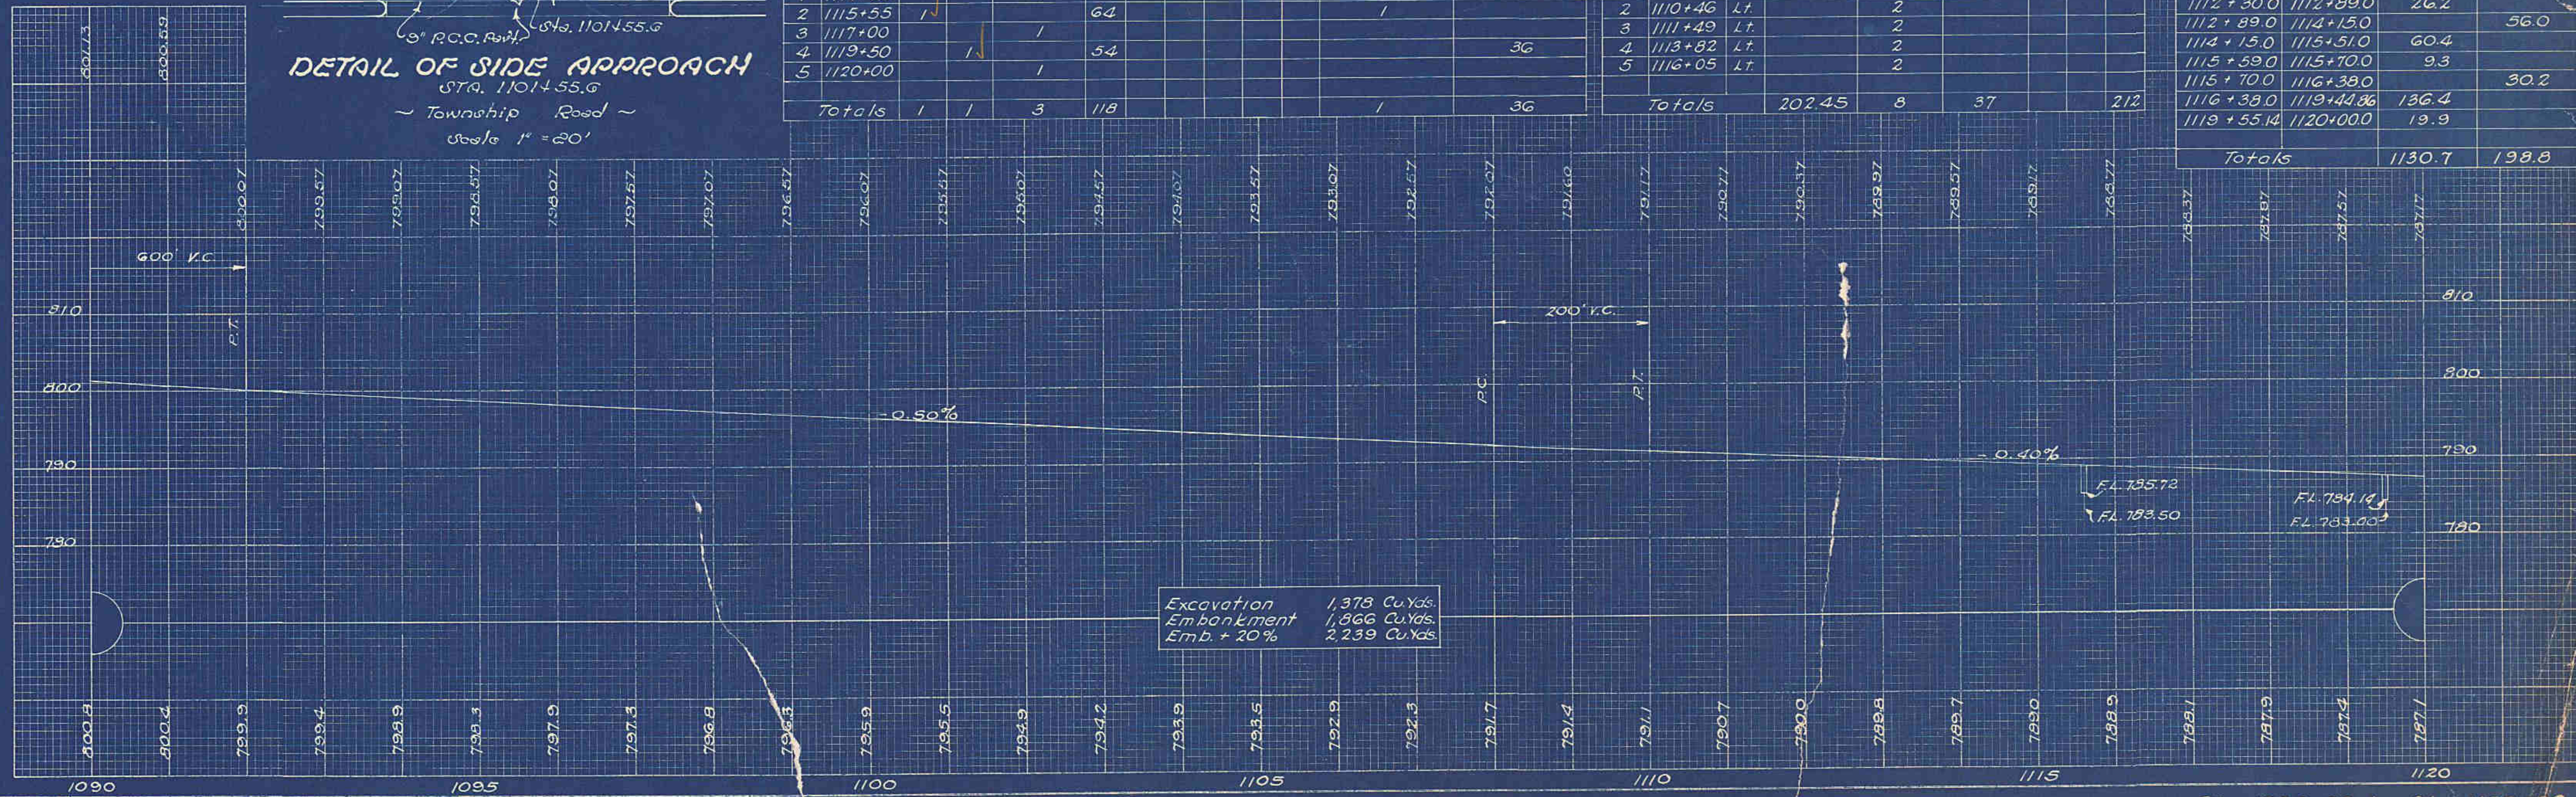

Sta. 1090+00 to Sta. 1120+00