


| BENCH MARKS<br>(Left Edge of Exist. Pavt.) |           |
|--------------------------------------------|-----------|
| Station                                    | Elevation |
| 1128+00                                    | 783.97    |
| 1141+00                                    | 776.37    |

| FED. RD. DIVISION | STATE | PROJECT  | TYPE FUNDS | 25 |
|-------------------|-------|----------|------------|----|
| 2                 | OHIO  | F-633-10 | Post War   | 88 |

LIC-40-28.53  
MUS-40-0.00-5.03

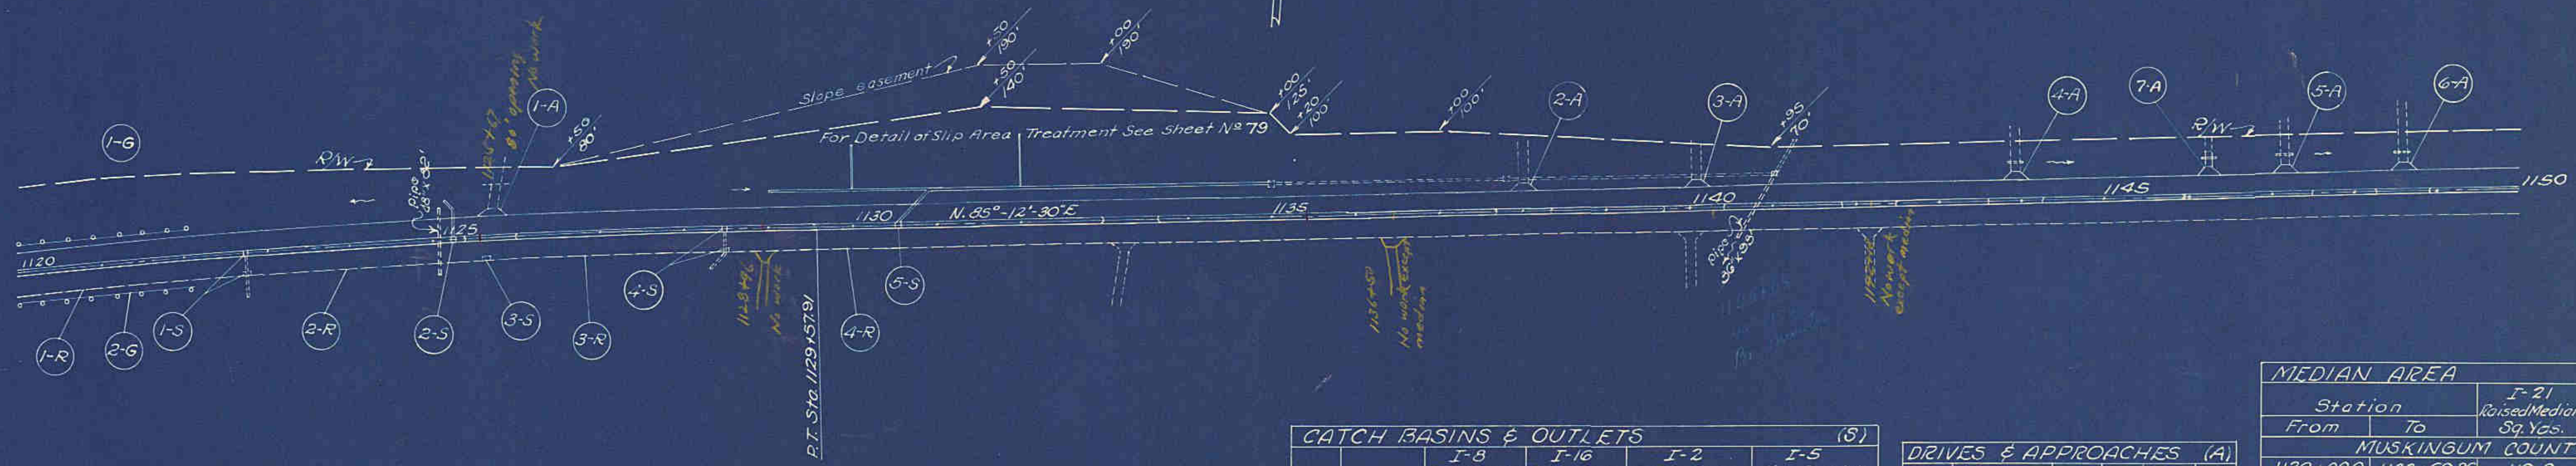


| GUARD RAIL (G)   |         |             |          |
|------------------|---------|-------------|----------|
| Mark             | Station | Side        | Lin. Ft. |
| From             | To      |             |          |
| MUSKINGUM COUNTY |         |             |          |
| 1-G              | 1120+00 | 1122+07 Lt. | 207      |
| 2-G              | 1120+00 | 1122+07 Rt. | 207      |
| Total            |         |             | 414      |

| REMOVAL (R)      |         |             |                                     |
|------------------|---------|-------------|-------------------------------------|
| Mark             | Station | Side        | Rem. & Disp. Curbed Gutter Lin. Ft. |
| From             | To      |             |                                     |
| MUSKINGUM COUNTY |         |             |                                     |
| 1                | 1120+03 | 1122+73 Rt. | 270.0                               |
| 2                | 1122+78 | 1125+48 Rt. | 270.0                               |
| 3                | 1125+53 | 1128+48 Rt. | 295.0                               |
| 4                | 1128+53 | 1131+50 Rt. | 297.0                               |
| Total            |         |             | 1132.0                              |

| CATCH BASINS & OUTLETS (S) |         |                       |                                  |                                      |                        |   |
|----------------------------|---------|-----------------------|----------------------------------|--------------------------------------|------------------------|---|
| Mark                       | Station | I-8 Catch Basins Each | I-16 Catch Basins Abandoned Each | I-2 Storm Sewer Under Pavt. Lin. Ft. | I-5 Pipe Specials Each |   |
| MUSKINGUM COUNTY           |         |                       |                                  |                                      |                        |   |
| 1                          | 1122+75 | 1                     | 1                                | 4                                    |                        |   |
| 2                          | 1125+20 | 1                     |                                  | 52                                   | 1                      |   |
| 3                          | 1125+50 |                       | 1                                |                                      |                        |   |
| 4                          | 1128+50 | 1                     | 1                                | 4                                    |                        |   |
| 5                          | 1130+50 | 1                     |                                  | 56                                   | 1                      |   |
| Totals                     |         | 3                     | 3                                | 108                                  | 3                      | 1 |

| DRIVES & APPROACHES (A) |         |      |               |                        |               |               |
|-------------------------|---------|------|---------------|------------------------|---------------|---------------|
| Mark                    | Station | Side | I-17          | I-12                   | Pipe          |               |
|                         |         |      | Agg<br>Cu Yds | Rem. &<br>Disp. Lin Ft | 12"<br>Lin Ft | 18"<br>Lin Ft |
| MUSKINGUM COUNTY        |         |      |               |                        |               |               |
| 1                       | 1125+67 | Lt.  | 2             |                        |               |               |
| 2                       | 1138+00 | Lt.  | 2             |                        |               |               |
| 3                       | 1140+11 | Lt   | 2             |                        |               |               |
| 4                       | 1143+80 | Lt.  | 2             |                        |               |               |
| 5                       | 1147+15 | Lt.  | 2             |                        |               |               |
| 6                       | 1148+60 | Lt   | 2             |                        |               |               |
| 7                       | 1146+25 | Lt   | 2             | 22                     | 24            |               |
| Total                   |         |      | 14            | 22                     | 24            |               |

| MEDIAN AREA      |            |        |                        |
|------------------|------------|--------|------------------------|
| Station          | From       | To     | Raised Median Sq. Yds. |
| MUSKINGUM COUNTY |            |        |                        |
| 1120+00          | 1122+69.86 | 119.9  |                        |
| 1122+80.14       | 1125+14.86 | 104.3  |                        |
| 1125+25.14       | 1125+34.0  | 3.9    |                        |
| 1125+34.0        | 1126+00.0  |        | 29.3                   |
| 1126+00.0        | 1128+44.86 | 108.8  |                        |
| 1128+55.14       | 1130+46.0  | 102.6  |                        |
| 1130+54.0        | 1132+96.0  | 107.6  |                        |
| 1132+96.0        | 1133+62.0  |        | 29.3                   |
| 1133+62.0        | 1137+67.0  | 180.0  |                        |
| 1137+67.0        | 1138+33.0  |        | 29.3                   |
| 1138+33.0        | 1139+67.0  | 59.6   |                        |
| 1139+67.0        | 1140+44.0  |        | 34.2                   |
| 1140+44.0        | 1141+85.0  | 62.7   |                        |
| 1141+85.0        | 1142+51.0  |        | 29.3                   |
| 1142+51.0        | 1143+57.0  | 47.1   |                        |
| 1143+57.0        | 1144+23.0  |        | 29.3                   |
| 1144+23.0        | 1145+92.0  | 75.1   |                        |
| 1145+92.0        | 1147+48.0  |        | 69.3                   |
| 1147+48.0        | 1148+27.0  | 35.1   |                        |
| 1148+27.0        | 1148+93.0  |        | 29.3                   |
| 1148+93.0        | 1149+75.0  | 36.4   |                        |
| 1149+75.0        | 1150+00.0  |        | 11.1                   |
| Totals           |            | 1043.1 | 290.4                  |

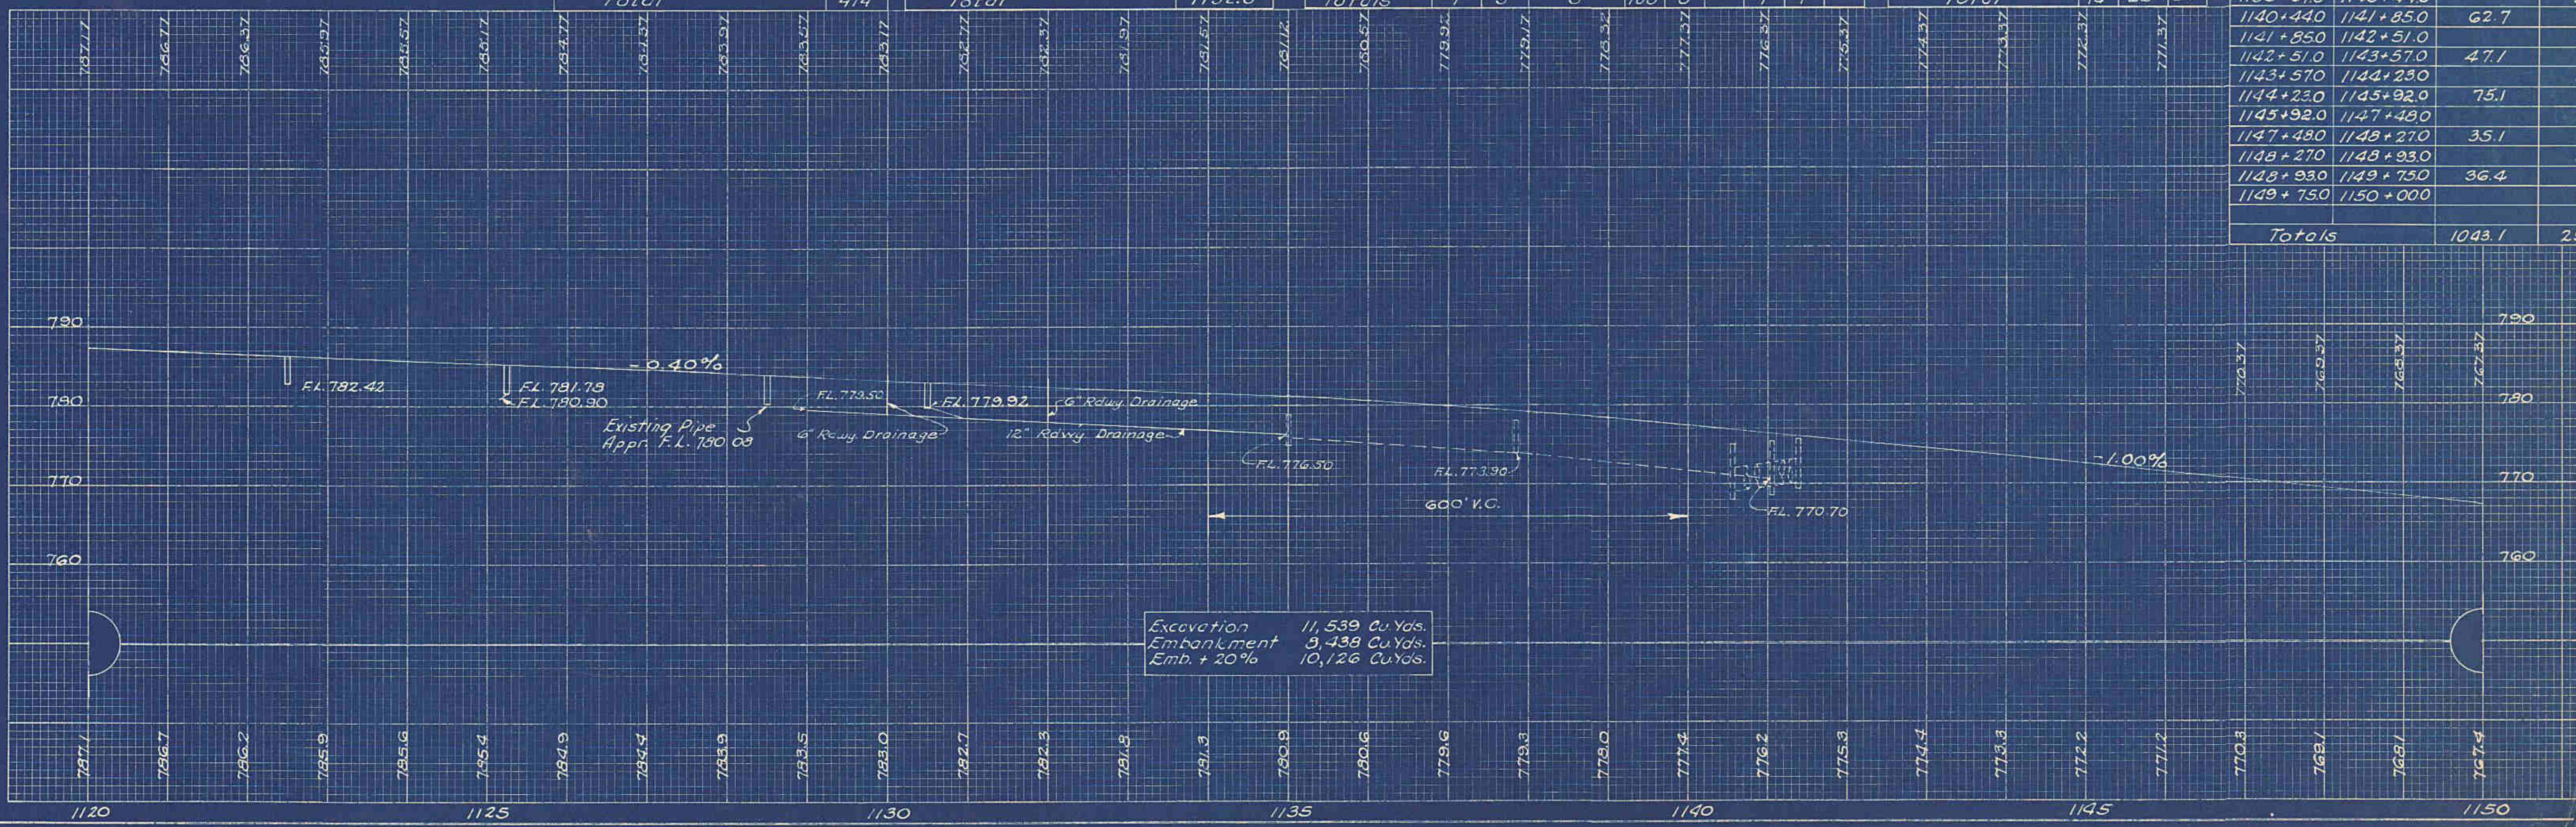

Sta. 1120 to Sta. 1150+00