

ROADWAY DRAINAGE (D)

Item No	Station	Side	Pipe for Storm Sewers under Roadway Lin. Ft.	Outlet Pipe for Storm Sewers Lin. Ft.
1-D	1076+00	Rt	26	28

CATCH BASINS (I)

Item No	Station	Side	Catch Basins
1-I	1076+00	Lt	1

CONCRETE CURB & GUTTER (C)



Item No	Station	Side	Type 4 Integral Concrete Curb & Gutter Lin. Ft.
1-C	1071+00	Lt	790.0

DRIVES & APPROACHES (A)

Item No	Station	Side	5' W.B. Macadam Surf. Tr. Bound. Side Approach	Pipe for Driveway Lin. Ft.	Details on Sheet No
1-A	1077+50	Lt	16	6.8	28
2-A	1077+50	Rt	16	8.0	34
Totals			32	14.8	28 34

STRUCTURES 20' SPAN & UNDER

Struct No	Station	Description	Details on Sheet No
10	1073+00	18" x 124.9" Std. Pipe Culvert with Std. No. 3 Mod.	C.B. 152
12	1079+00	18" x 133.9" Std. Pipe Culvert with Std. No. 3 Mod.	C.B. 152
11	1076+50	4" x 200' Wrought Iron Pipe Casing	144

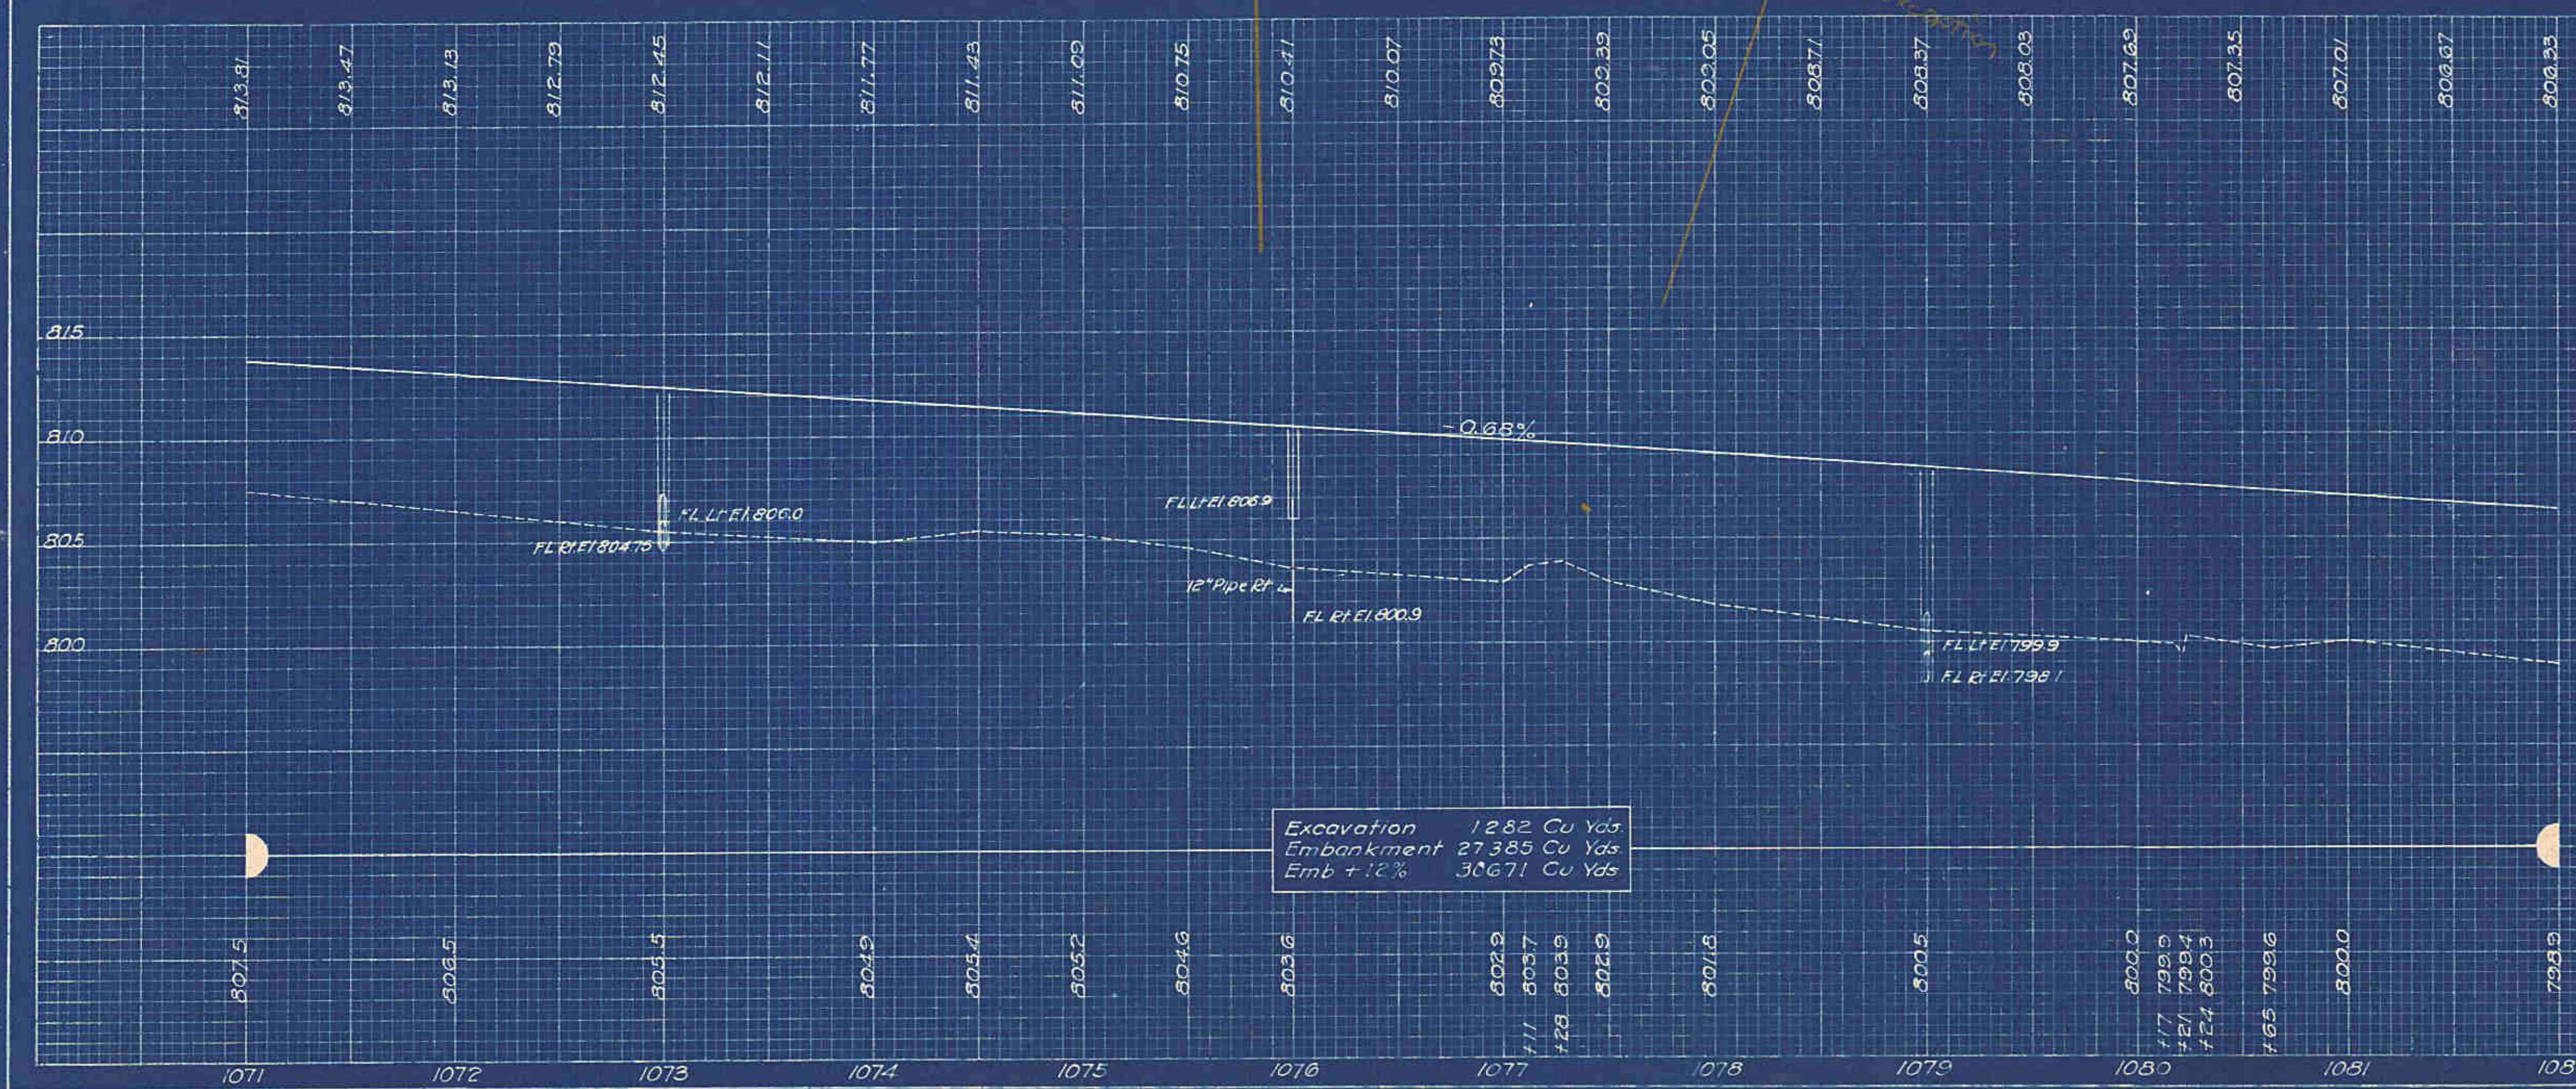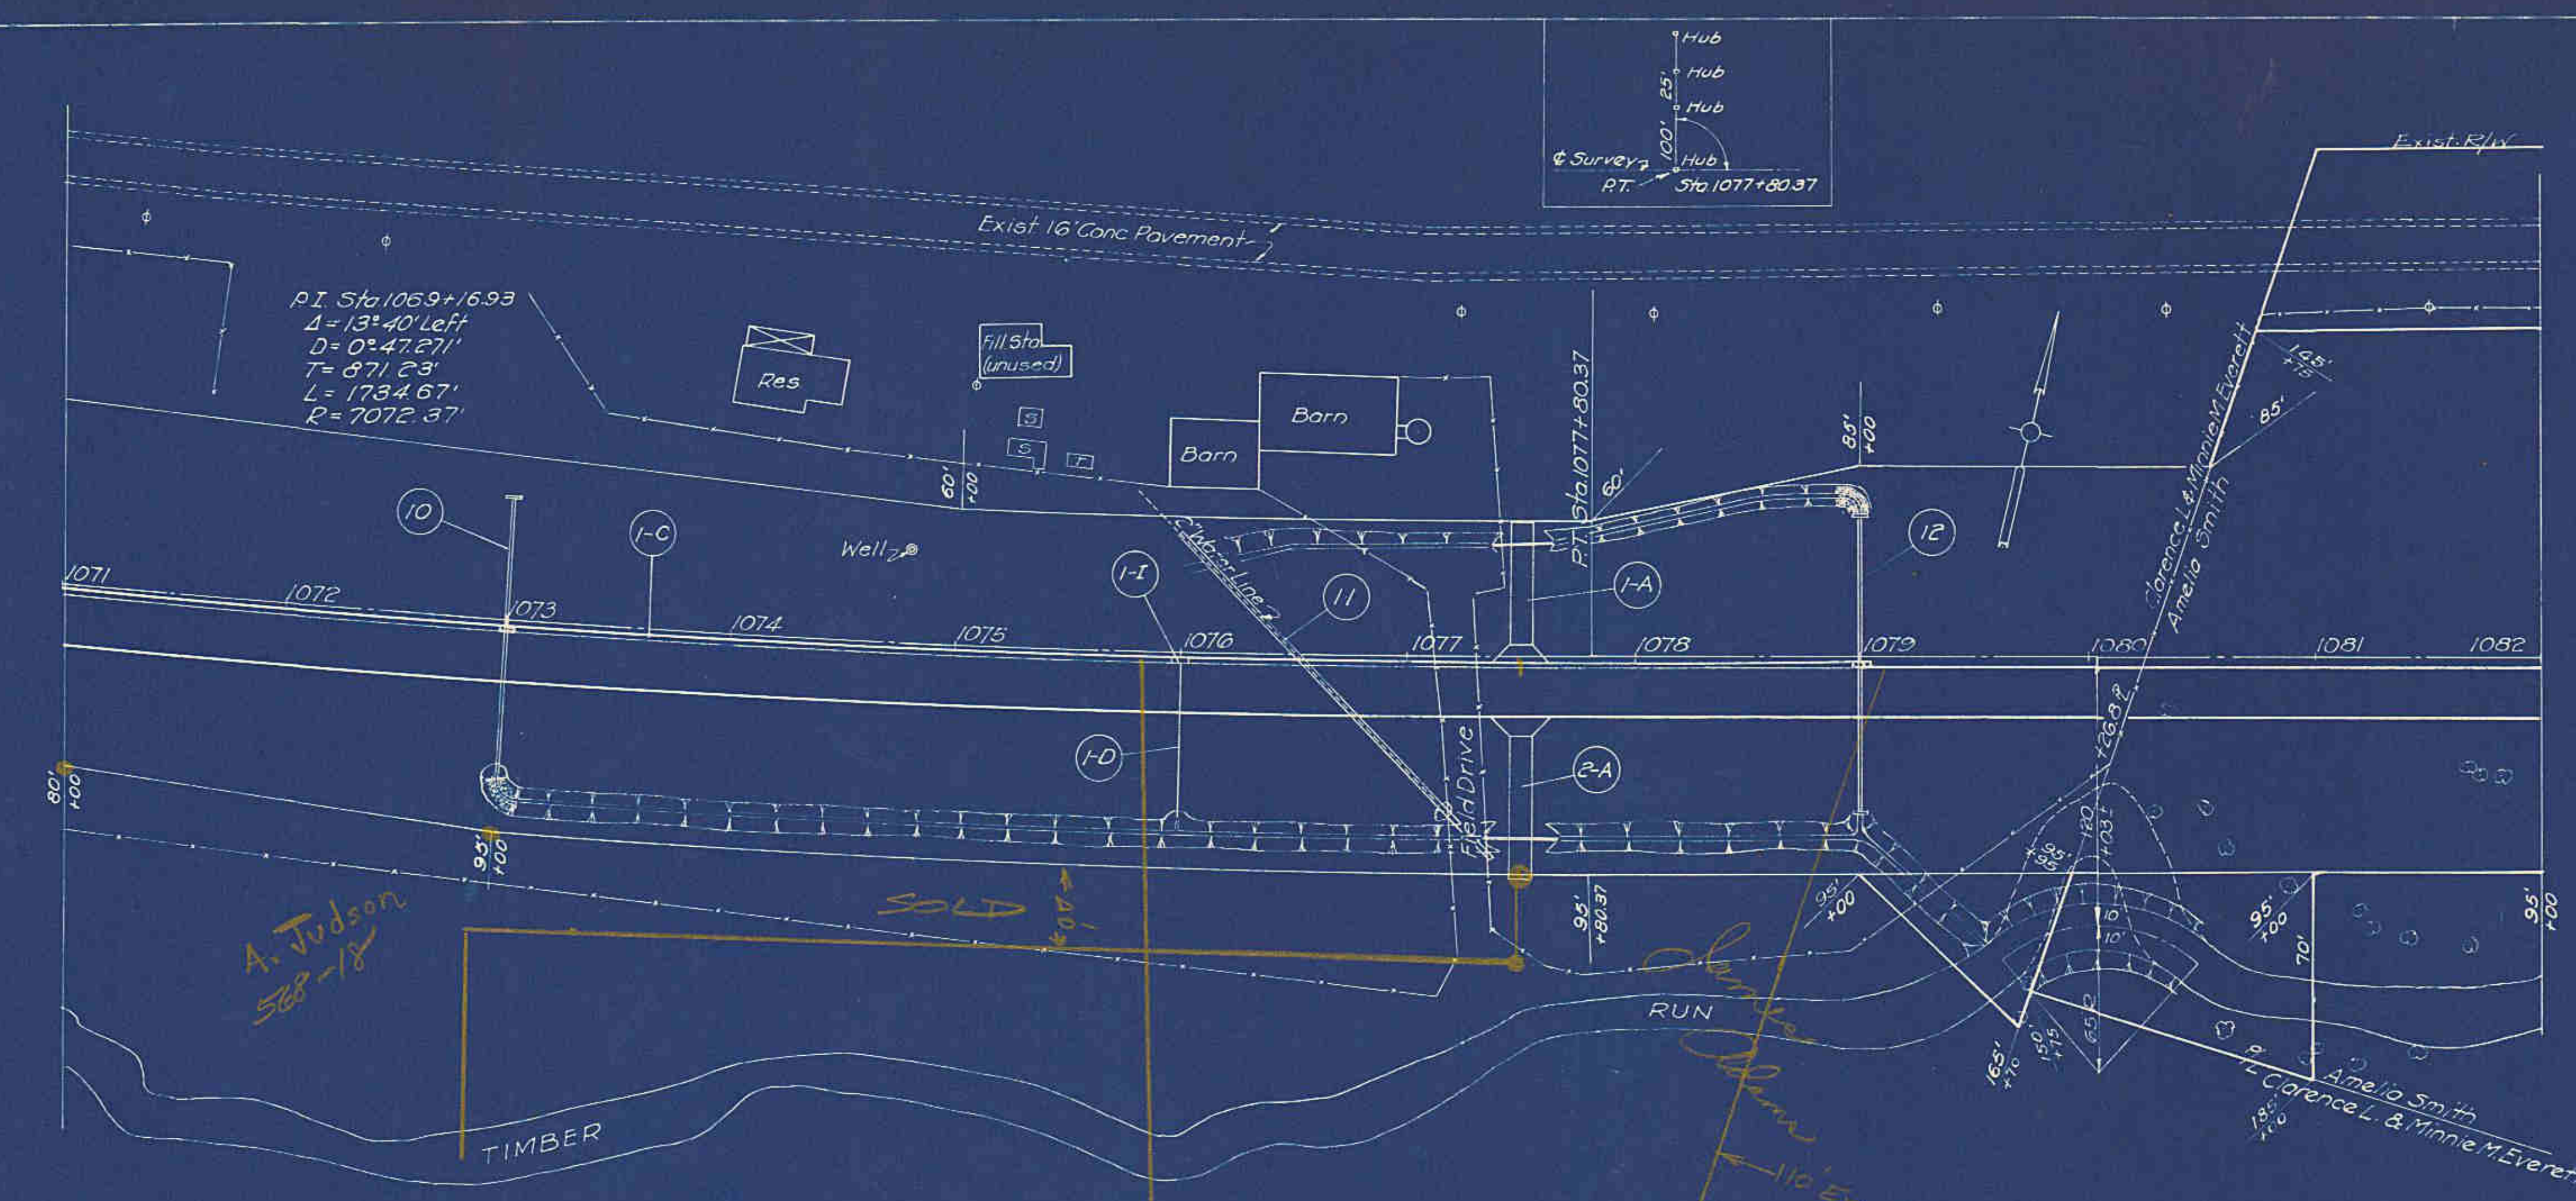

Sta 1071+00 to Sta 1082+00