


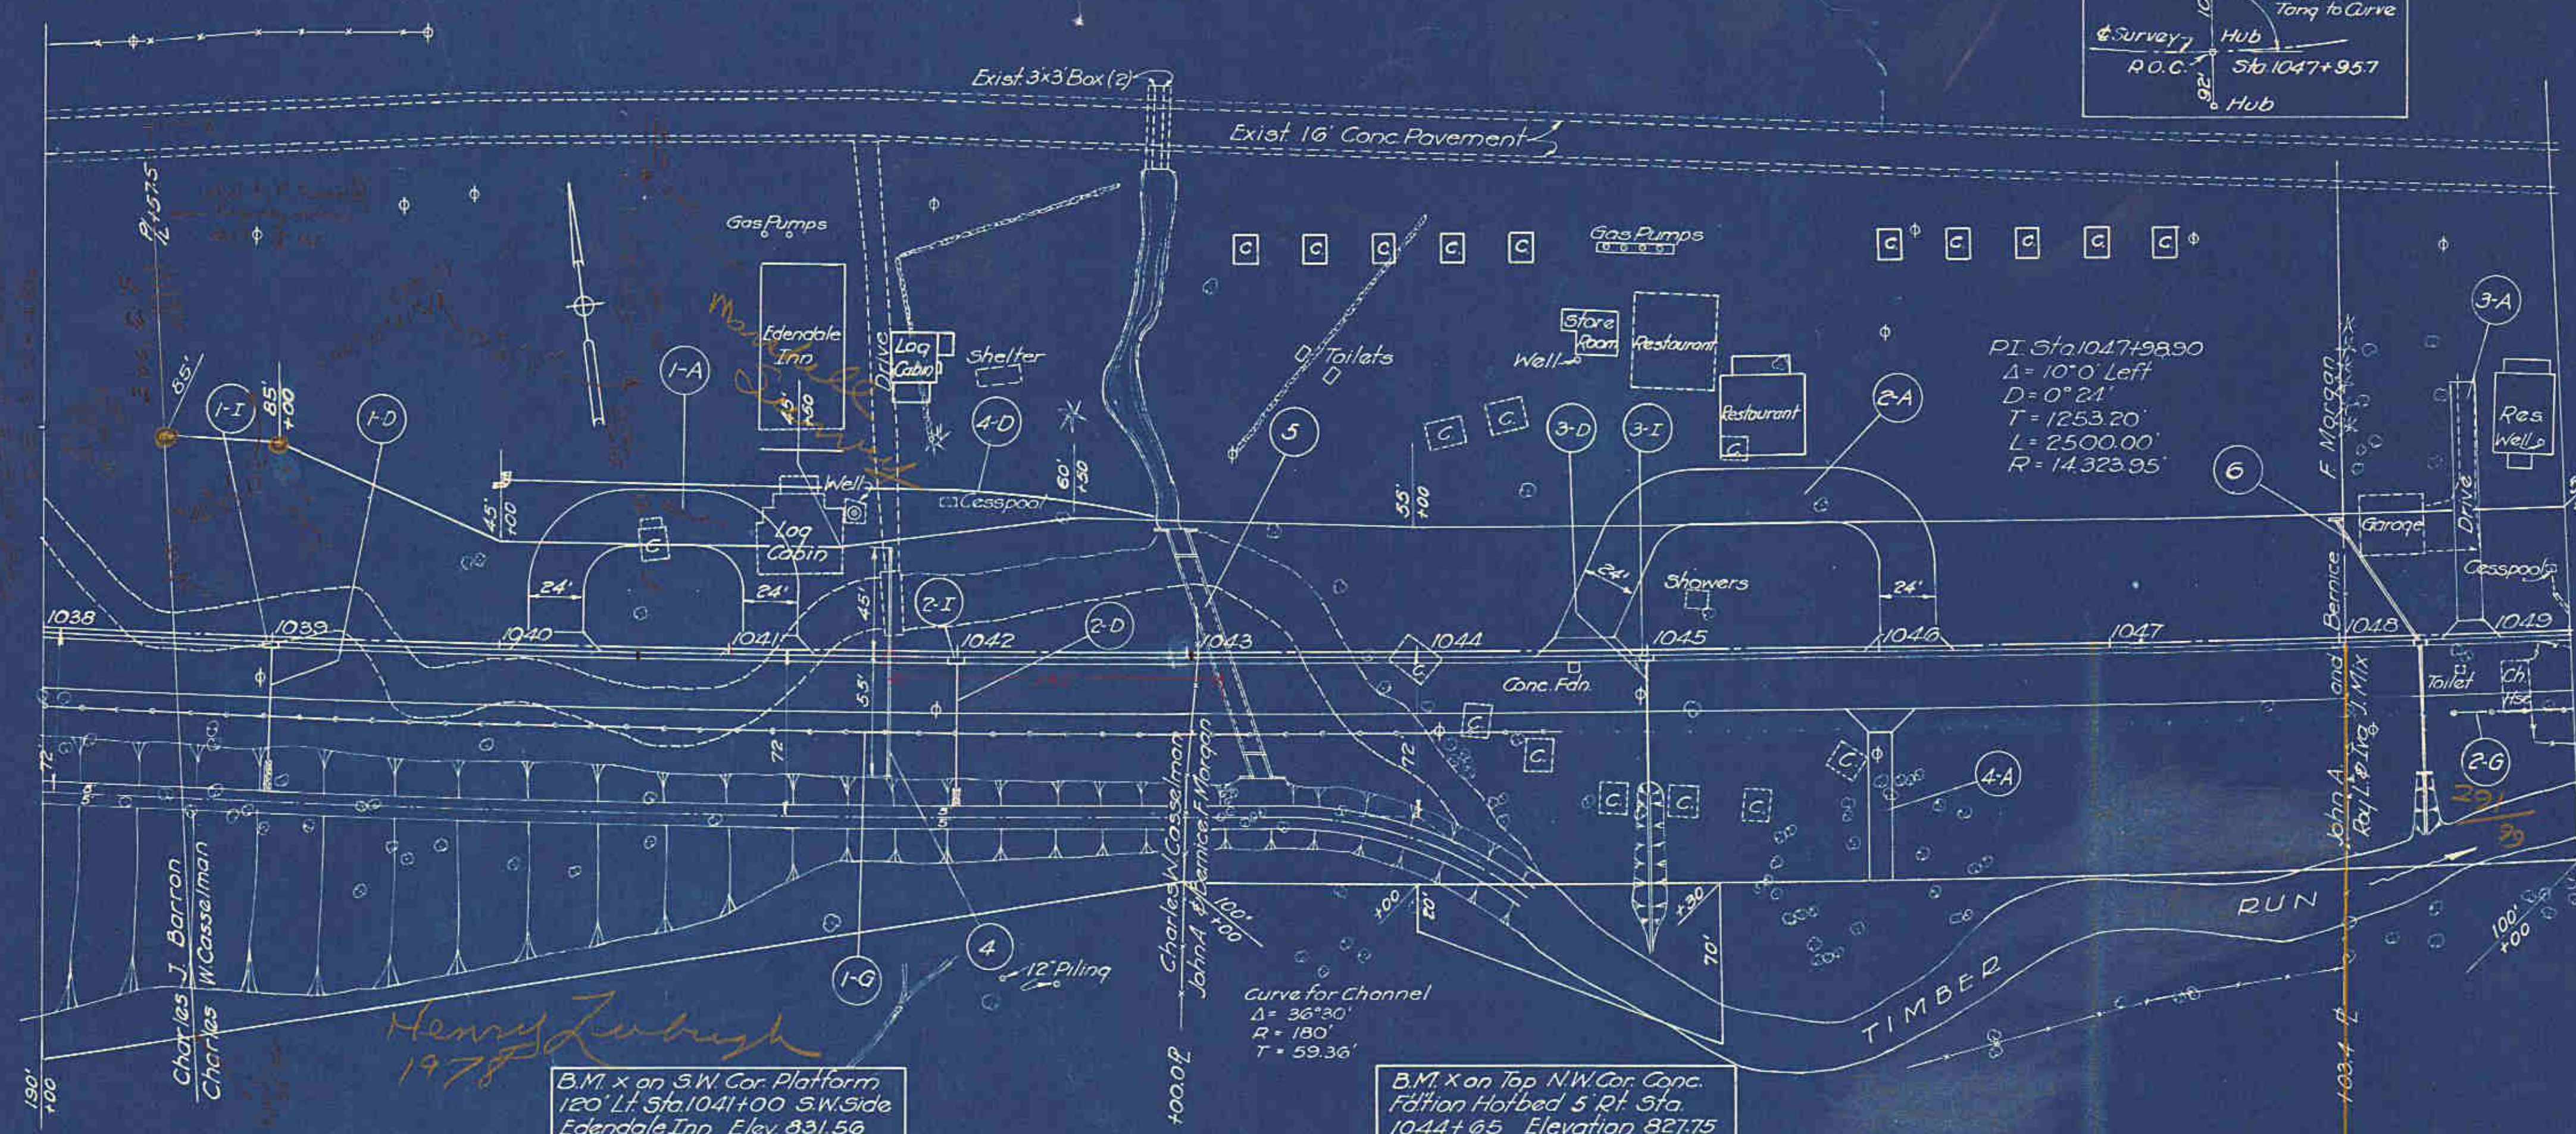

ROADWAY DRAINAGE (D)									
Item No.	Station		Side	Pipe for Storm Sewers under Roadway		Outlet Pipe for Storm Sewers	Riprap	Roadway Drainage	
	From	To		Part. Lin. Ft.	12" Lin. Ft.	12" Lin. Ft.	Sq. Yds.	Pipe Lin. Ft.	Outlet Pipe Lin. Ft.
1-D	1039+00		Rt	26		24	5		
2-D	1042+00		Rt	26		30	3		
3-D	1045+00		Rt	26		32			
4-D	1040+00	1042+90	Lt.				3 *	270	20
Totals				78		86	11	270	20

* At inlet - Form as an L-shaped headwall

CATCH BASINS (I)				
Item No.	Station	Side	Catch Basins	
			5" W.B. Macadam	Side
1-I	1039+00	Lt.	1	
2-I	1042+00	Lt.	1	
3-I	1045+00	Lt.	1	
Totals			3	

CONCRETE CURB & GUTTER (C)				
Item No.	Station		Side	Type 4 Integral Conc. Curb & Gutter Lin. Ft.
	From	To		
1-C	1038+00	1049+00	Lt.	1080.0
Totals				

DRIVES & APPROACHES (A)					
Item No.	Station	Side	5" W.B. Macadam		Details on Sheet No.
			Surf. Ft. Sq. Yds.	Side Approach Sq. Yds.	
1-A	1040+00	Lt.	57	50	
2-A	1041+19	Lt.	59	66	
3-A	1048+58	Lt.	16	13	
4-A	1046+00	Rt.	22.2	7.8	
Totals			154.2	136.8	

GUARD RAIL (G)				
Item No.	Station		Side	Guard Rail Lin. Ft.
	From	To		
1-G	1038+00	1044+55.93	Rt	657.4
2-G	1048+50	1049+00	Rt	50
Totals				707.4

STRUCTURES 20 FT. SPAN & UNDER				
Struct. No.	Station	Description		Details on Sheet No.
5	1043+15	9'-0" x 7'-0" x 117'-0" Large Box Culvert		147
6	1048+35	15" x 12'-9" Std. Pipe Culvert with 5th No. 3 Mod. C.B.		148
4	1041+70	Place 100 Lin. Ft. 4" Wrought Iron Pipe Casing as shown (No detail) Removal of existing structure - Lump See Note.		

