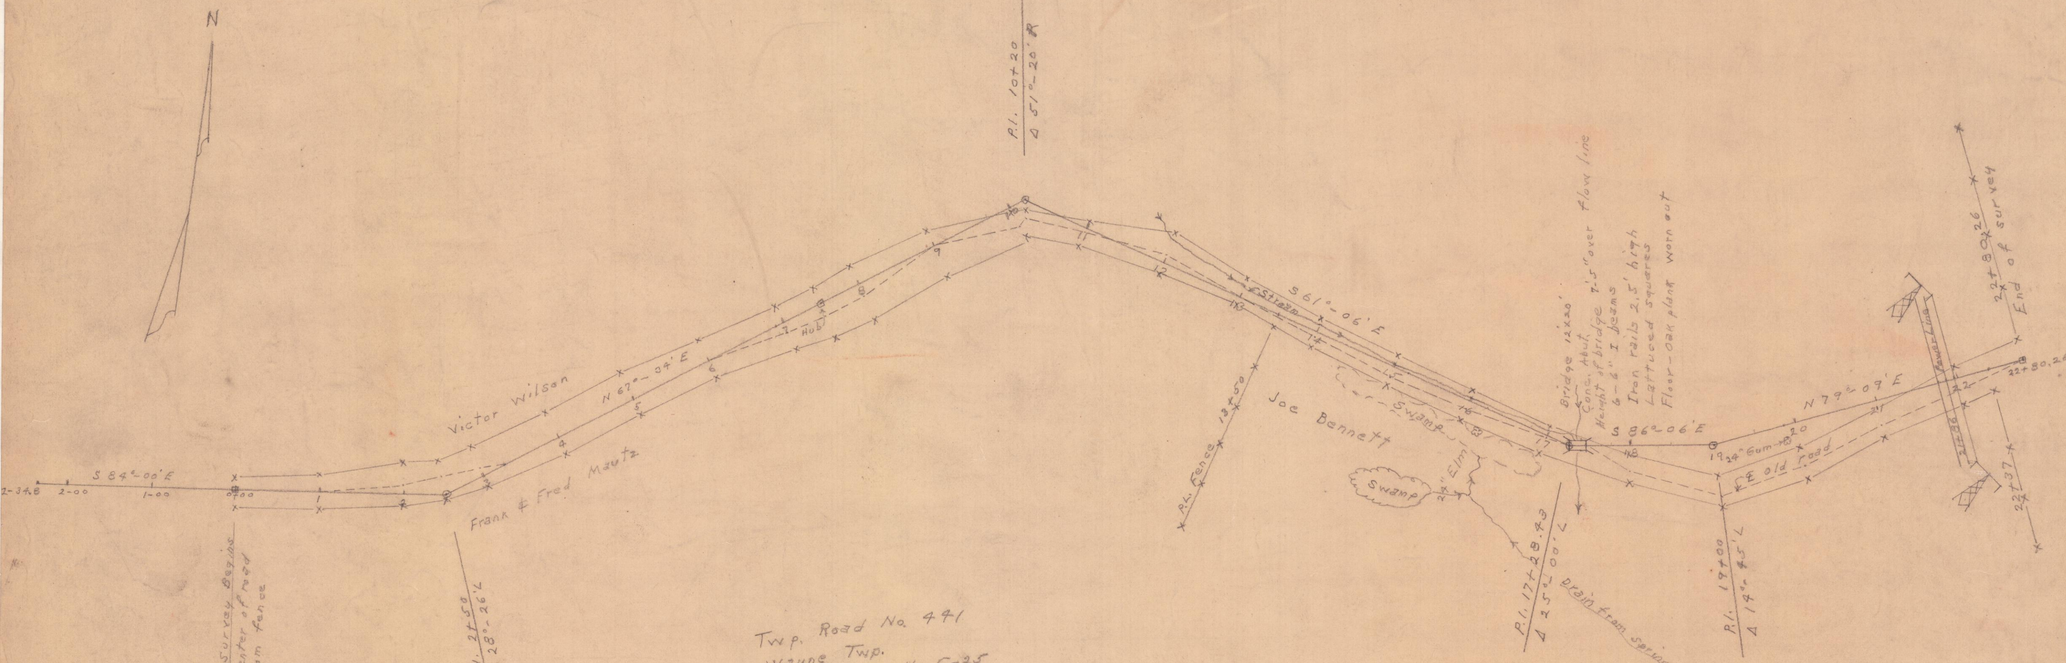
N
P.I. 10+20
Δ 51°-20' Rt
Victor Wilson
N 67°-04' E
Hub
S 84°-09' E
2-34.6
2-00
1-00
0+00 Survey Begins
Hub in center of road
20' from fence
Frank & Fred Mautz
P.I. 2+59
Δ 28°-26' Rt
Twp. Road No. 441
Wayne Twp.
Field Book No. C-25
Scale 1" = 100'
6-13-50
S 61°-06' E
Fence
Swamp
Rt. Fence 13+59
Joe Bennett
Swamp
Elm
Bridge 12'x30'
Conc. Abut.
Height of Bridge 7'-5" over Flow line
6-24" I Beams
Iron rails 2.5" high
Latticed Squares
Floor - Oak plank Worn out
S 86°-06' E
P.I. 17+28.43
Δ 25°-00'-L
Drain from Spring
N 77°-07' E
19+20 Gum
20
Lt. Old Road
P.I. 19+00
Δ 19°-45'-L
22+80.26
End of survey
22+37