



STA	LEFT ELEV	RIGHT
110+50	262.5	263.0
110+75	262.0	262.3
111+00	261.7	262.3
111+50	259.7	260.3
112+00	258.4	259.0
112+50	256.7	257.3
113+00	254.9	255.5
113+50	253.2	253.0
113+75	252.6	252.9
114+00	251.5	252.0

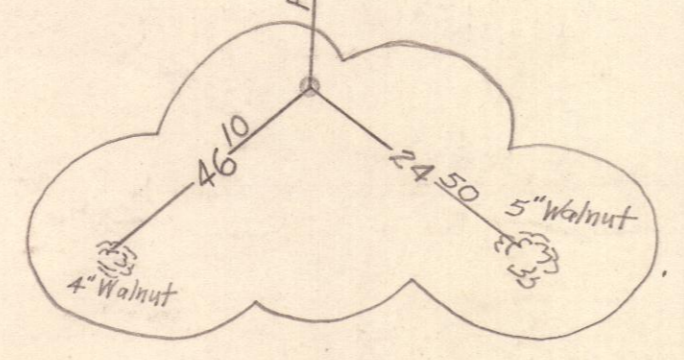

BM#4 27381  
Spike in 18" Cherry  
100 to Rt. Sta. 106+50

BM#5 25020  
Spike in Telephone  
Pole to Rt. of Rd.  
Sta. 115+07

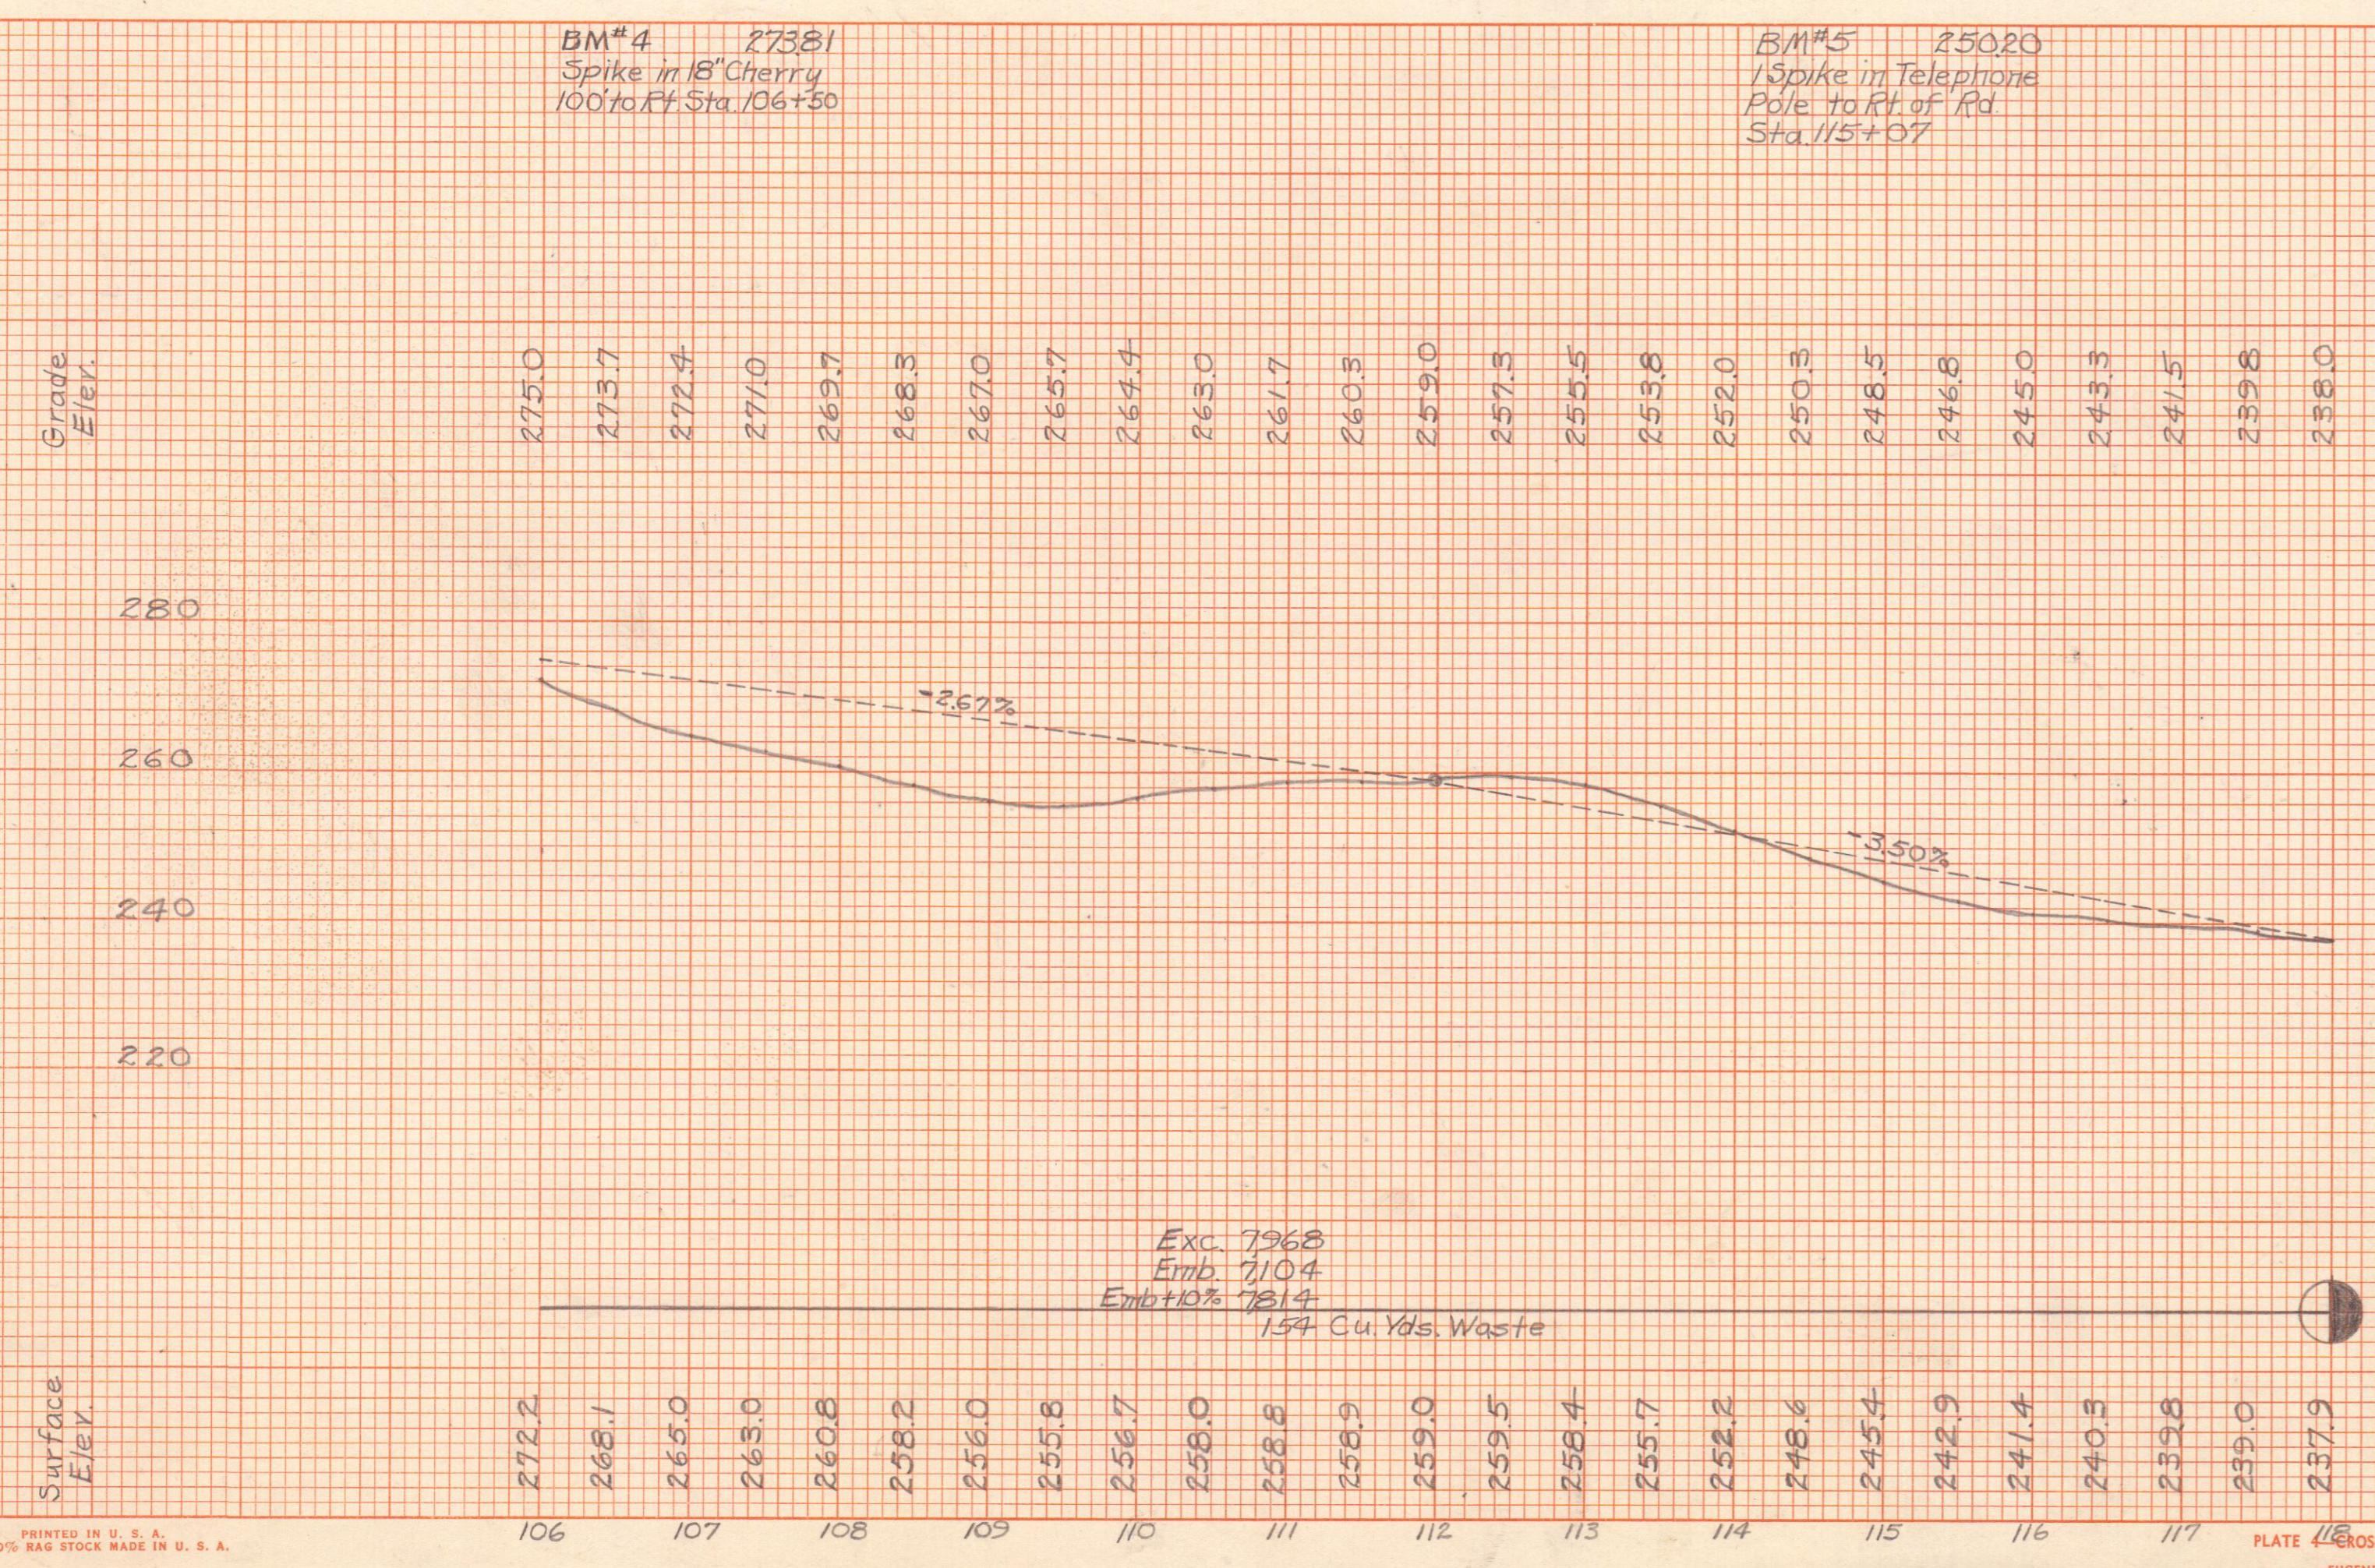

FINAL SURVEY NOTE BOOK NO. \_\_\_\_\_  
SURVEYED, PLOTTED, TEMPLATE, AREAS CHECKED

ORIGINAL SURVEY NOTE BOOK NO. \_\_\_\_\_  
SURVEYED, PLOTTED, TEMPLATE, AREAS CHECKED