


MUSKINGUM COUNTY
MUS-60-16.88
RIW PLANS 1'-20'

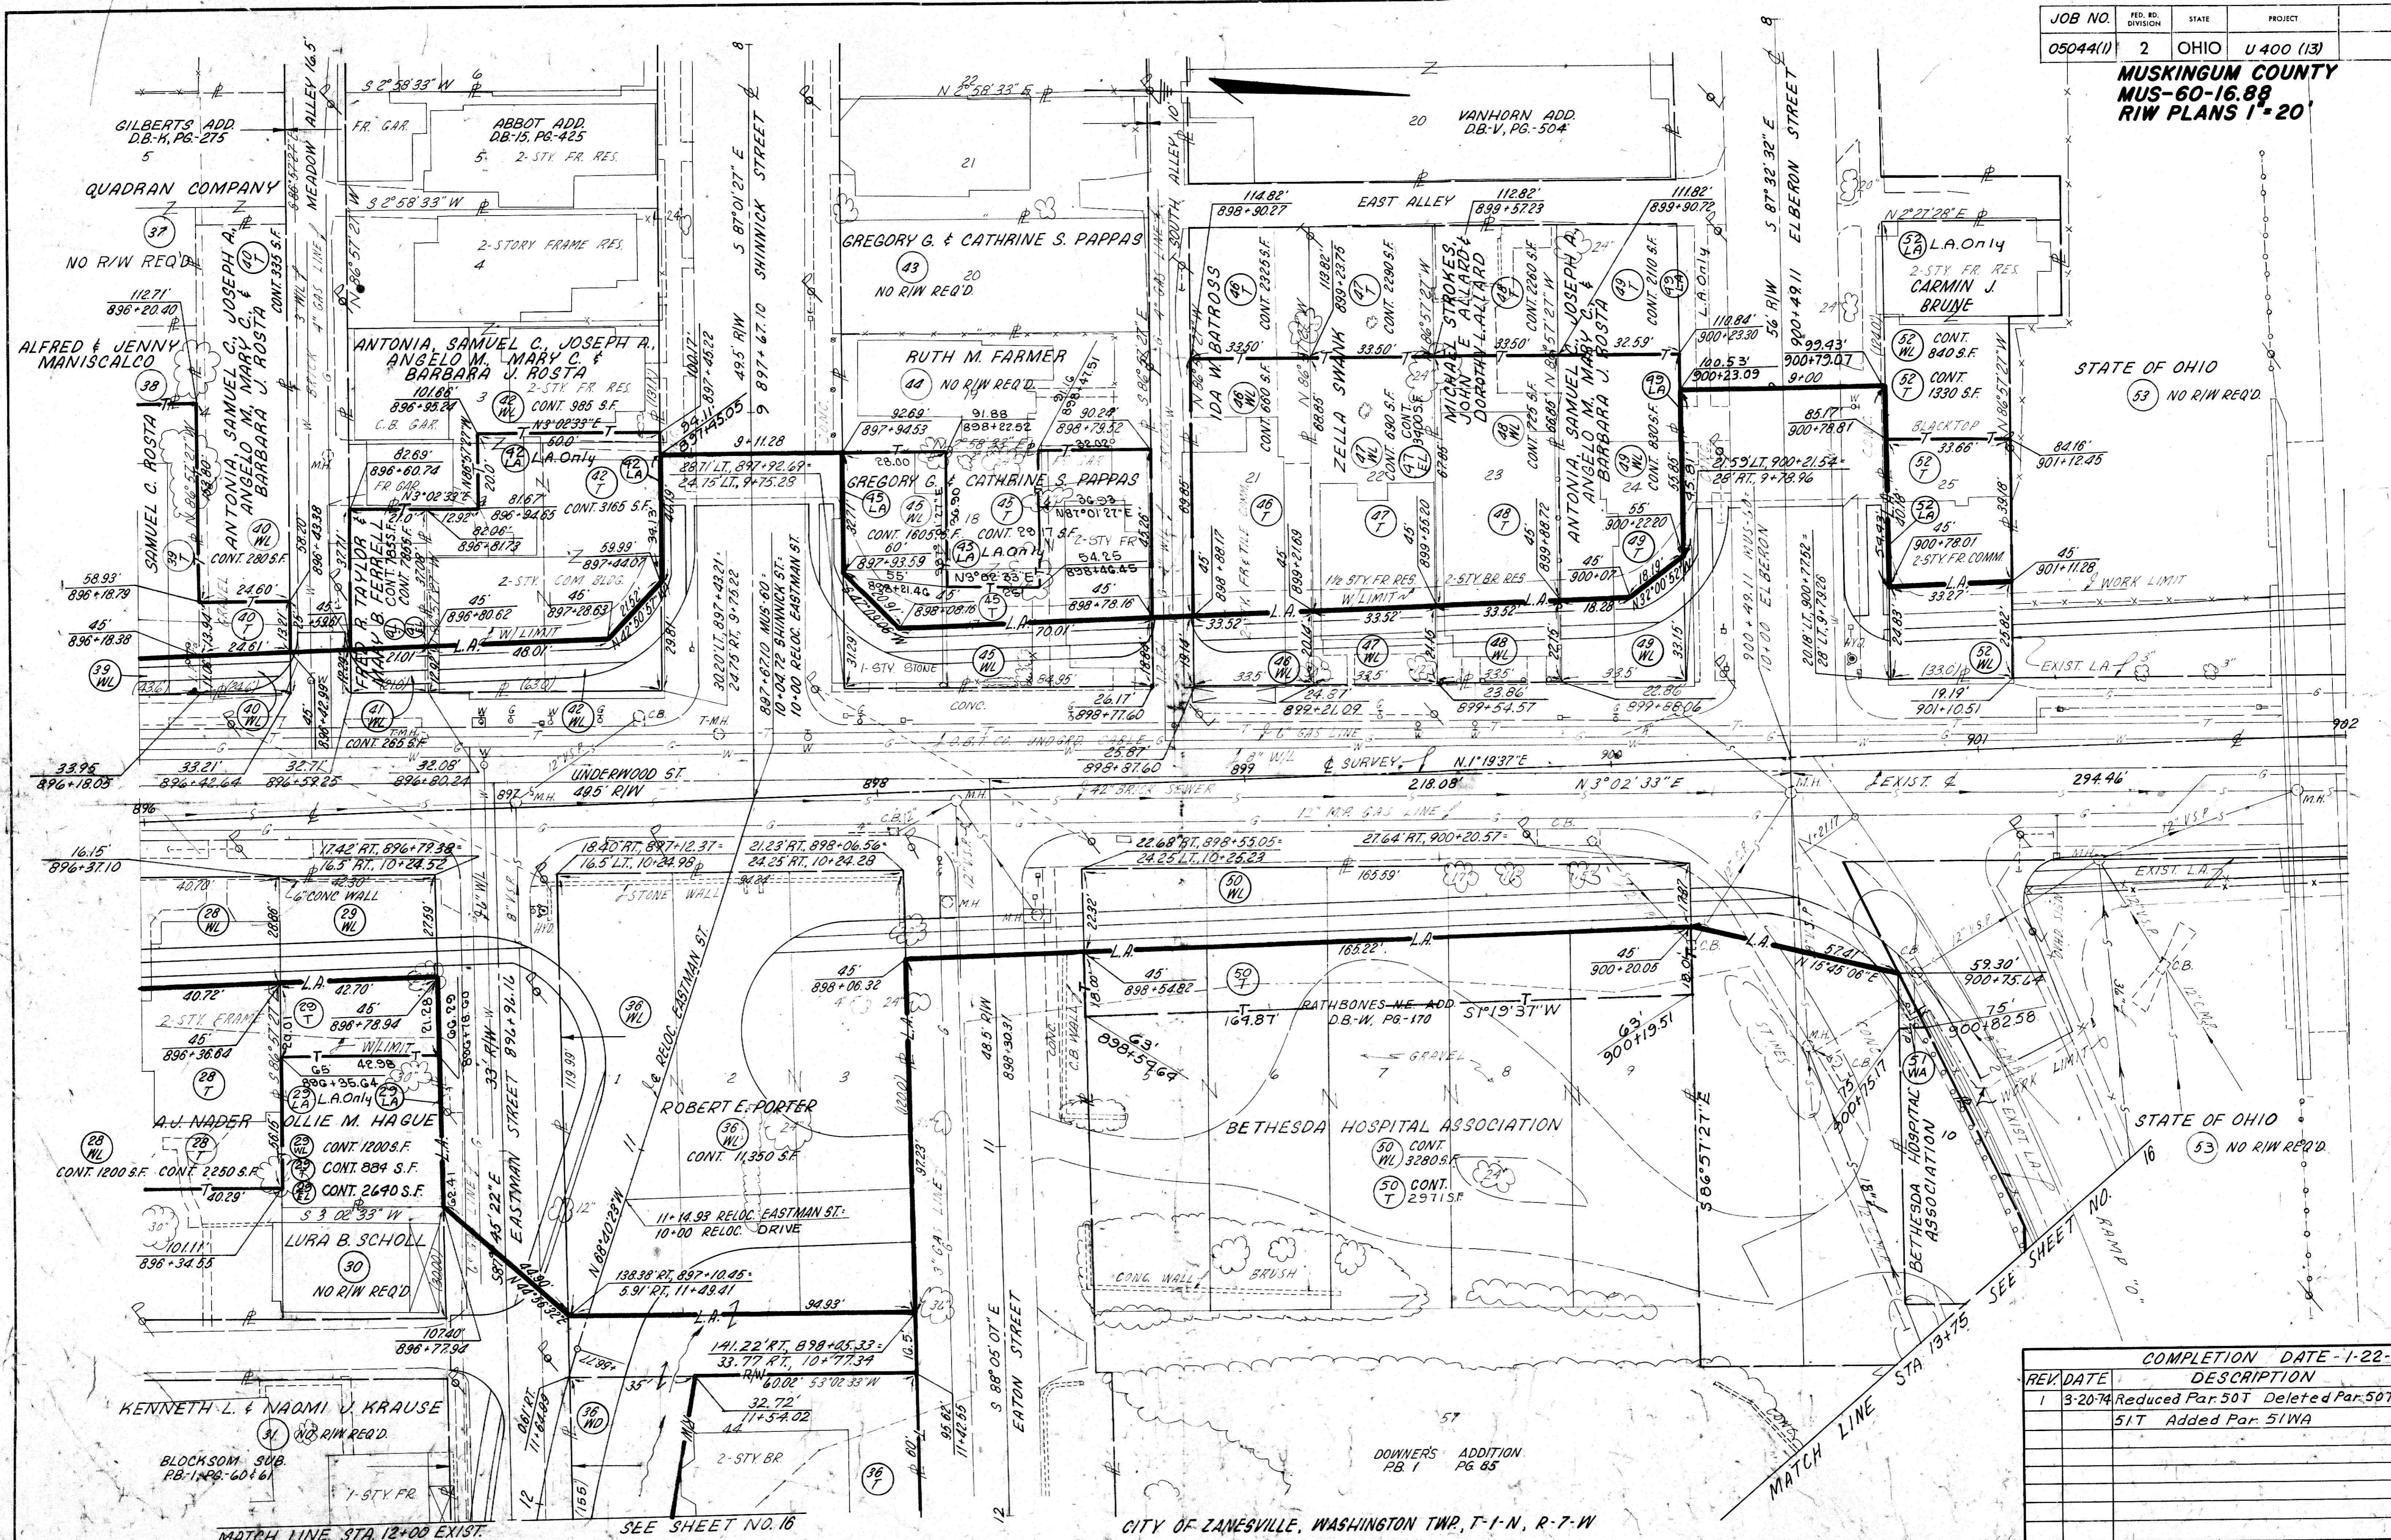

REV. DATE	DESCRIPTION	FUND
1 3-20-74	Reduced Par. 50T Deleted Par. 50T-1#	
	51T Added Par. 51WA	